


Application No. 71071 **PERMIT AMENDMENT MAP**
 Permit No. S54139

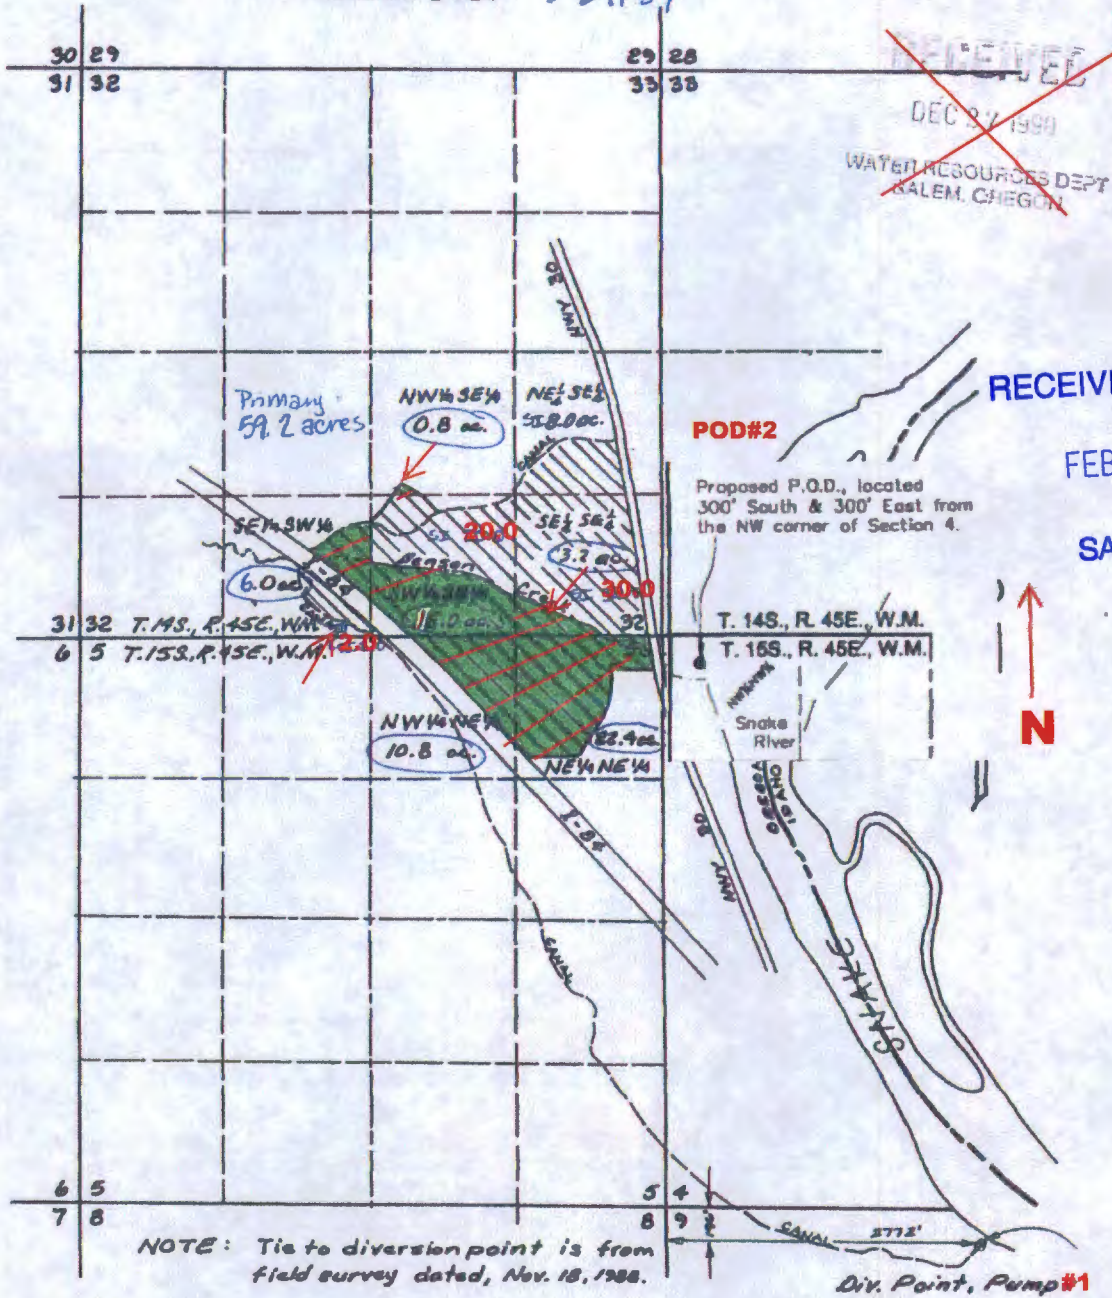

MAP TO ACCOMPANY
 APPLICATION FOR A PERMIT AMENDMENT
~~TO APPROPRIATE SURFACE WATER~~ S-54139

APPLICANT: LEWIS GAY

JULY 5, 1990

SCALE: 1" = 1 Mile

- Primary Irrigation [59.2 ac]
- Supplemental Irrigation [60.0 ac]



T 11982