

1" = 400'

RECEIVED

SEP 22 2014

WATER RESOURCES DEPT
SALEM, OREGON

- | | |
|---------------------|---|
| GREEN: | Rail Pump: 2160 feet west and 1997 feet south from the NE corner of Section 13 |
| LIGHT BLUE: | Beach Pump: 1151 feet west and 2353 feet south from the NE corner of Section 13 |
| DARK BLUE: | Proposed N. Grandpa's POD: 1100 feet east and 91 feet north from the SW corner of Section 7 |
| HOT PINK: | Corner Well: 1131 feet west and 168 feet south from the NE corner of Section 13 |
| YELLOW: | Driveway Well: 1167 feet west and 970 feet north from the SE corner of Section 12 |
| TRANSPARENT PINK: | GR 2727 where we are requesting supplemental irrigation |
| TRANSPARENT ORANGE: | GR 2732 where we are requesting supplemental irrigation |
| TRANSPARENT WHITE: | CERT 46117 where we are requesting supplemental irrigation |



1" = 400'

RECEIVED

SEP 22 2014




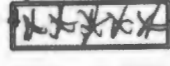

WATER RESOURCES DEPT
SALEM, OREGON

- | | |
|---------------------|---|
| GREEN: | Rail Pump: 2160 feet west and 1997 feet south from the NE corner of Section 13 |
| LIGHT BLUE: | Beach Pump: 1151 feet west and 2353 feet south from the NE corner of Section 13 |
| DARK BLUE: | Proposed N. Grandpa's POD: 1100 feet east and 91 feet north from the SW corner of Section 7 |
| HOT PINK: | Corner Well: 1131 feet west and 168 feet south from the NE corner of Section 13 |
| YELLOW: | Driveway Well: 1167 feet west and 970 feet north from the SE corner of Section 12 |
| TRANSPARENT PINK: | GR 2727 where we are requesting supplemental irrigation |
| TRANSPARENT ORANGE: | GR 2732 where we are requesting supplemental irrigation |
| TRANSPARENT WHITE: | CERT 46117 where we are requesting supplemental irrigation |

0226t 07-5



1" = 740'
 Areas outlined in orange

-  Rail Pump: 2160 feet west and 1997 feet south from the NE corner of Section 13
-  Beach Pump: 1151 feet west and 2353 feet south from the NE corner of Section 13
-  Proposed N. Grandpa's POD: 1100 feet east and 91 feet north from the SW corner of Section 7
-  Corner Well: 1131 feet west and 168 feet south from the NE corner of Section 13
-  Driveway Well: 1167 feet west and 970 feet north from the SE corner of Section 12

SALEM, OR

JUL 31 2014

RECEIVED BY OWRD

665785

RECEIVED BY OWRD

RECEIVED BY OWRD

JUN 30 2014

JUL 31 2014


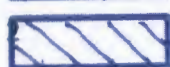

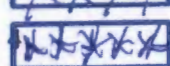
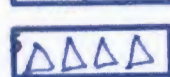
SALEM OR



Pre 1999



1" = 740'
 Areas outlined in orange

-  Rail Pump: 2160 feet west and 1997 feet south from the NE corner of Section 13
-  Beach Pump: 1151 feet west and 2353 feet south from the NE corner of Section 13
-  Proposed N. Grandpa's POD: 1100 feet east and 91 feet north from the SW corner of Section 7
-  Corner Well: 1131 feet west and 168 feet south from the NE corner of Section 13
-  Driveway Well: 1167 feet west and 970 feet north from the SE corner of Section 12

SALEM, OR

JUL 31 2014

RECEIVED BY OWRD




1" = 400'

RECEIVED

SEP 22 2014

WATER RESOURCES DEPT
SALEM, OREGON

- | | |
|---------------------|---|
| GREEN: | Rail Pump: 2160 feet west and 1997 feet south from the NE corner of Section 13 |
| LIGHT BLUE: | Beach Pump: 1151 feet west and 2353 feet south from the NE corner of Section 13 |
| DARK BLUE: | Proposed N. Grandpa's POD: 1100 feet east and 91 feet north from the SW corner of Section 7 |
| HOT PINK: | Corner Well: 1131 feet west and 168 feet south from the NE corner of Section 13 |
| YELLOW: | Driveway Well: 1167 feet west and 970 feet north from the SE corner of Section 12 |
| TRANSPARENT PINK: | GR 2727 where we are requesting supplemental irrigation |
| TRANSPARENT ORANGE: | GR 2732 where we are requesting supplemental irrigation |
| TRANSPARENT WHITE: | CERT 46117 where we are requesting supplemental irrigation |

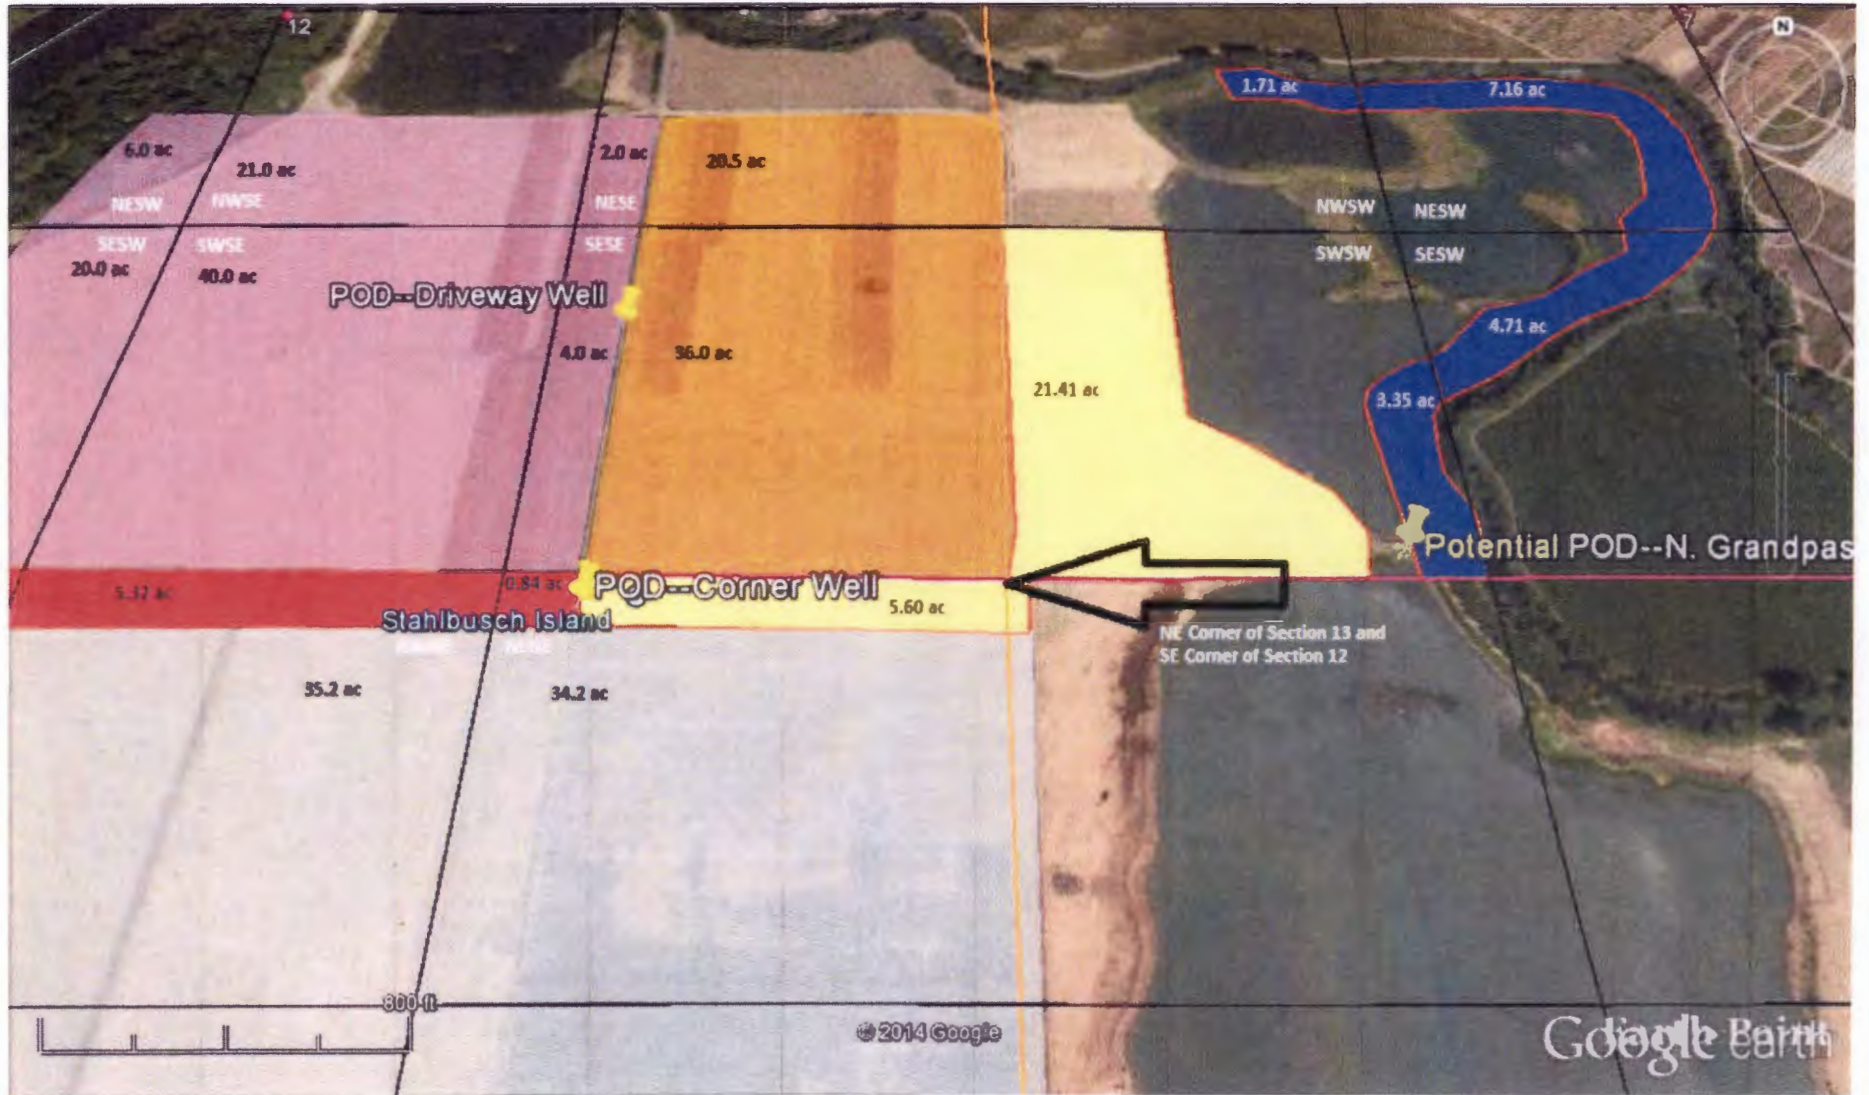

1" = 400'

RECEIVED

SEP 22 2014

WATER RESOURCES DEPT
SALEM, OREGON

- | | |
|---------------------|---|
| GREEN: | Rail Pump: 2160 feet west and 1997 feet south from the NE corner of Section 13 |
| LIGHT BLUE: | Beach Pump: 1151 feet west and 2353 feet south from the NE corner of Section 13 |
| DARK BLUE: | Proposed N. Grandpa's POD: 1100 feet east and 91 feet north from the SW corner of Section 7 |
| HOT PINK: | Corner Well: 1131 feet west and 168 feet south from the NE corner of Section 13 |
| YELLOW: | Driveway Well: 1167 feet west and 970 feet north from the SE corner of Section 12 |
| TRANSPARENT PINK: | GR 2727 where we are requesting supplemental irrigation |
| TRANSPARENT ORANGE: | GR 2732 where we are requesting supplemental irrigation |
| TRANSPARENT WHITE: | CERT 46117 where we are requesting supplemental irrigation |

688285

RECEIVED BY OWRD

RECEIVED BY OWRD

JUN 30 2014

JUL 31 2014

SALEM OR

