

T.26S. R.7W. W.M.

Section 13

Douglas County

Scale 1" = 500'


Application/Permit Map

Steven and Linda Bettencourt

RECEIVED BY OWRD

APR 29 2015

SALEM, OR

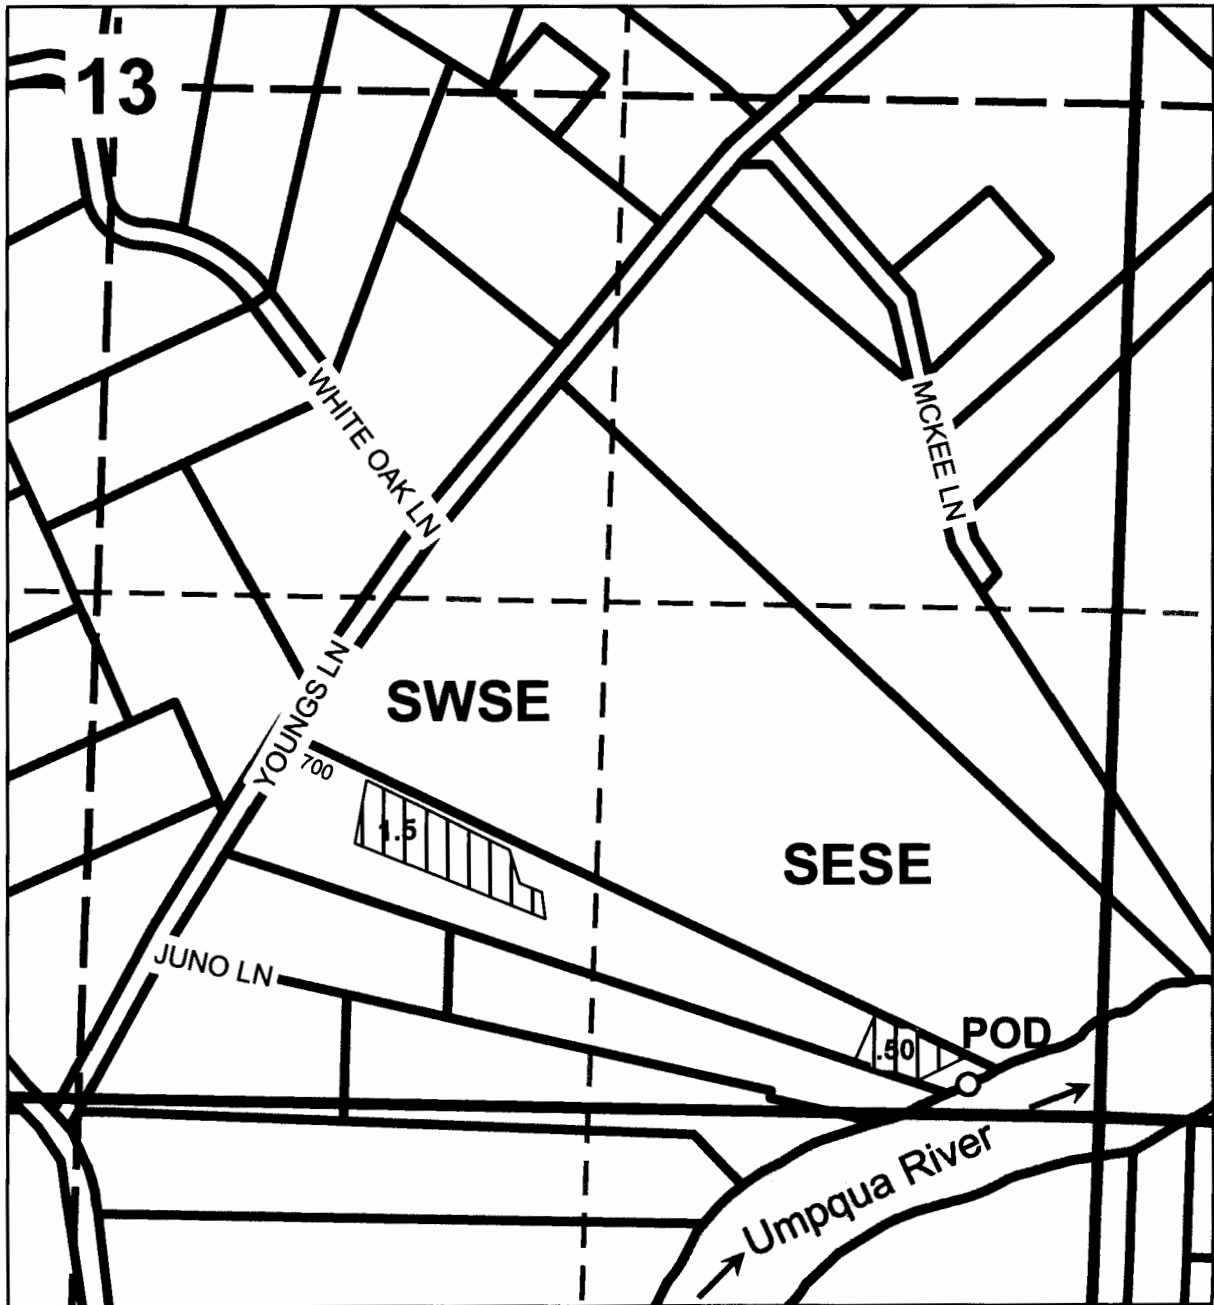

Point of Diversion is 80 ft. North and 340 ft. West from the Southeast corner of Section 13