



PERMIT AMENDMENT MAP
 Permit S-54707 (Application S-87531)
 Section 20, T3S, R1W, W.M., Clackamas County
 Morningstar 2006, LLC

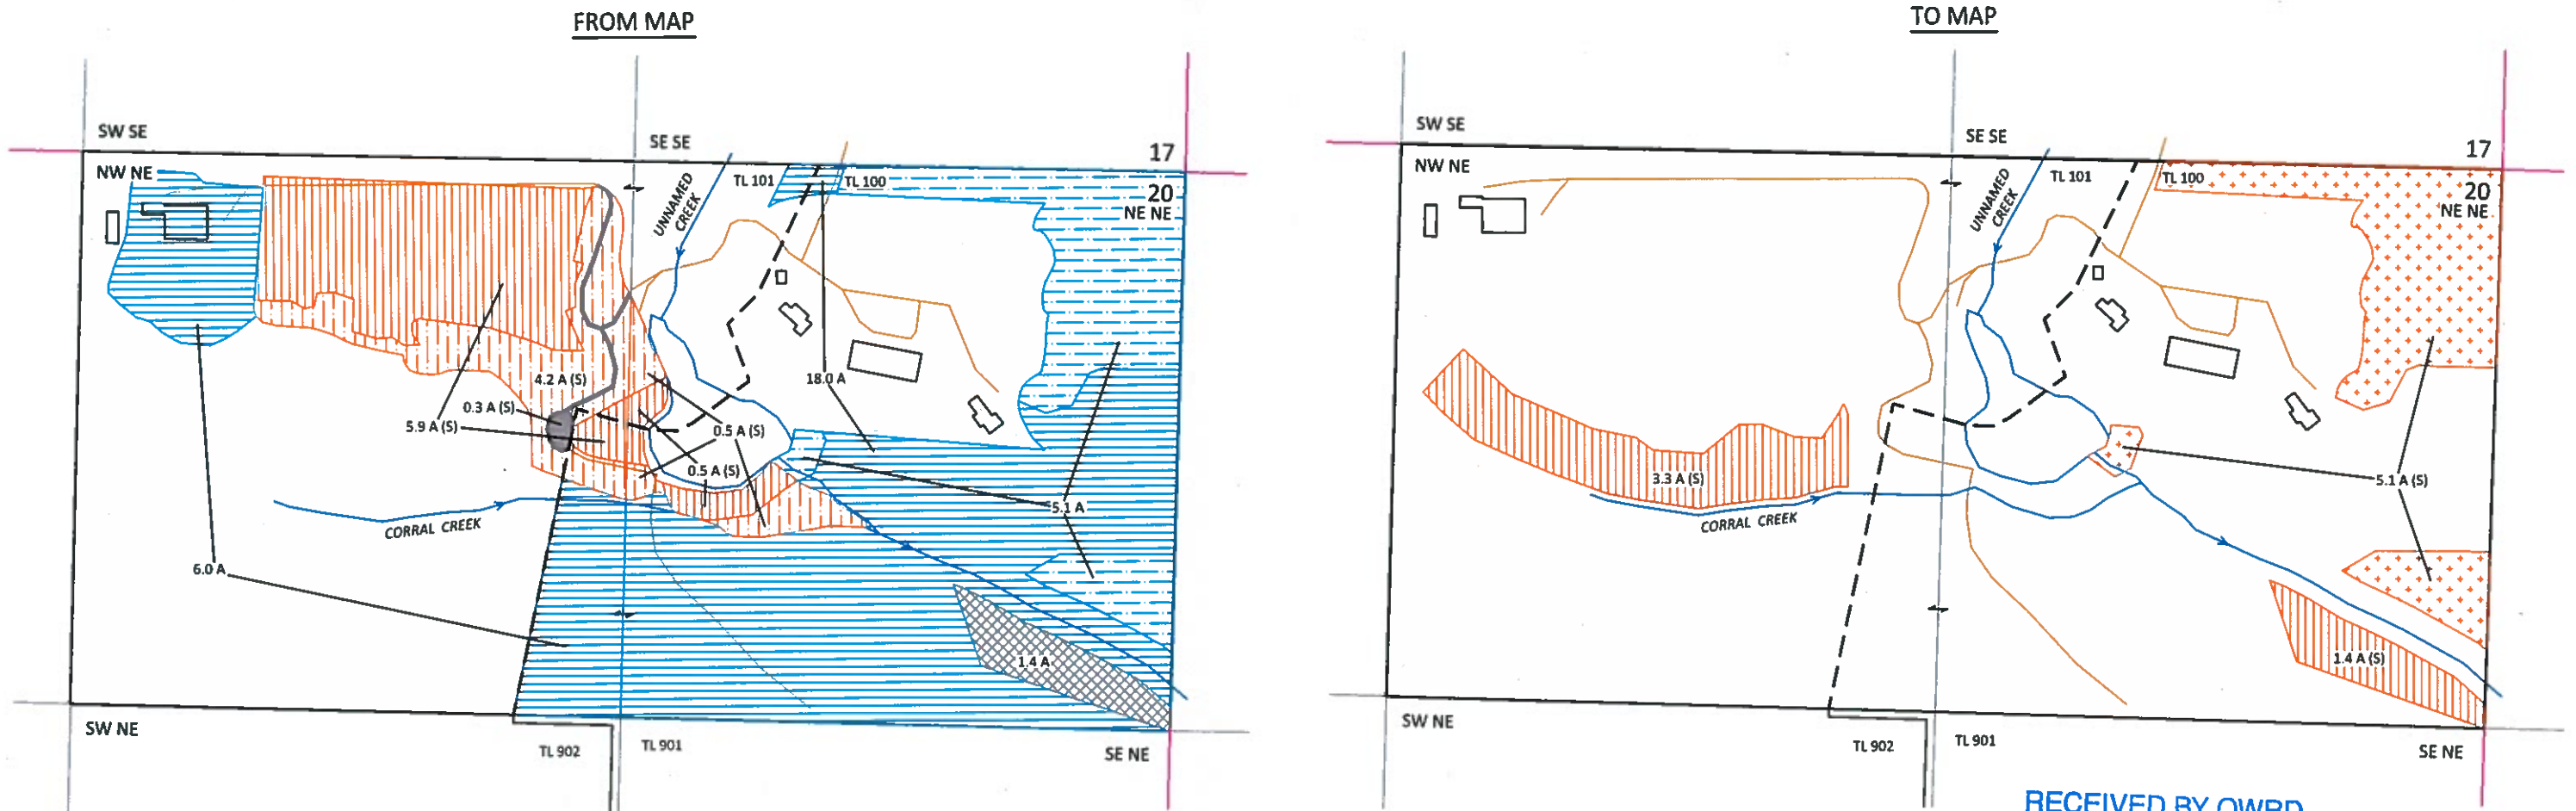



RECEIVED BY OWRD

MAR 02 2015

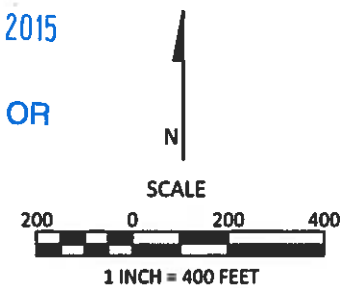SALEM, OR



REMAINING RIGHTS


-  PERMIT S-54707 (APPLICATION S-87531) (24.0 A) IRRIGATION PRIORITY: 9/23/2009
-  PERMIT S-54707 (APPLICATION S-87531) (6.7 A) SUPPLEMENTAL IRRIGATION PRIORITY: 9/23/2009

EXPLANATION


FROM LANDS

-  PERMIT S-54707 (APPLICATION S-87531) (5.1 A) IRRIGATION PRIORITY: 9/23/2009
-  PERMIT S-54707 (APPLICATION S-87531) (4.7 A) SUPPLEMENTAL IRRIGATION PRIORITY: 9/23/2009


TO LANDS

-  PERMIT S-54707 (APPLICATION S-87531) (4.7 A) SUPPLEMENTAL IRRIGATION PRIORITY: 9/23/2009


DIMINISHED PRIMARY IRRIGATION

-  PERMIT S-54707 (APPLICATION S-87531) (5.1 A) BECOMES SUPPLEMENTAL IRRIGATION PRIORITY: 9/23/2009

CANCELED PRIMARY IRRIGATION

-  PERMIT S-54707 (APPLICATION S-87531) (1.4 A) IRRIGATION PRIORITY: 9/23/2009

CANCELED SUPPLEMENTAL IRRIGATION

-  PERMIT S-54707 (APPLICATION S-87531) (0.3 A) SUPPLEMENTAL IRRIGATION PRIORITY: 9/23/2009

-  TAXLOT BOUNDARY
-  (S) DENOTES SUPPLEMENTAL ACRES

January 5, 2015

This map is not intended to provide legal dimensions or locations of property ownership lines


FIGURE 1







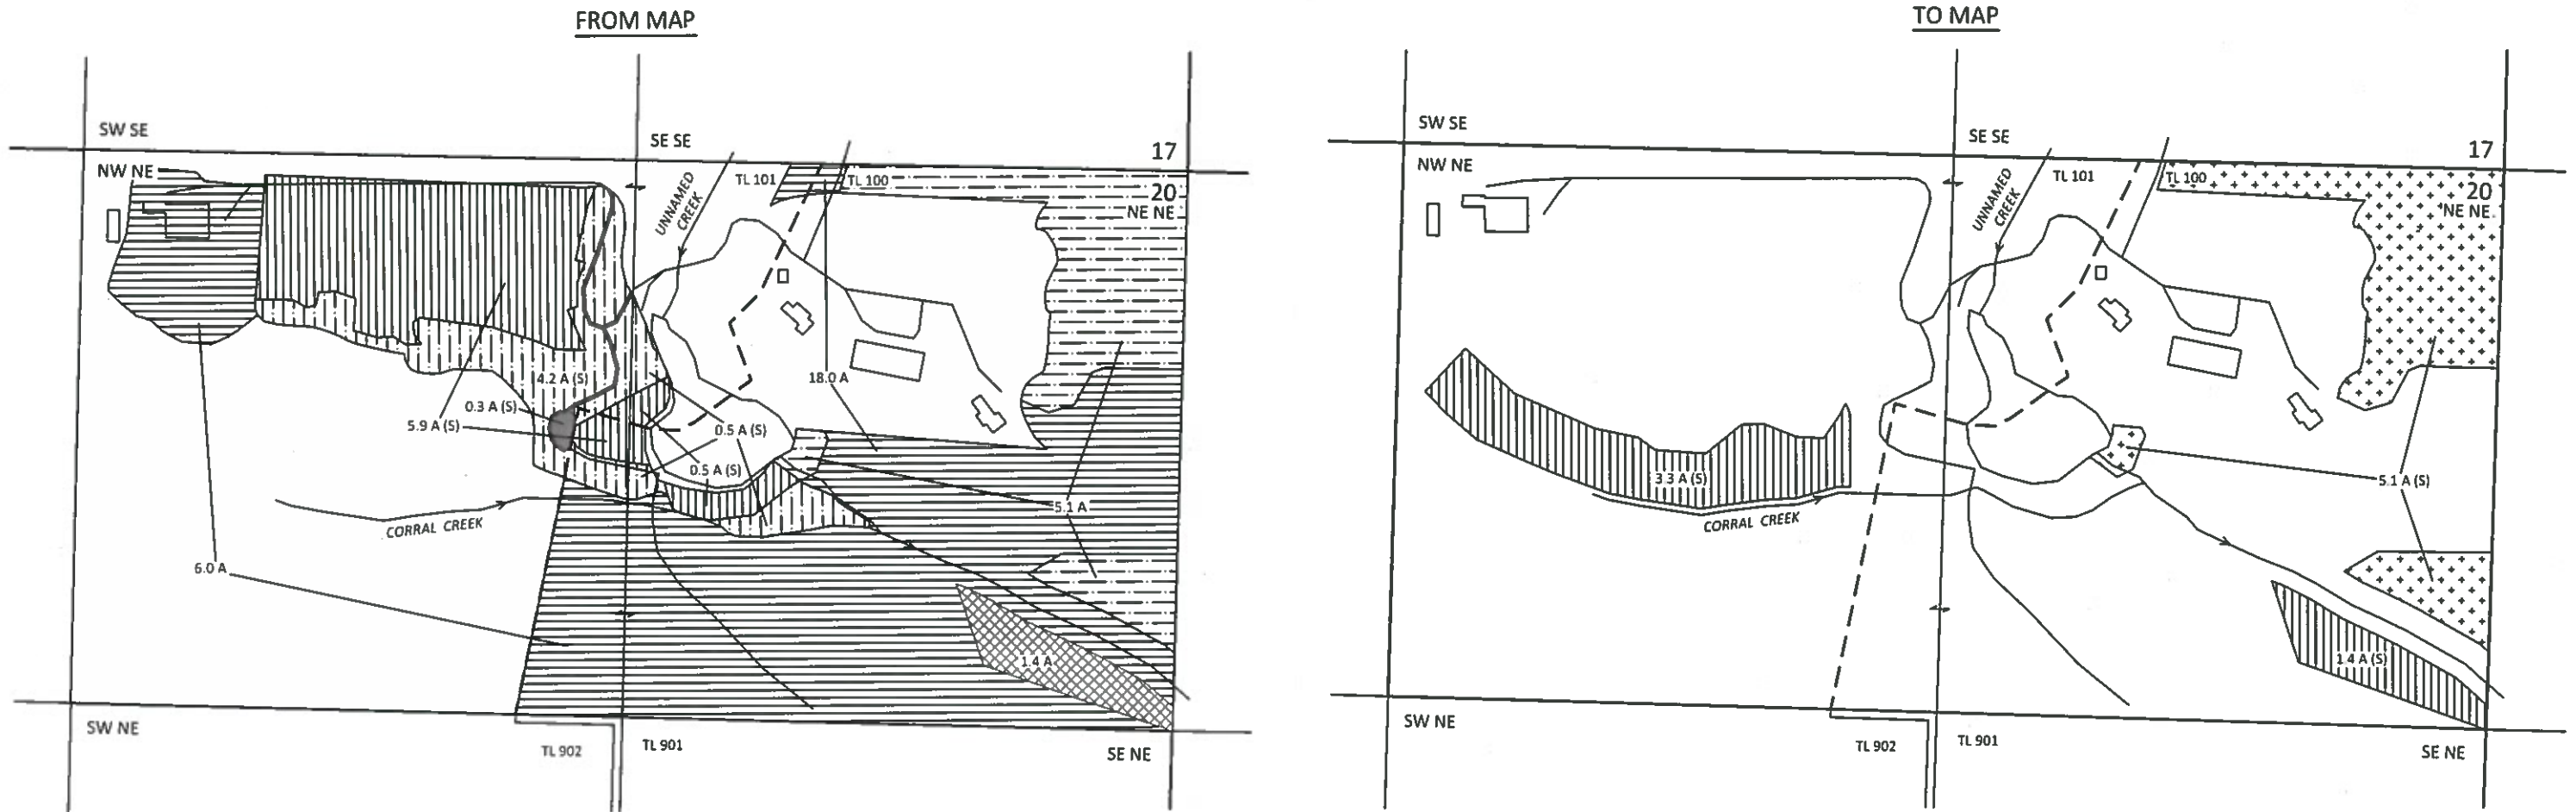


SKOOKUM
 WATER ASSOCIATES INC

P.O. BOX 80174
 PORTLAND, OR 97280
 (503) 319-8926


T 11997

PERMIT AMENDMENT MAP
 Permit S-54707 (Application S-87531)
 Section 20, T3S, R1W, W.M., Clackamas County
 Morningstar 2006, LLC

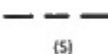

REMAINING RIGHTS		EXPLANATION		DIMINISHED PRIMARY IRRIGATION	
	PERMIT S-54707 (APPLICATION S-87531) (24.0 A) IRRIGATION PRIORITY: 9/23/2009		PERMIT S-54707 (APPLICATION S-87531) (5.1 A) IRRIGATION PRIORITY: 9/23/2009		PERMIT S-54707 (APPLICATION S-87531) (5.1 A) BECOMES SUPPLEMENTAL IRRIGATION PRIORITY: 9/23/2009
	PERMIT S-54707 (APPLICATION S-87531) (6.7 A) SUPPLEMENTAL IRRIGATION PRIORITY: 9/23/2009		PERMIT S-54707 (APPLICATION S-87531) (4.7 A) SUPPLEMENTAL IRRIGATION PRIORITY: 9/23/2009		PERMIT S-54707 (APPLICATION S-87531) (1.4 A) IRRIGATION PRIORITY: 9/23/2009
		TO LANDS			PERMIT S-54707 (APPLICATION S-87531) (0.3 A) SUPPLEMENTAL IRRIGATION PRIORITY: 9/23/2009
					TAXLOT BOUNDARY
				(S)	DENOTES SUPPLEMENTAL ACRES

RECEIVED BY OWRD
 MAR 02 2015
 SALEM, OR

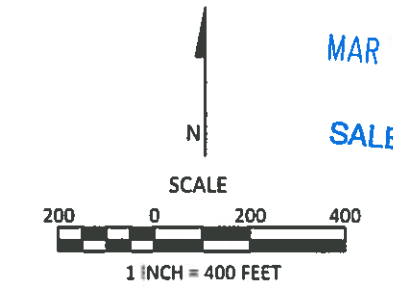

January 5, 2015

This map is not intended to provide legal dimensions or locations of property ownership lines

FIGURE 1

SKOOKUM
 WATER ASSOCIATES INC
 P.O. BOX 80174
 PORTLAND, OR 97280
 (503) 319-8926

T 11997