
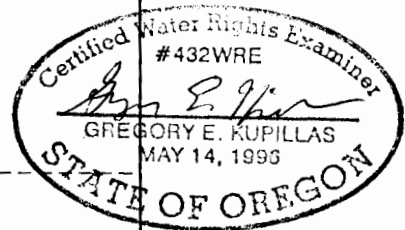



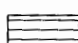


T.4S. R.1E Section 31, W.M.

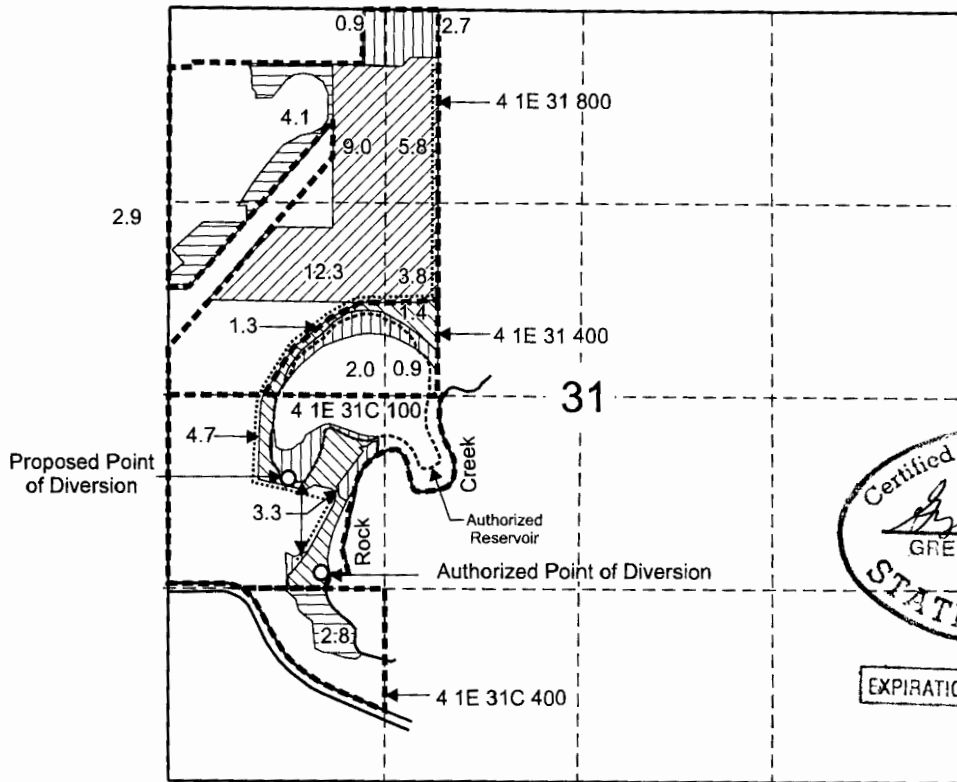


EXPIRATION DATE: 6/30/2015

Authorized Point of Diversion is located 1,220 feet south and 1,050 feet east from the west 1/4 corner, Section 31.

Proposed Point of Diversion is located 570 feet south and 830 feet east from the west 1/4 corner, Section 31.

-  "From" area (9.8 Acres) irrigated under Application S-80803, Permit S-52692
-  "To" area (9.8 Acres) for irrigation use ("To" areas in Lot 800 to be assigned to Warren Bean. "To" areas in Lot 400 to be retained by Joel Neuschwander)
-  Remaining area (7.4 Acres) irrigated under Application S-80803, Permit S-52692, retained by Joel Neuschwander.
-  Remaining area (30.9 Acres) irrigated under Application S-80803, Permit S-52692, assigned to Warren Bean.
- Tax lot boundary
- Irrigation mainline

Scale: 1" = 1,320'

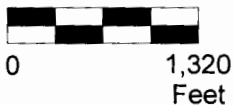

RECEIVED

NOV 25 2014

WATER RESOURCES DEPT
STATE OF OREGON

This map was prepared for the purpose of identifying the location of a water right only and is not intended to provide legal dimensions or location of property ownership lines.



Pacific Hydro-Geology Inc.

Permit Amendment Application Map
Application S-80803, Permit S-52692

Joel Neuschwander and Warren Bean
T.4S. R.1E. Section 31, W.M.

2014-bgp

Neuschwander_Bean.cdr