

RECEIVED BY OWRD

MAR 02 2016

1" = 1320'


Tax Lot: 100 & 400

SALEM, OR



7 South, 5 West

7 South, 4 West

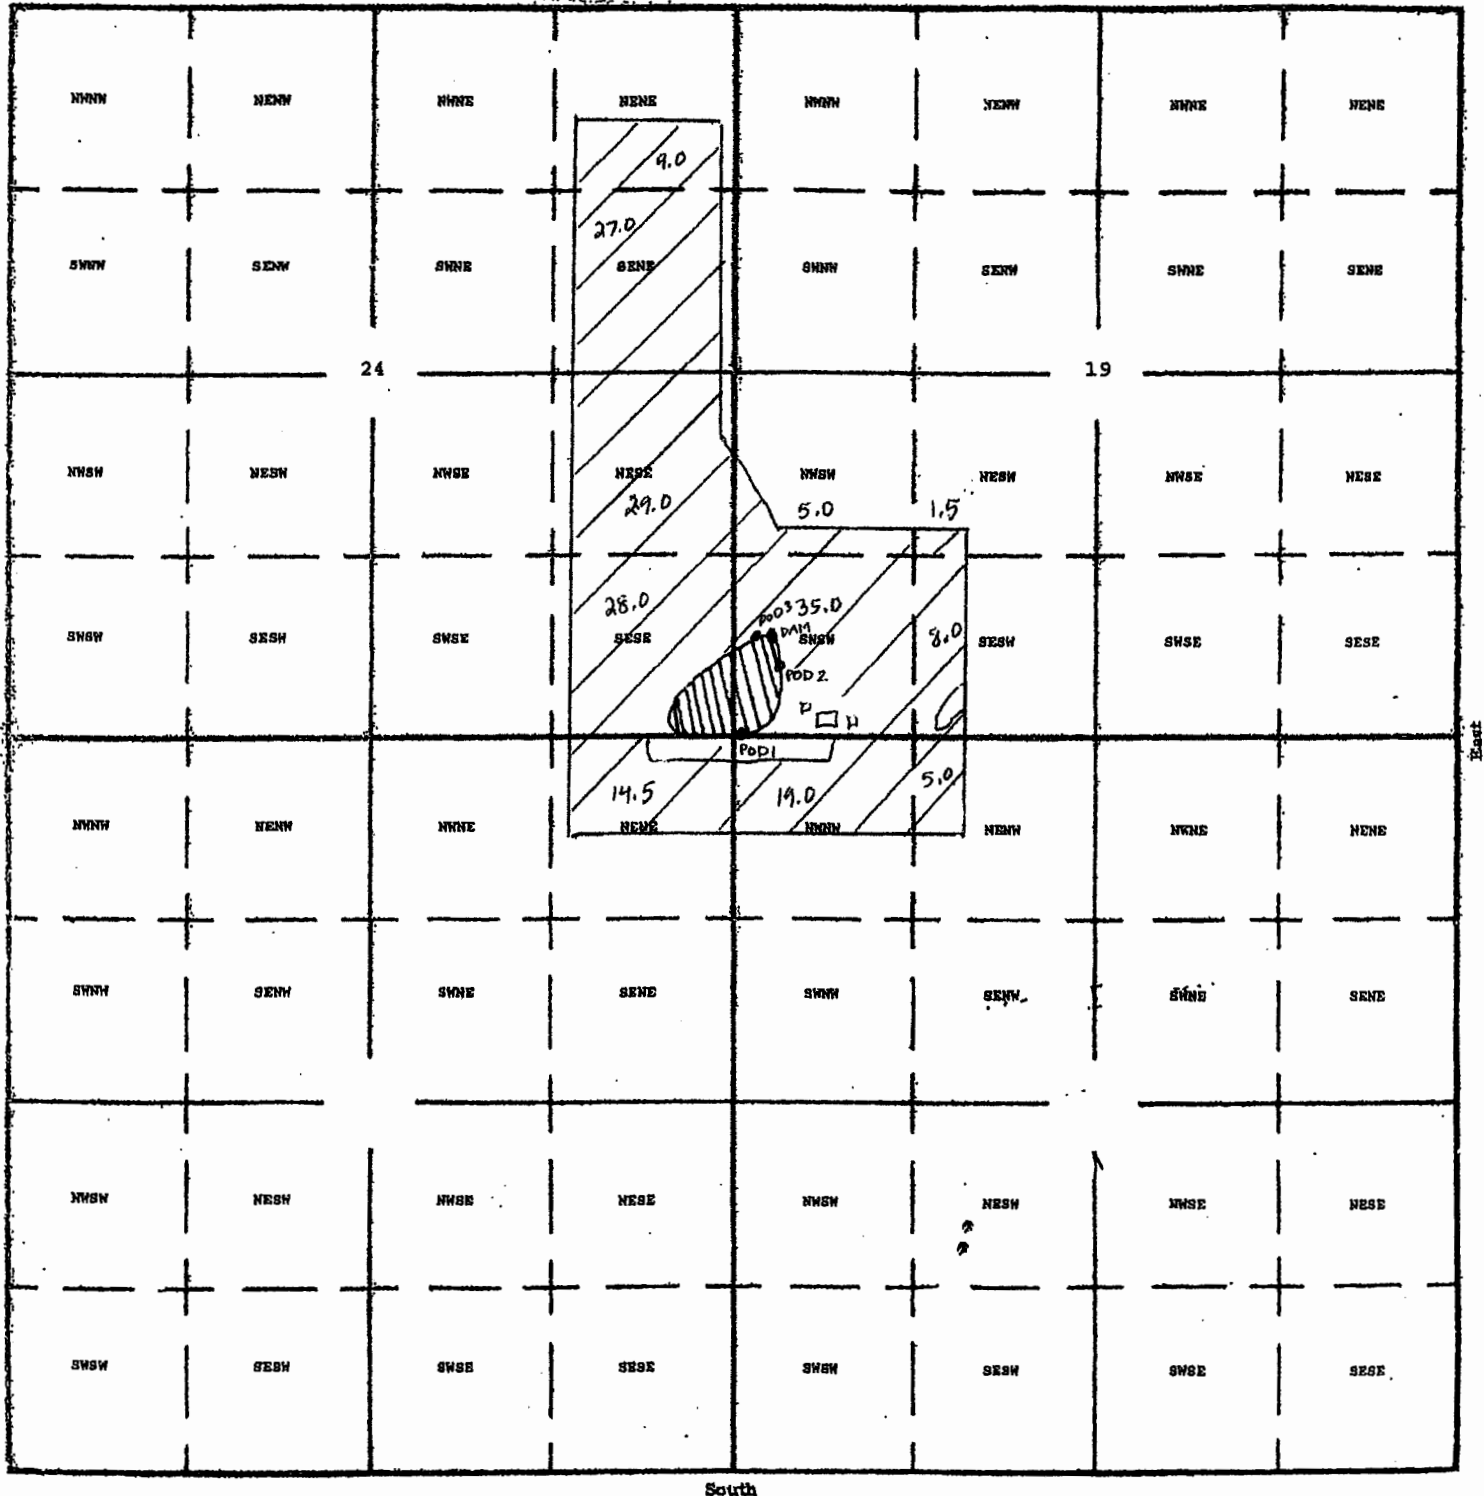

Dam Location: 700' North and 350' East from the SW corner of Section 19

POD 1: 25' North and 25' East from the SW corner of Section 19

POD 2: 500' North and 375' East from the SW corner of Section 19

POD 3: 670' North and 270' East from the SW corner of Section 19

P-00092