

T 16 S, R 4 W, Sec 14

1" = 400'

POD is 1670' S & 1290' W of NE cor

SEE MAP 16041200

11 12 Sec 14

55-03

LOT 13 37.95

200 17.36 AC

100 15.02 AC

LOT 14 35.78




RECEIVED BY OWRD

JUL 11 2016

SALEM, OH

- CANC
- 101
- 1800
- 2100
- 2200
- 2300
- 500
- 700
- 900
- 303

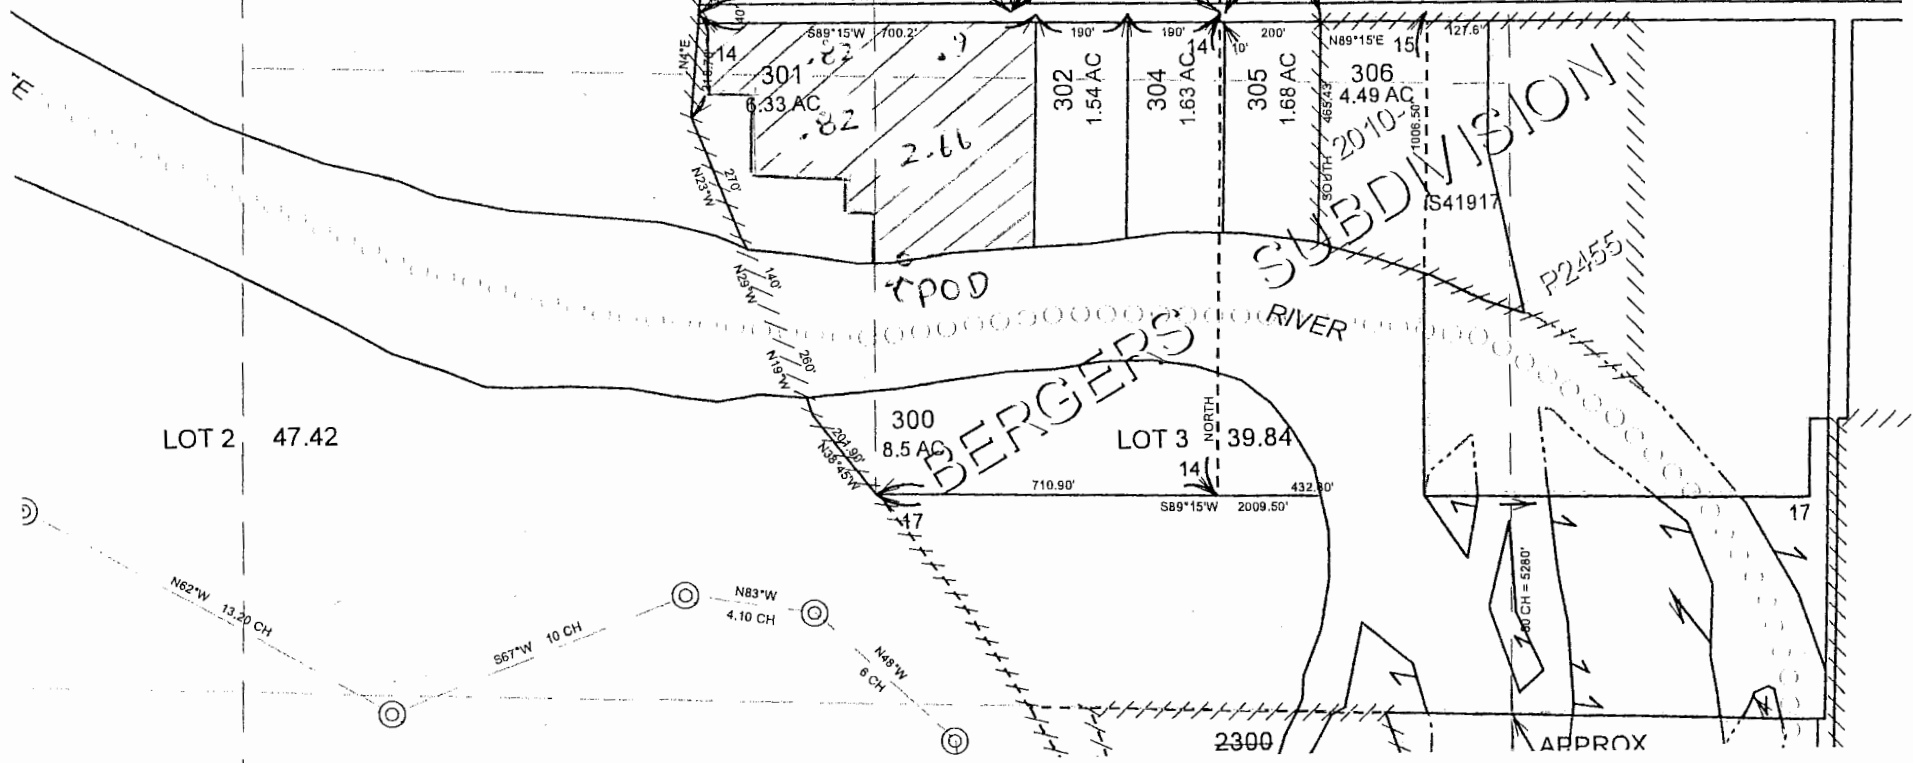

S-88259