



2017885

8s 5w 3

Areas with Cross hatch are Irrigation Areas

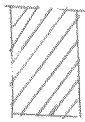

example

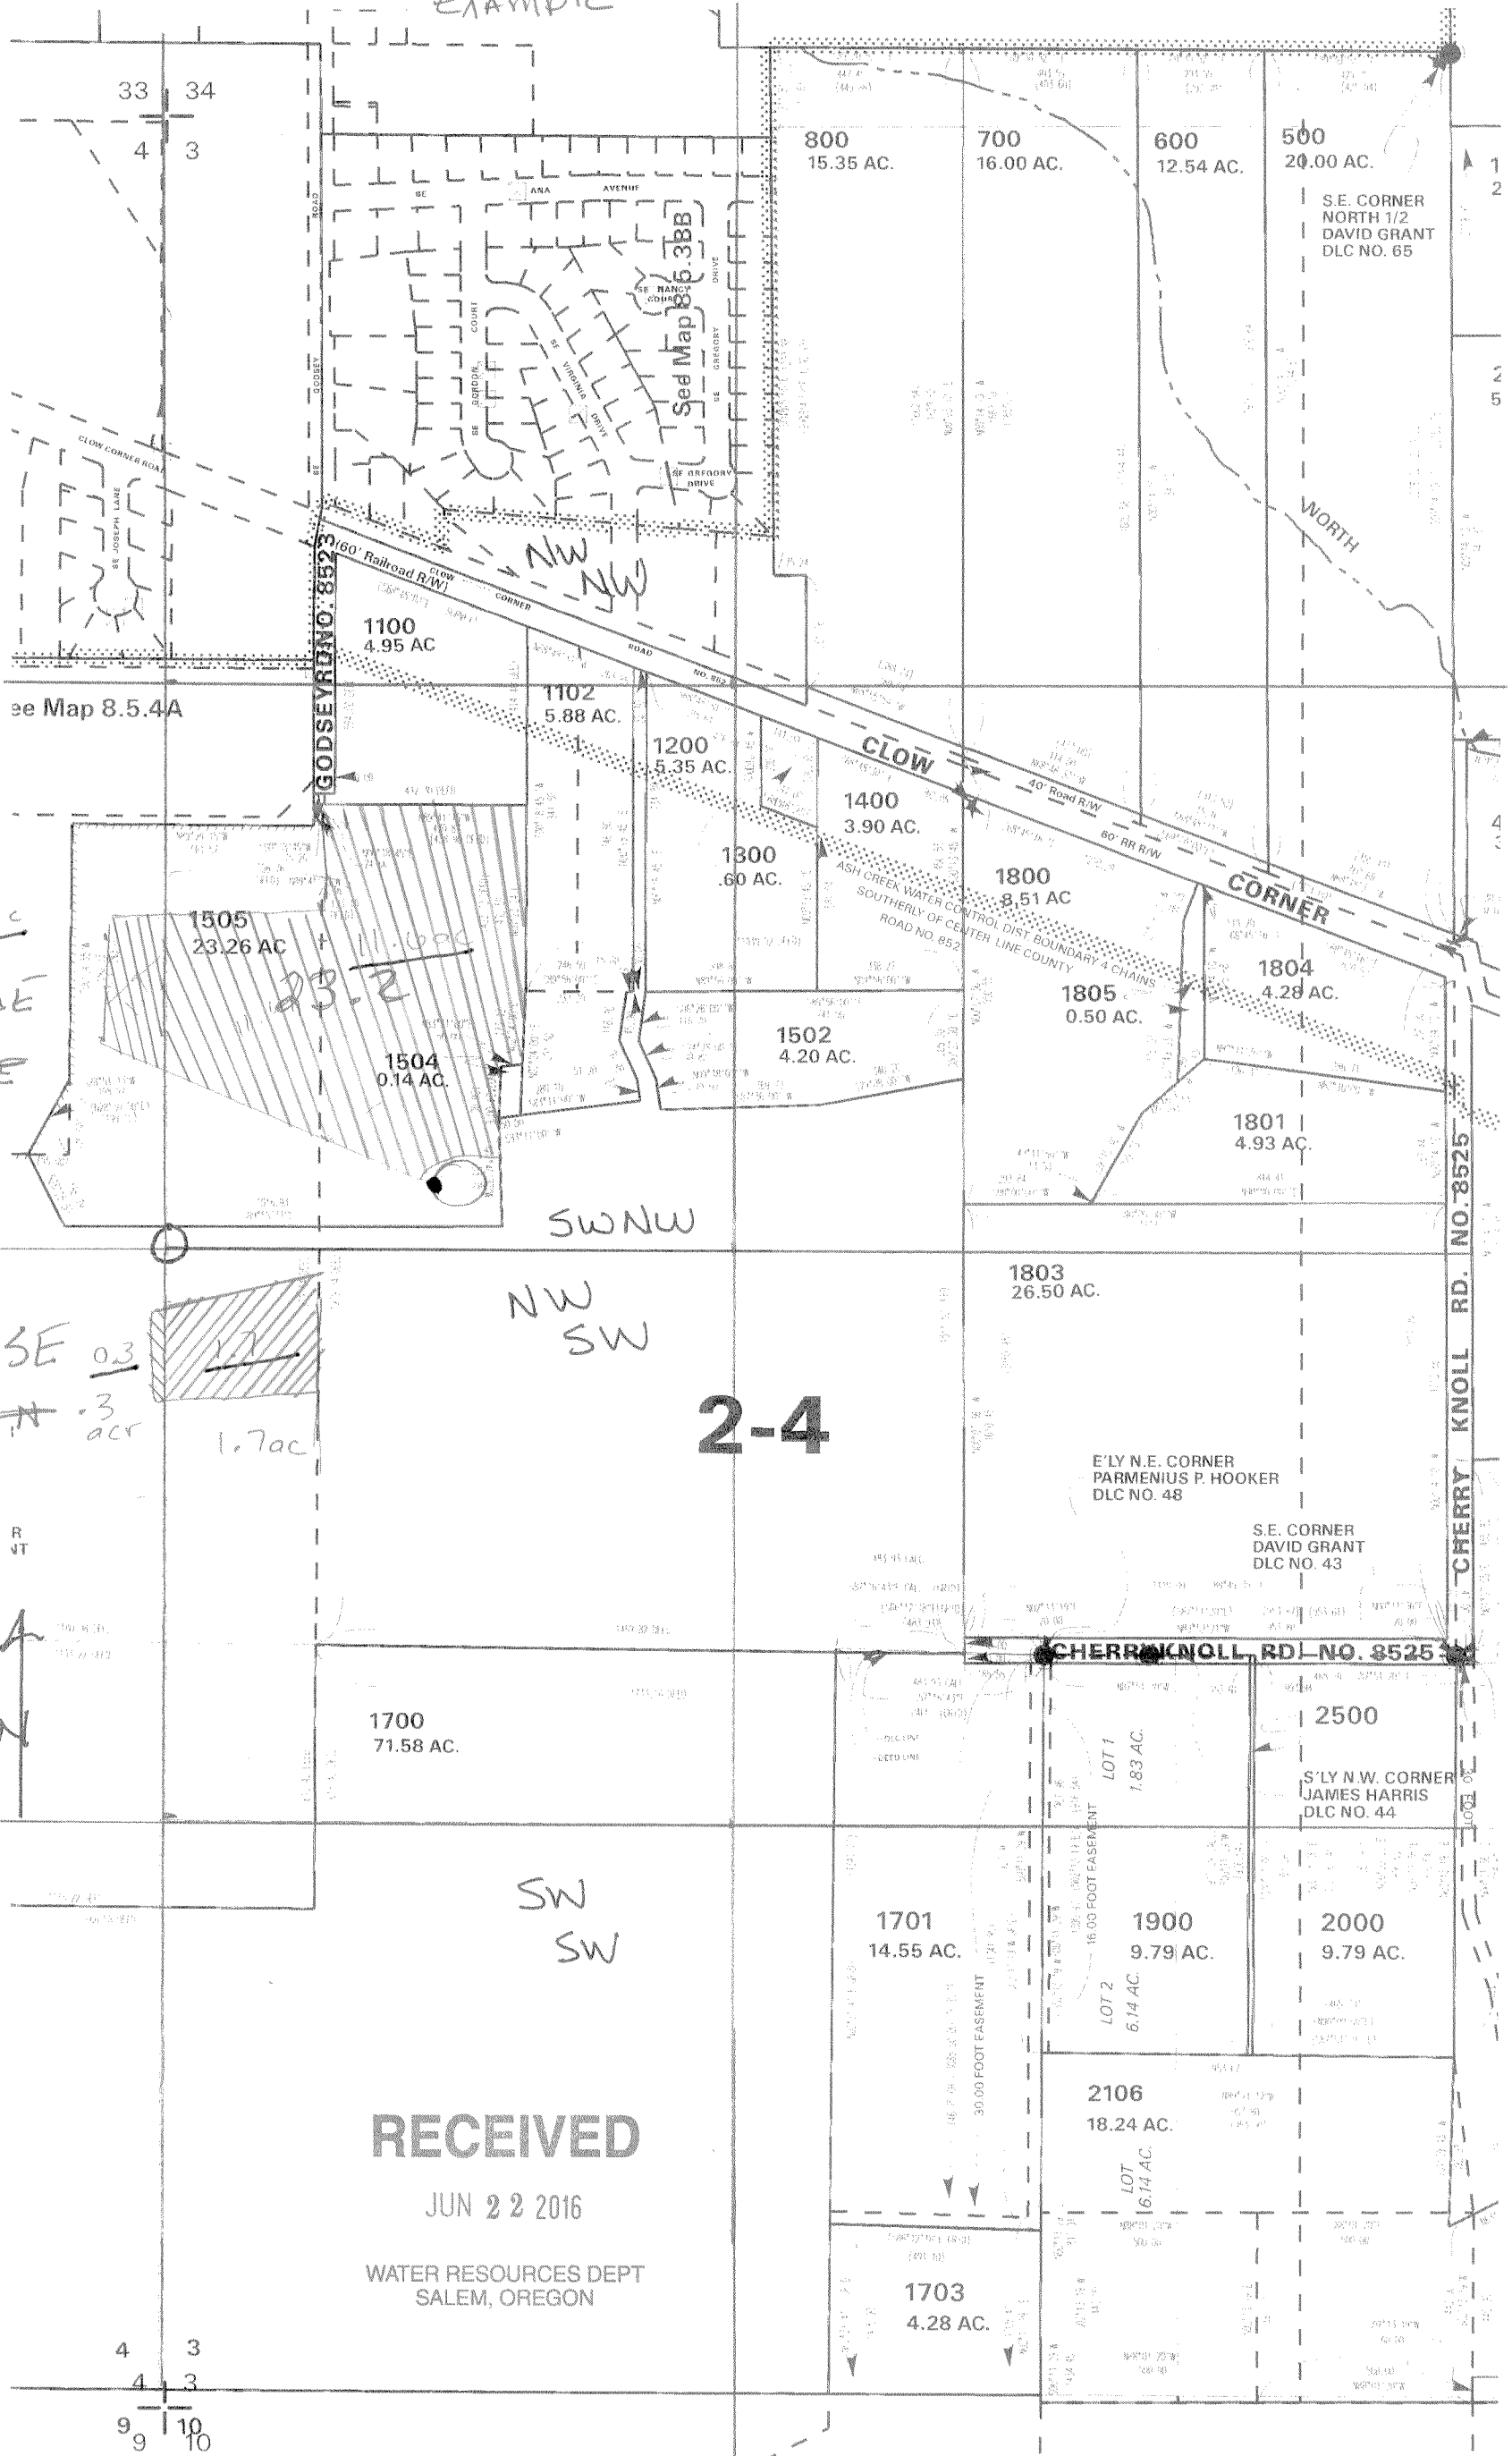

2-4

RECEIVED

JUN 22 2016

WATER RESOURCES DEPT SALEM, OREGON

680' east 160' north of the West 1/4 corner of section 3

1" = 400'