



ASSESSMENT & TAX  
CARTOGRAPHY

SECTION 12 T.38. R.3W. W.M.  
YAMHILL COUNTY OREGON

1"=1320




on behalf of Flying  
Feather Orchards, Inc.  
January 12, 2017

CANCELLED TABLETS:  
2191  
2192  
2193  
2194

DATE PRINTED: 4/29/2016

This platfile is for Assessment and Section 50471 purposes only and has not been prepared or its contents for legal, engineering, surveying or other purposes other than Assessment and Section 50471.

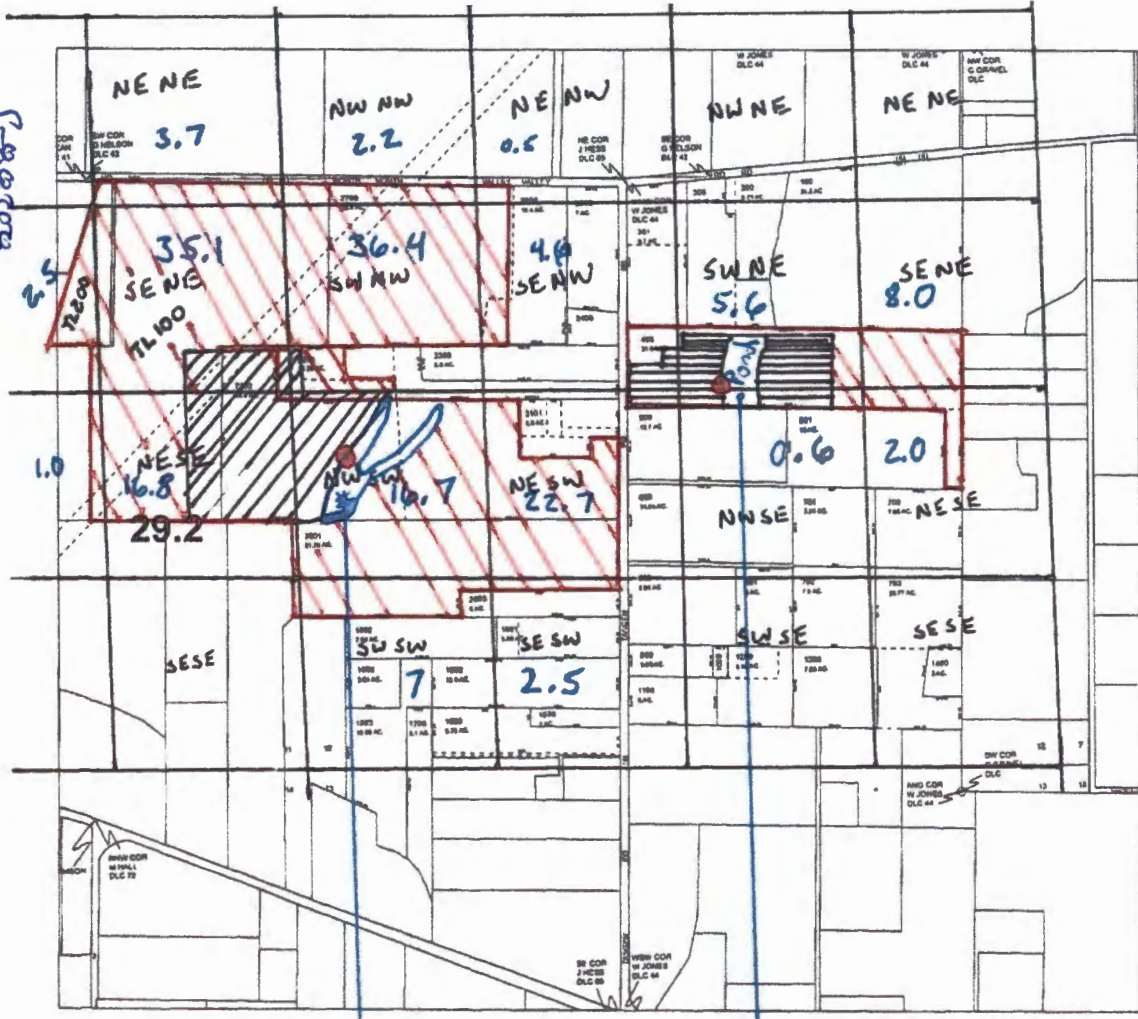

Tanger Reservoir

Reservoir #2

- Certificate 22119 →
- Certificate 22285 →
- New Irrigation 167.9 acres →

- Tanger POD 2200' North and 400 East from SW Corner Sec 12
- Res #2 POD 2700' North and 2300 West from SE Corner Sec 12

RECEIVED BY OWRD

JAN 18 2017

SALEM, OR