T.3S.R.1E.W.M.

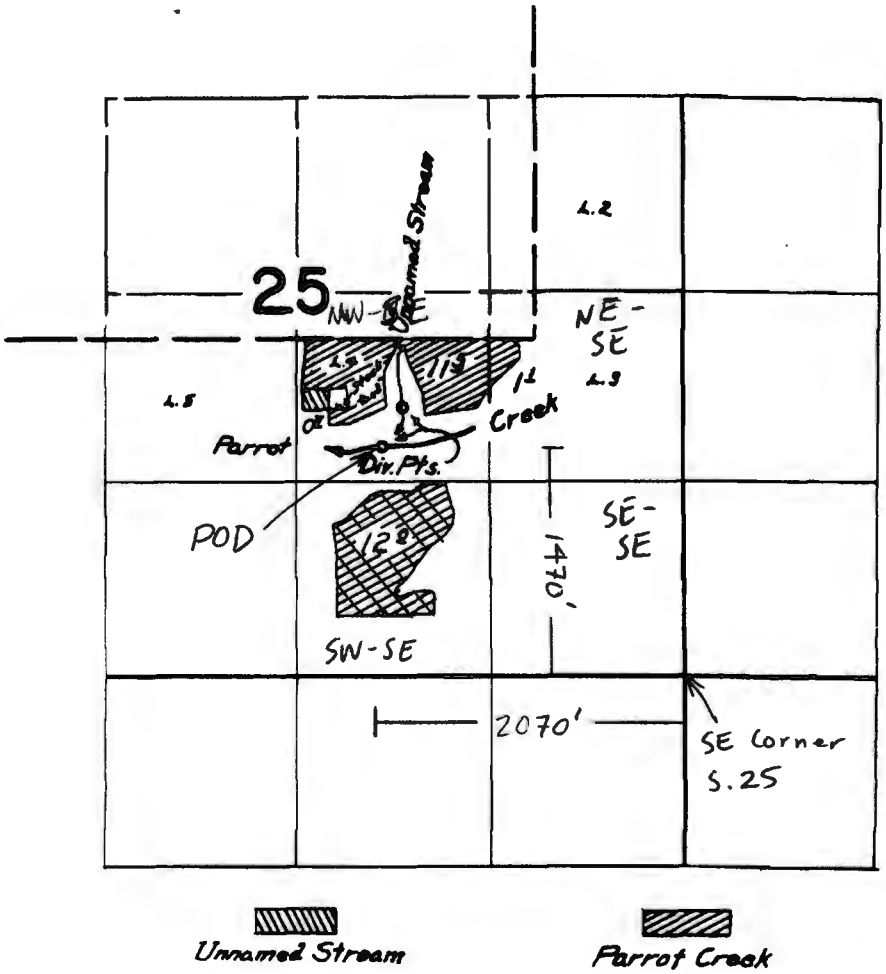

Diversion point located 1470'N 2070'W from SE Cor. S.25

1" = 1320'

Area to be irrigated

RECEIVED
JUN 06 2016
WATER RESOURCES DEPT
SALEM, OREGON