


MAP Revised 07/06/17

Map to Accompany Application for Permit
In the Name of Lee Bischoff

T.6S. R.6W.W.M.

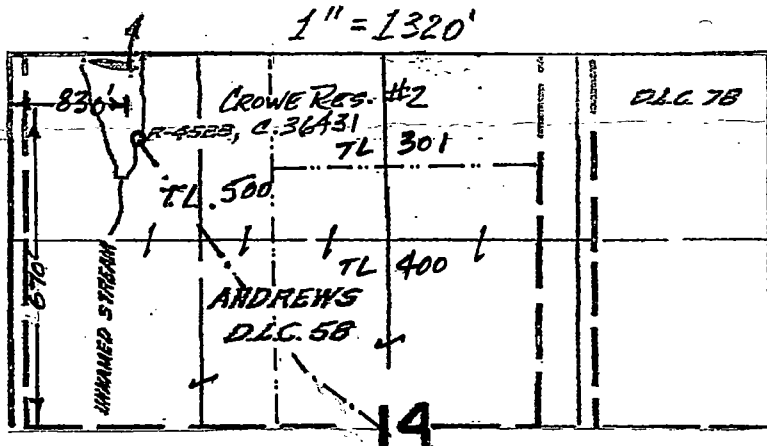


SUPERSEDING

RECEIVED BY OWRD

JUL 17 2017

SALEM, OR

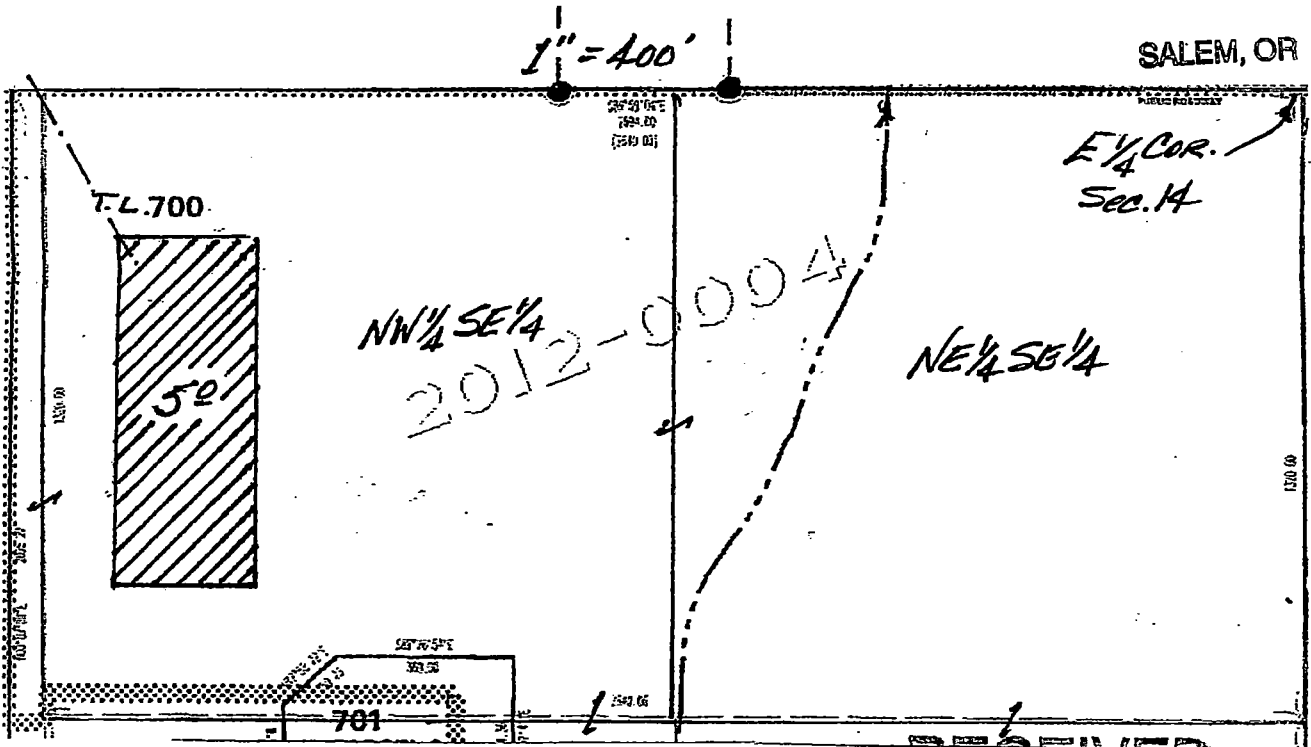

RECEIVED

APR 24 2017

S-88396

OWRD

04/17 *AB*