
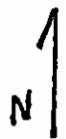


JACKSON COUNTY

water diverted from } Sec 16 T.37 S., R.2 E., W. M.  
and used on } TAX LOT 5500

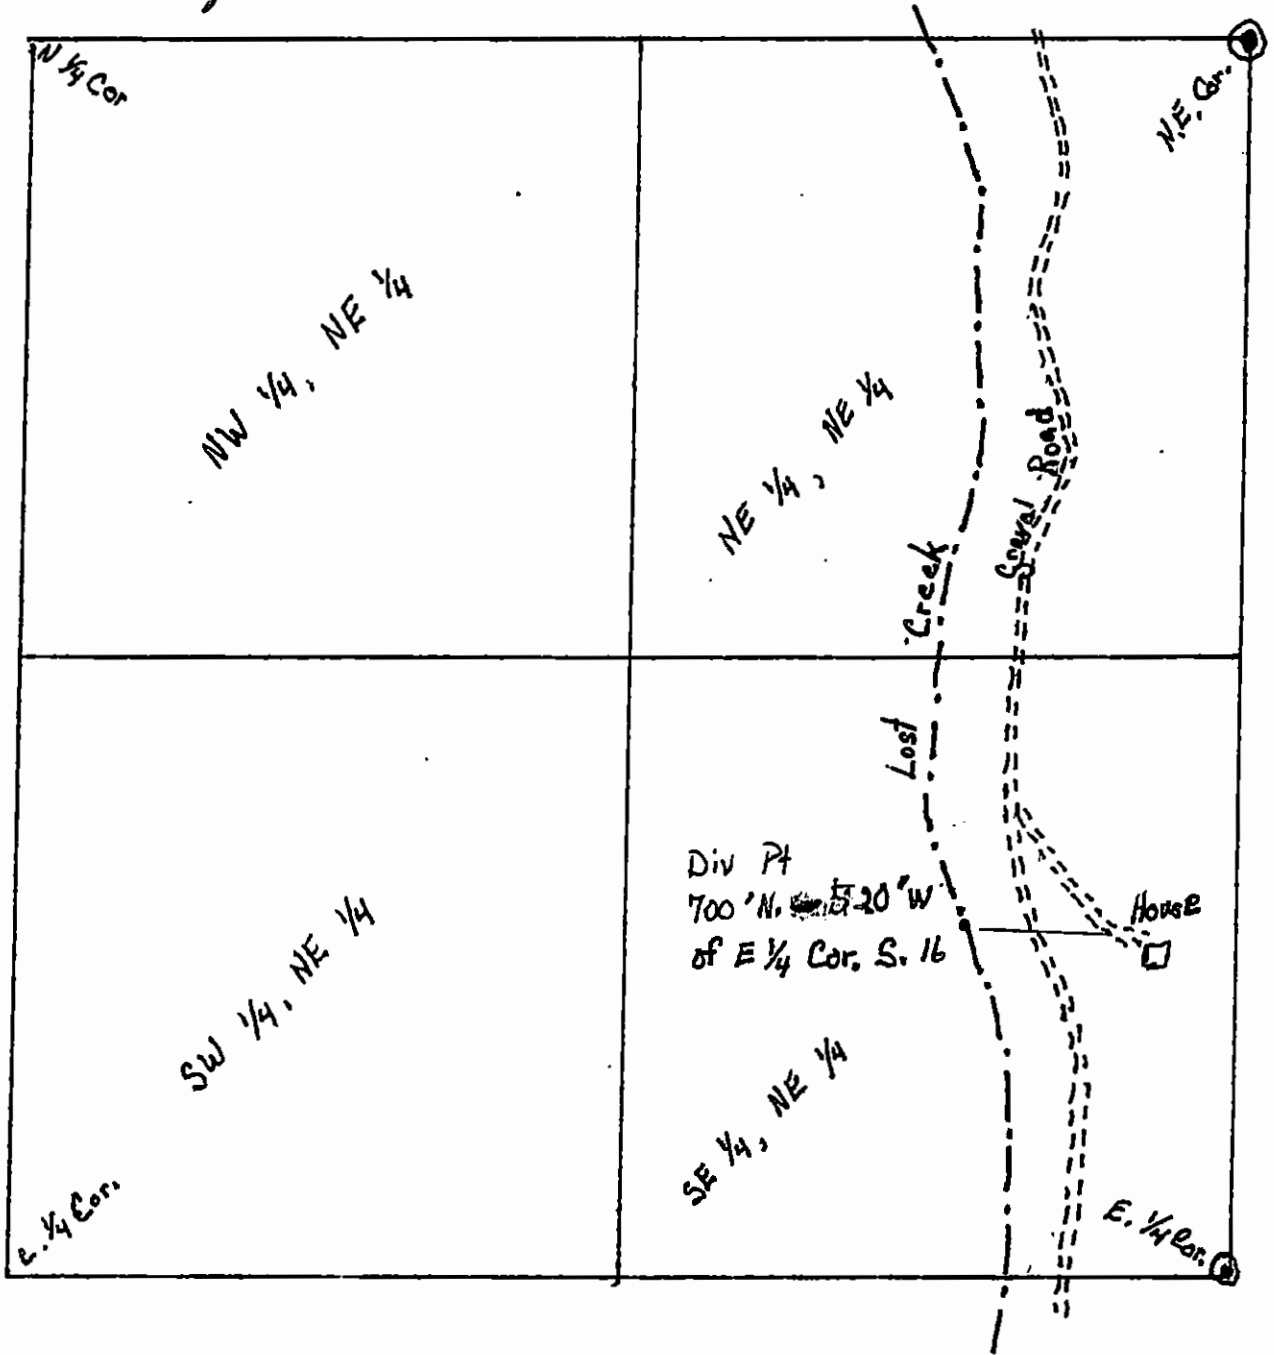

Scale 1" = 400'

S-88113

RECEIVED

JUL 28 2015

OWRD