

WHOAHINK LAKE  
22 23  
27 26

WHOAHINK LAKE


NW 1/4 NE 1/4

NE 1/4 NE 1/4

SW 1/4 NE 1/4

SE 1/4 NE 1/4  
GOV'T LOT 4

THIS MAP IS FOR THE PURPOSE  
OF IDENTIFYING THE LOCATION  
OF THE WATER RIGHT ONLY.  
THERE IS NO INTENT TO PROVIDE  
DIMENSIONS OR LOCATION OF  
PROPERTY OWNERSHIP LINES.

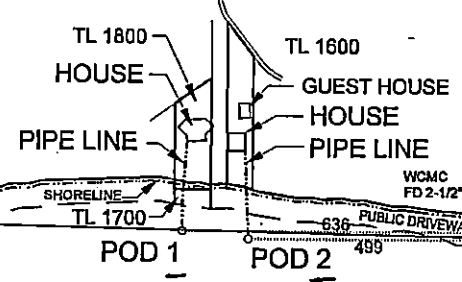

27

RECEIVED BY OWRD

TSILTCOOS LAKE

JUL 25 2016

NE 1/4 SE 1/4

POINT OF DIVERSION 1 IS  
SOUTH 51+- FEET AND  
WEST 636+- FEET FROM  
THE WCMC TO SECTION 27  
AND SECTION 26.

SALEM, OR

# APPLICATION WATER RIGHTS MAP MID COAST BASIN


POINT OF DIVERSION 2 IS  
SOUTH 67+- FEET AND  
WEST 499+- FEET FROM  
THE WCMC TO SECTION 27  
AND SECTION 26.

\* ABOVE DIMENSIONS ARE  
APPROXIMATE AND SUBJECT  
TO SURVEY TIES

S-88627

19-12-27-1-4, TL 1600 & 1800  
SE 1/4 NE 1/4, SEC. 27, T19S, R12W, W.M.  
LANE COUNTY, OREGON

FOR: GEORGE R. & HEATHER. S. NELSON  
P. O. BOX 175  
WESTLAKE, OREGON 97493

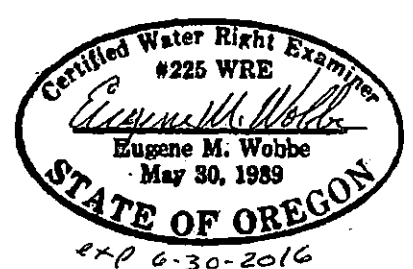

PREPARED BY: WOBBE & ASSOCIATES, INC.  
510 KINGWOOD ST. / P.O. BOX 3093  
FLORENCE, OR 97439  
DATE: JULY 20, 2016

