




THIS MAP WAS PREPARED FOR ASSESSMENT PURPOSE ONLY

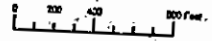

SECTION 32 T.15S. R.47E. W.M.  
MALHEUR COUNTY  
1" = 400'

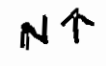

15S 47E 32

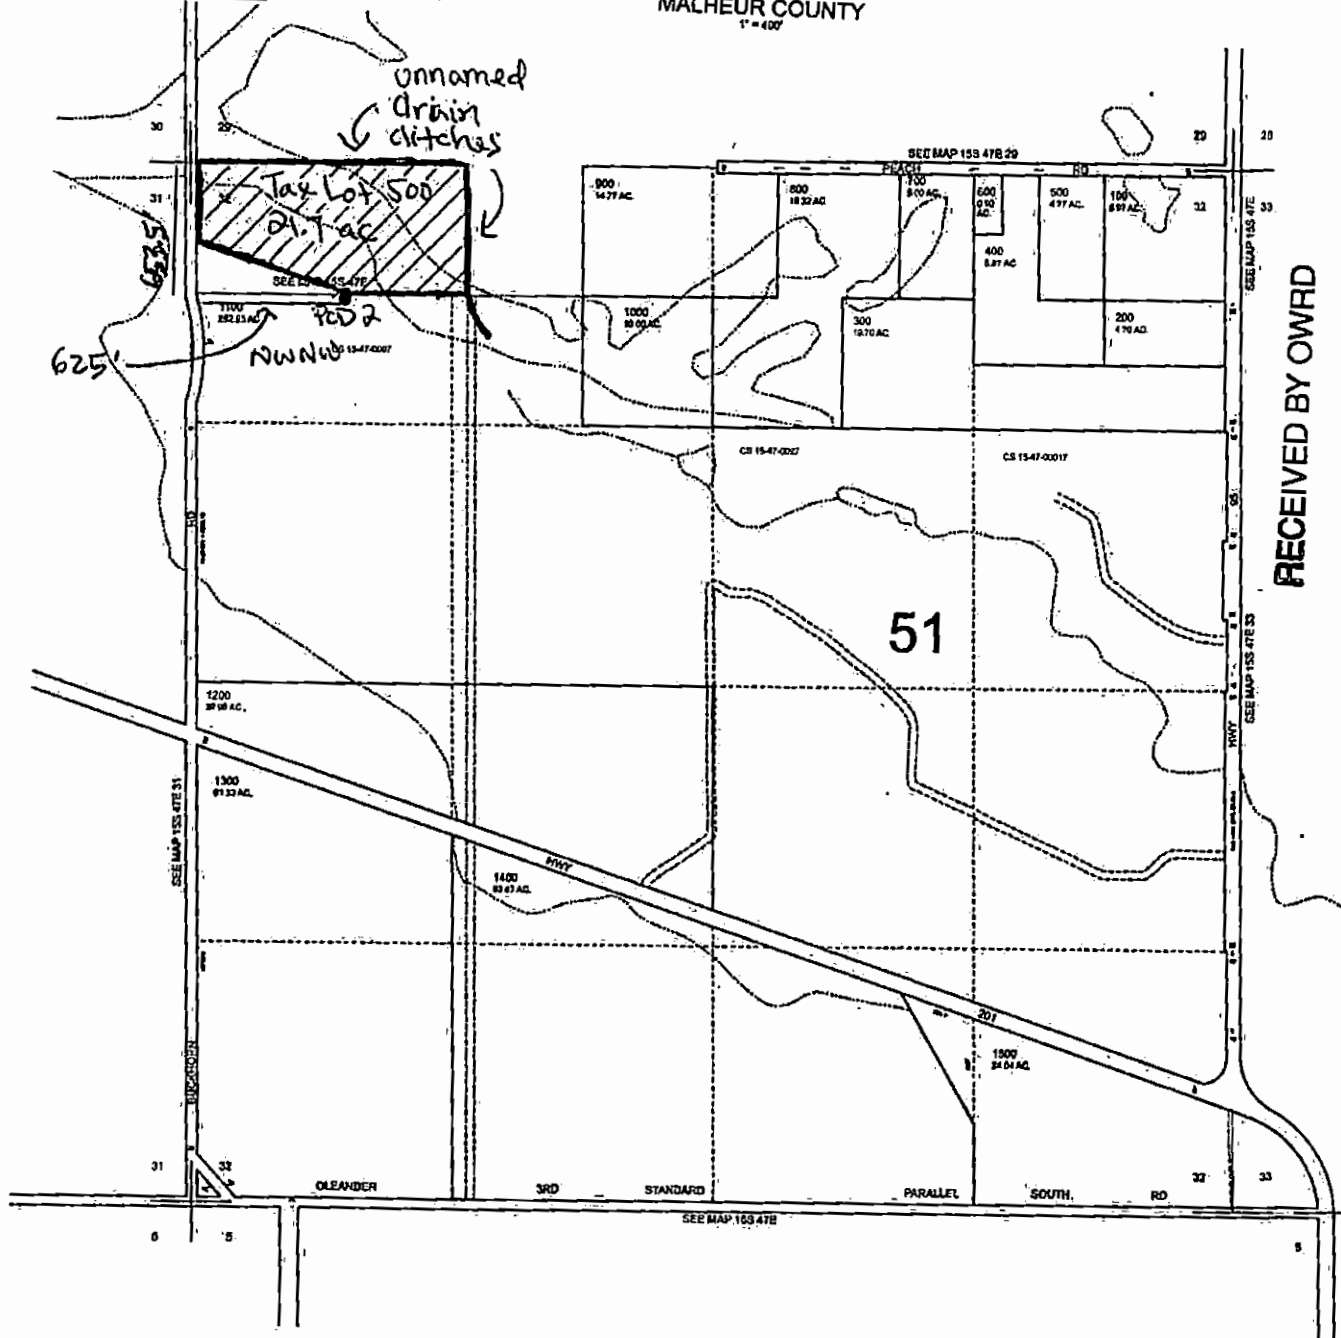


RECEIVED BY OWRD

APR 11 2016

SALEM, OR

S-00211

THIS MAP WAS PREPARED FOR ASSESSMENT PURPOSE ONLY

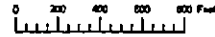


SECTION 29 T.15S. R.47E. W.M.  
MALHEUR COUNTY  
IDAHO

NT

15S47E29  
& INDEX

Conceded  
2600

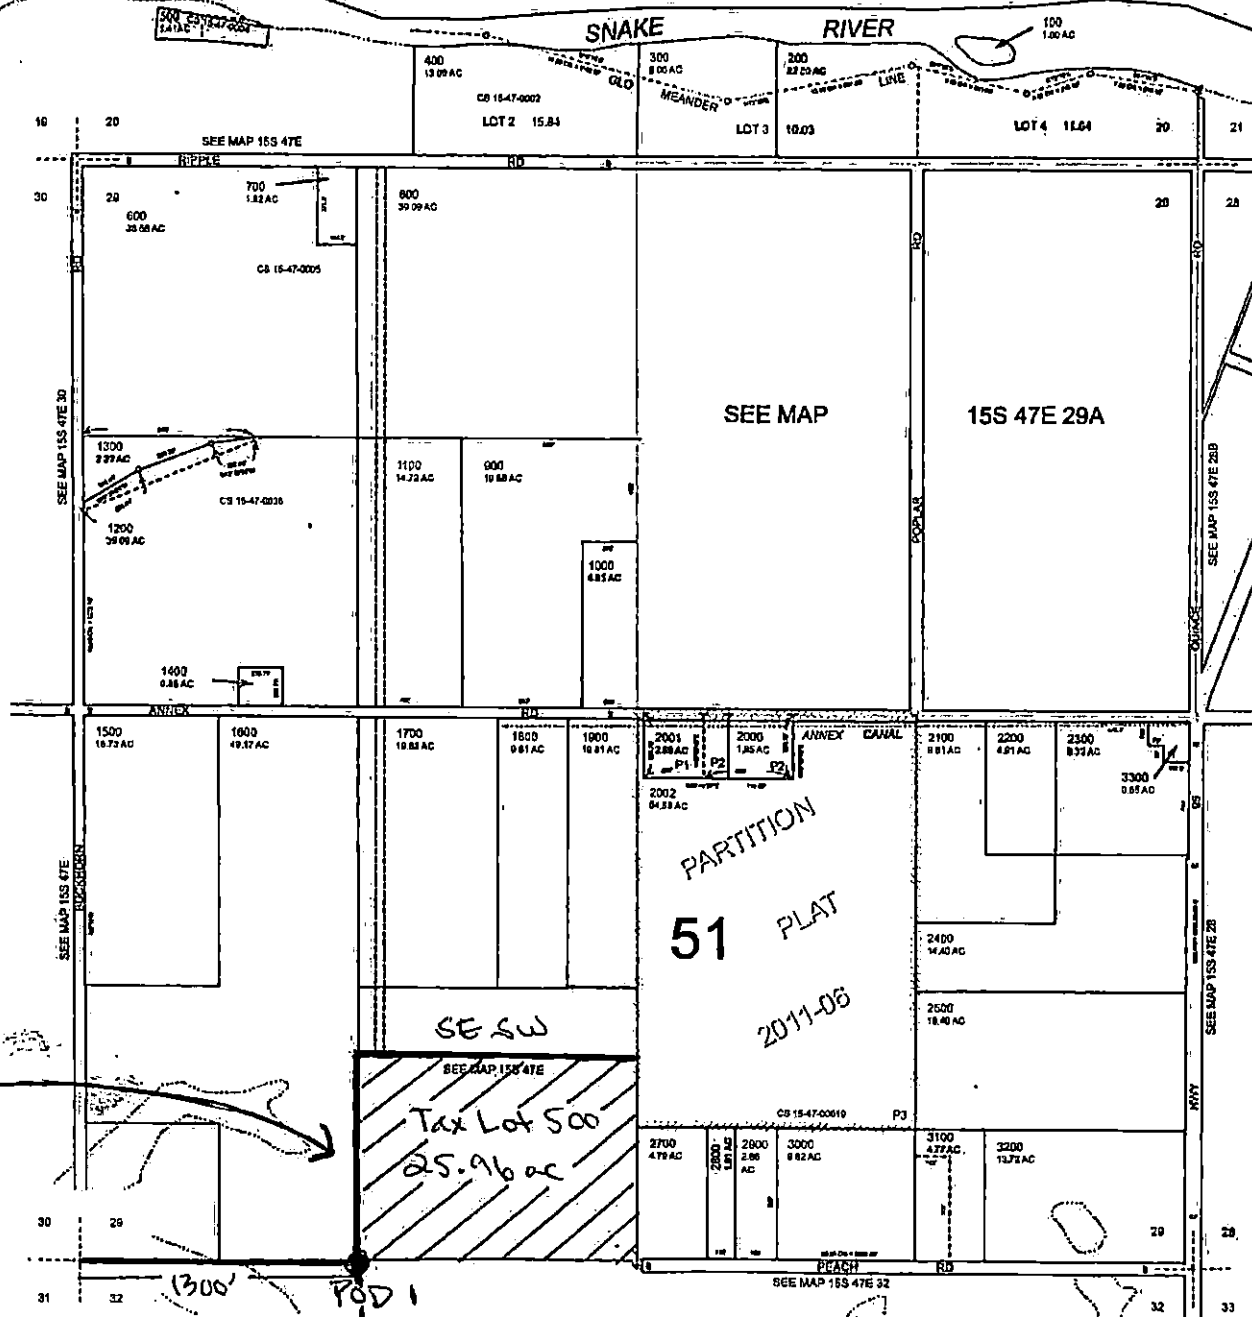


RECEIVED BY OWRD

APR 11 2016

SALEM, OR

Unnamed  
drain  
ditches

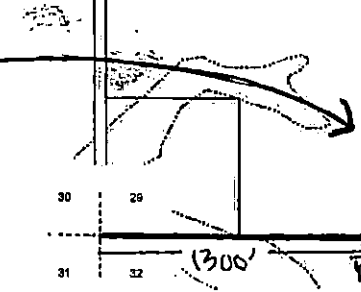

Pod 1

hrag-5

Revised: MA  
10/22/2014

& INDEX  
15S47E29