


T. 20S., R. 9 W., W. M.

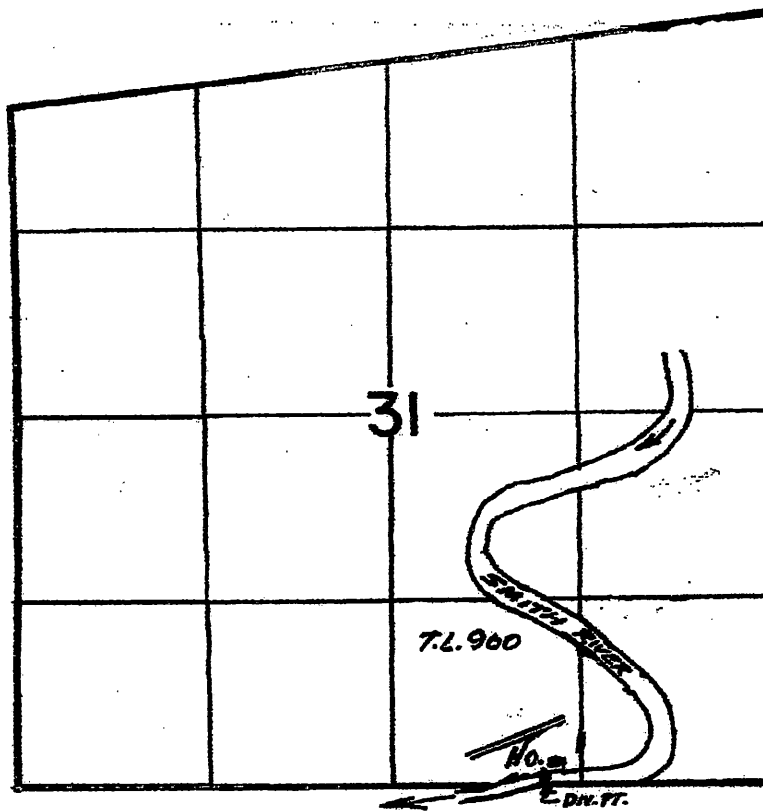

RIVER DIV. PT. : 80' N & 1580' W FROM SE 1/4 COR.
SECTION 31

Scale 1" = 1320'

RECEIVED

MAY 17 2017

OWRD

Map to Accompany Application for
Permit In the Name of Dennis Tollefson

This map is for the purpose of identifying the location of water rights only, and is not
intended to provide legal dimensions or locations of property lines.

S-00408