


# Compilation Map for Application S-86982

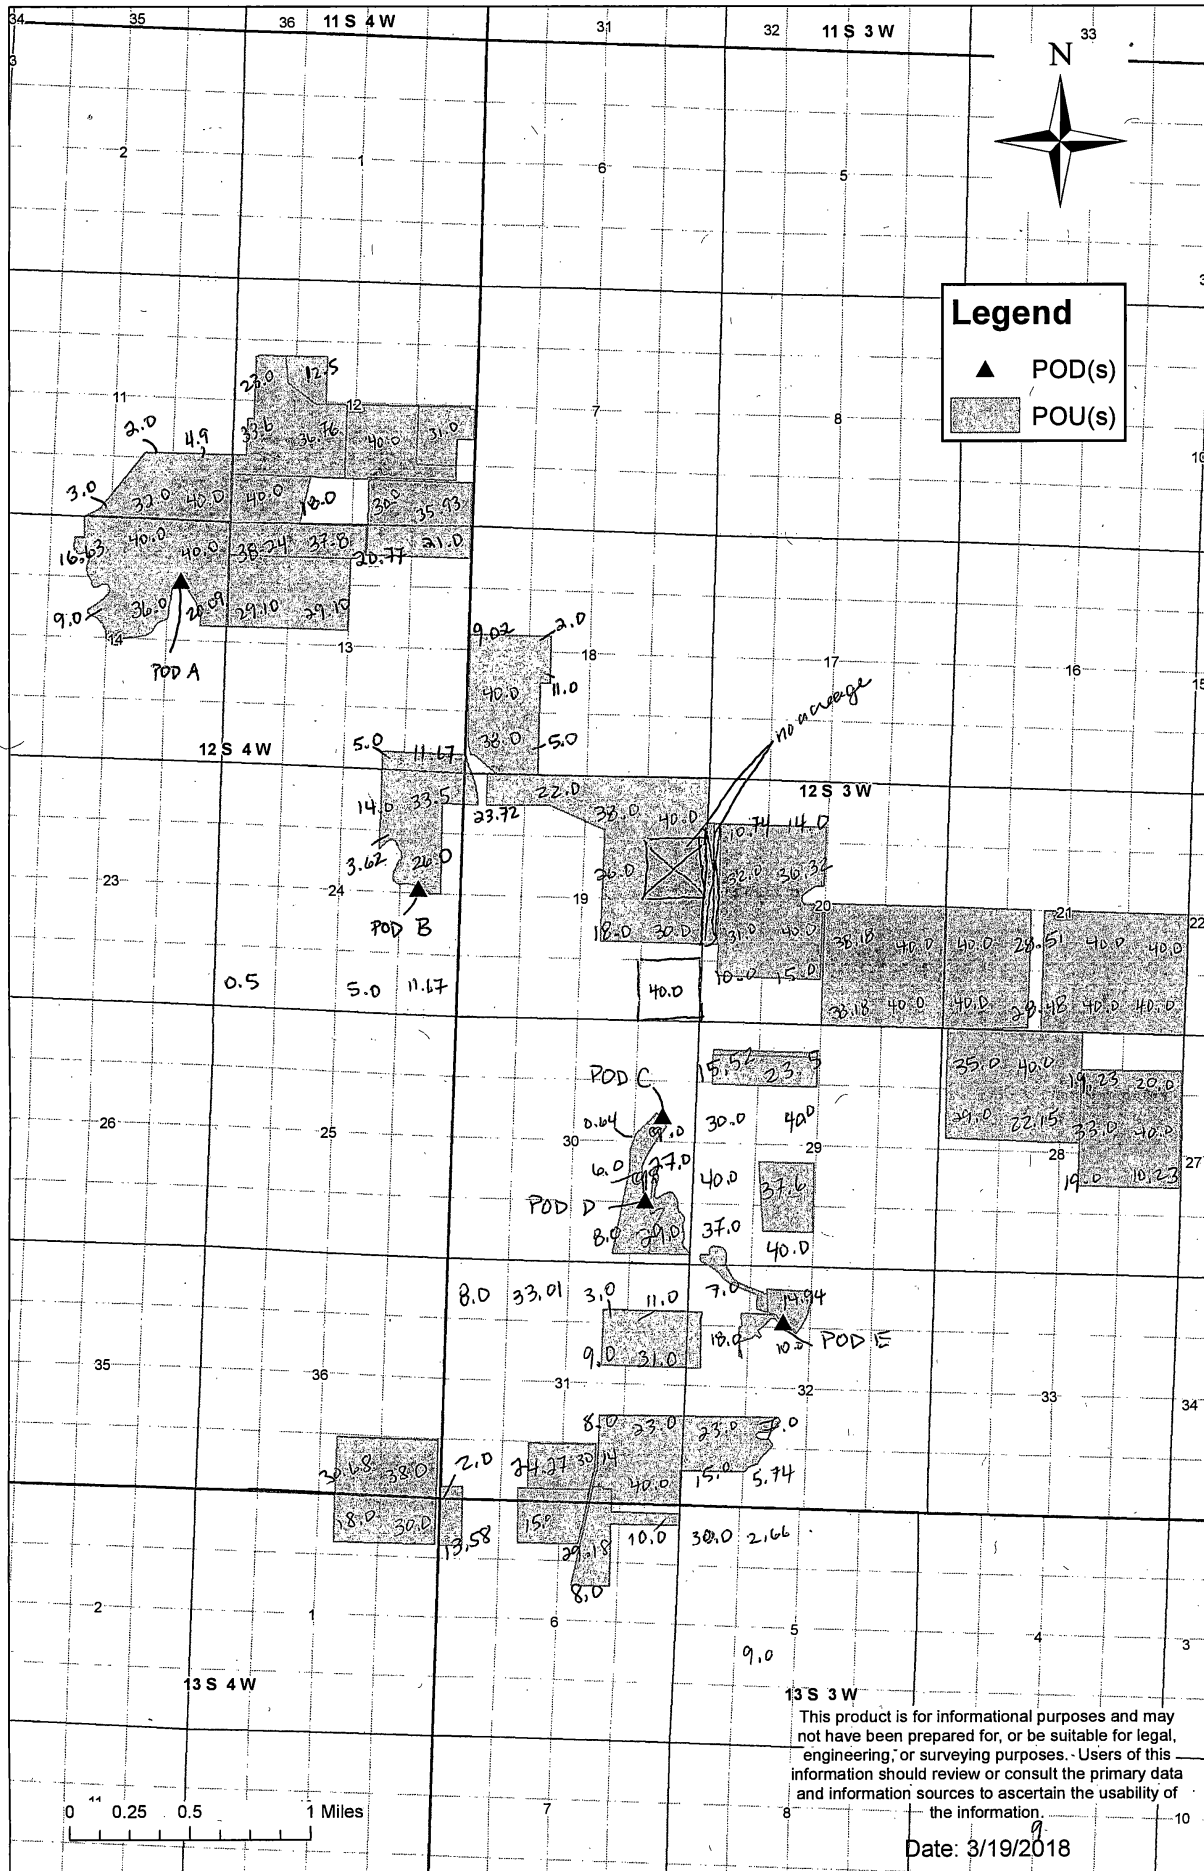

13S

11

12

18

160