
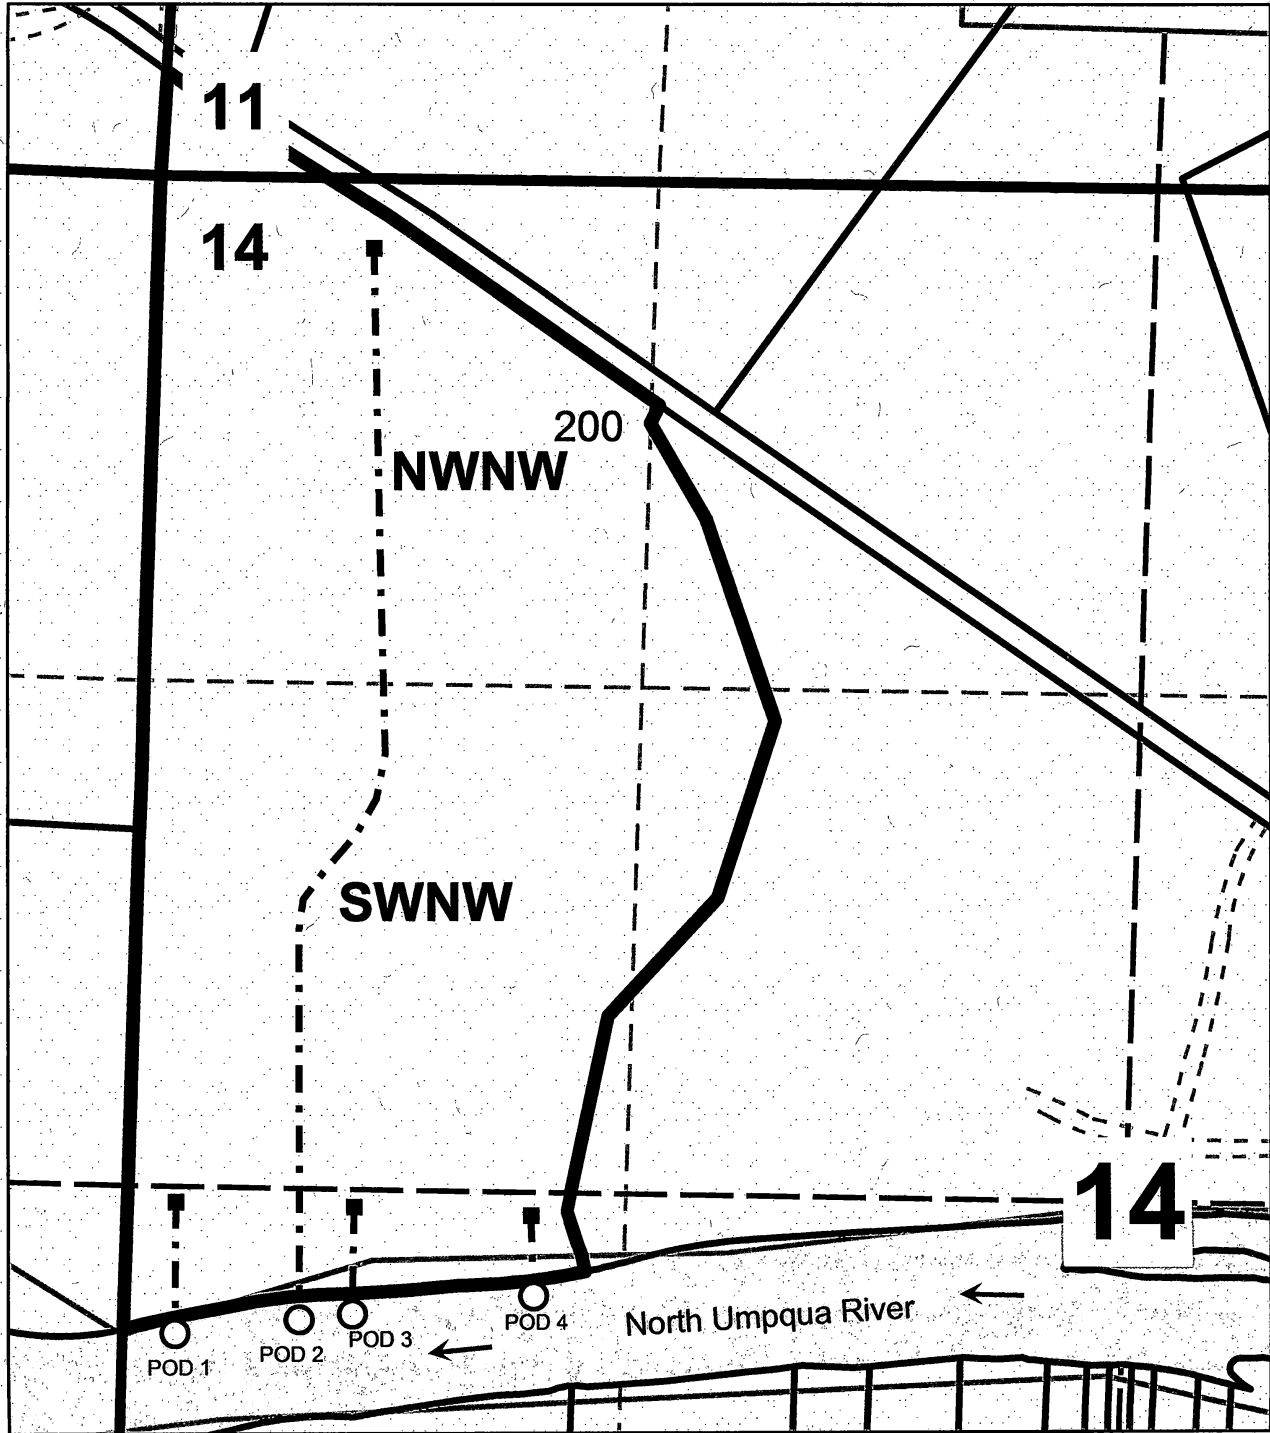


**Water Right Application**  
**James Rose and Thomas Rose**  
**NW 1/4 Section 14 T.26S. R.4W. W.M.**  
**Douglas County**  
**Scale 1" = 500'**

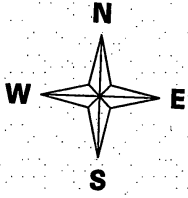

**Point of Diversion 1 is 380' South and 140' East**  
**Point of Diversion 2 is 375' South and 460' East**  
**Point of Diversion 3 is 370' South and 600' East**  
**Point of Diversion 4 is 325' South and 1070' East**  
**all from the West 1/4 Section Corner.**

RECEIVED BY OWRD

AUG 05 2016

SALEM, OR

S-00273