


T.6S. R.1E. Section 19 T.6S. R.1W. Section 24, W.M.

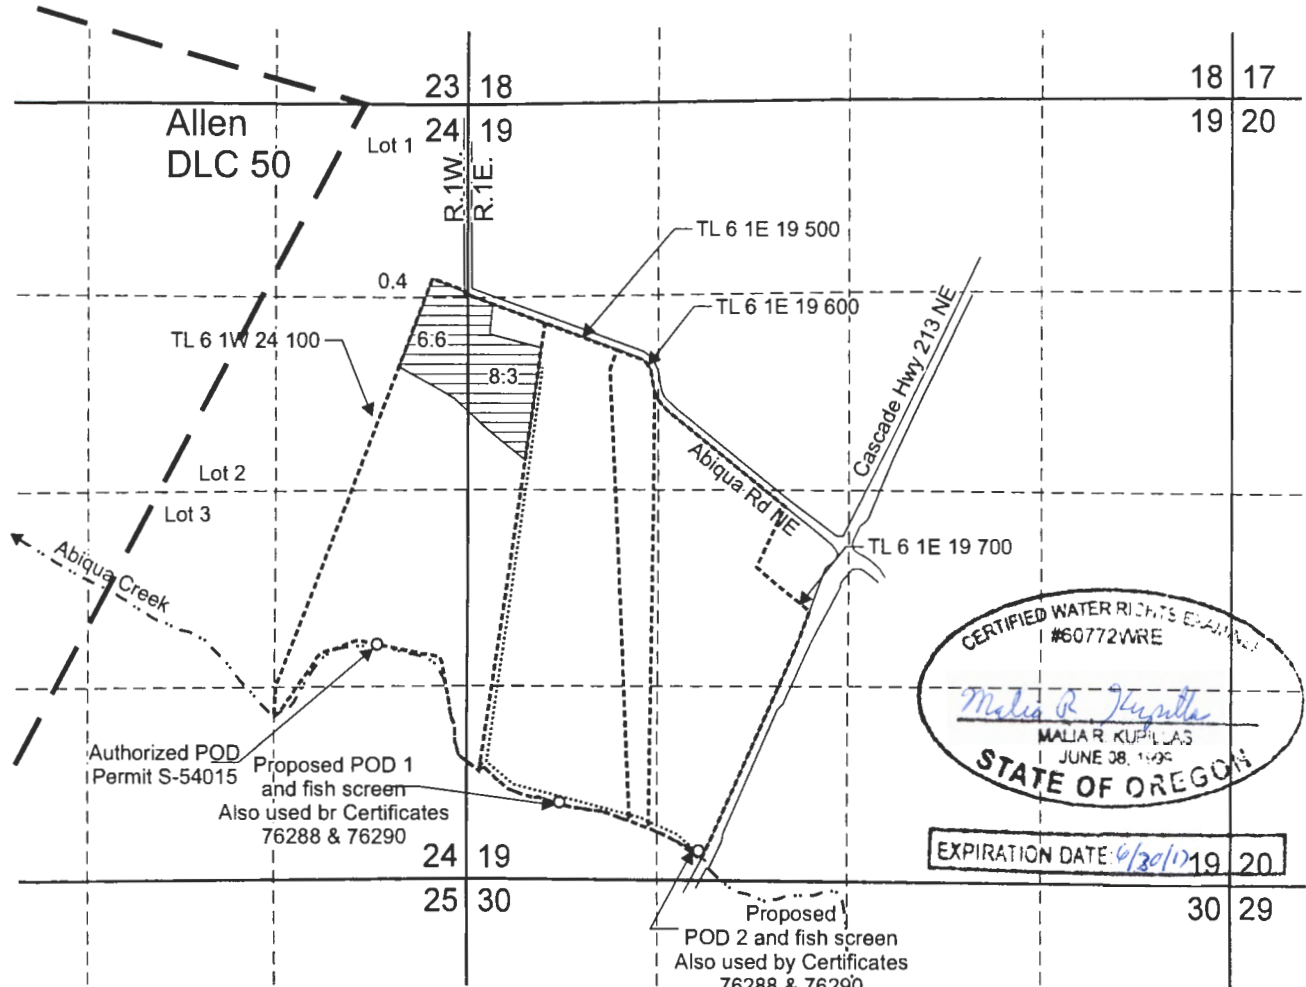

Authorized POD (Permit S-54015) is located 3,680 feet south and 640 feet west from the NE corner, Section 24.


Proposed POD 1 (Certificate 76290 & 76288) is located 4,790 feet south and 720 feet east from the NW corner, Section 19.

Proposed POD 2 (Certificate 76290 & 76288) is located 5,090 feet south and 1,580 feet east from the NW corner, Section 19.

Area (15.3 Acres) irrigated under Application S-71040, Permit S-54015

Donation Land Claim boundary Tax lot boundary Water main line

Scale: 1" = 1,320'

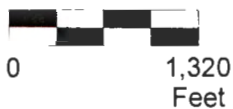

This map was prepared for the purpose of identifying the location of a water right only and is not intended to provide legal dimensions or location of property ownership lines.



Pacific Hydro-Geology Inc.

02/2017

Permit Amendment Map
Application S-71040, Permit S-54015
Goschie Farms
T.6S. R.1E. Section 19,
T.6S. R.1W. Section 24, W.M.

RECEIVED

MAR 02 2017

T 12600

OWRD