


Michael Lorenzen

1" = 1320'

Tax Lot:

Township 4 South, Range 3 West, Section 10, 14, 15, Tax Lot 100, 1900, 2000

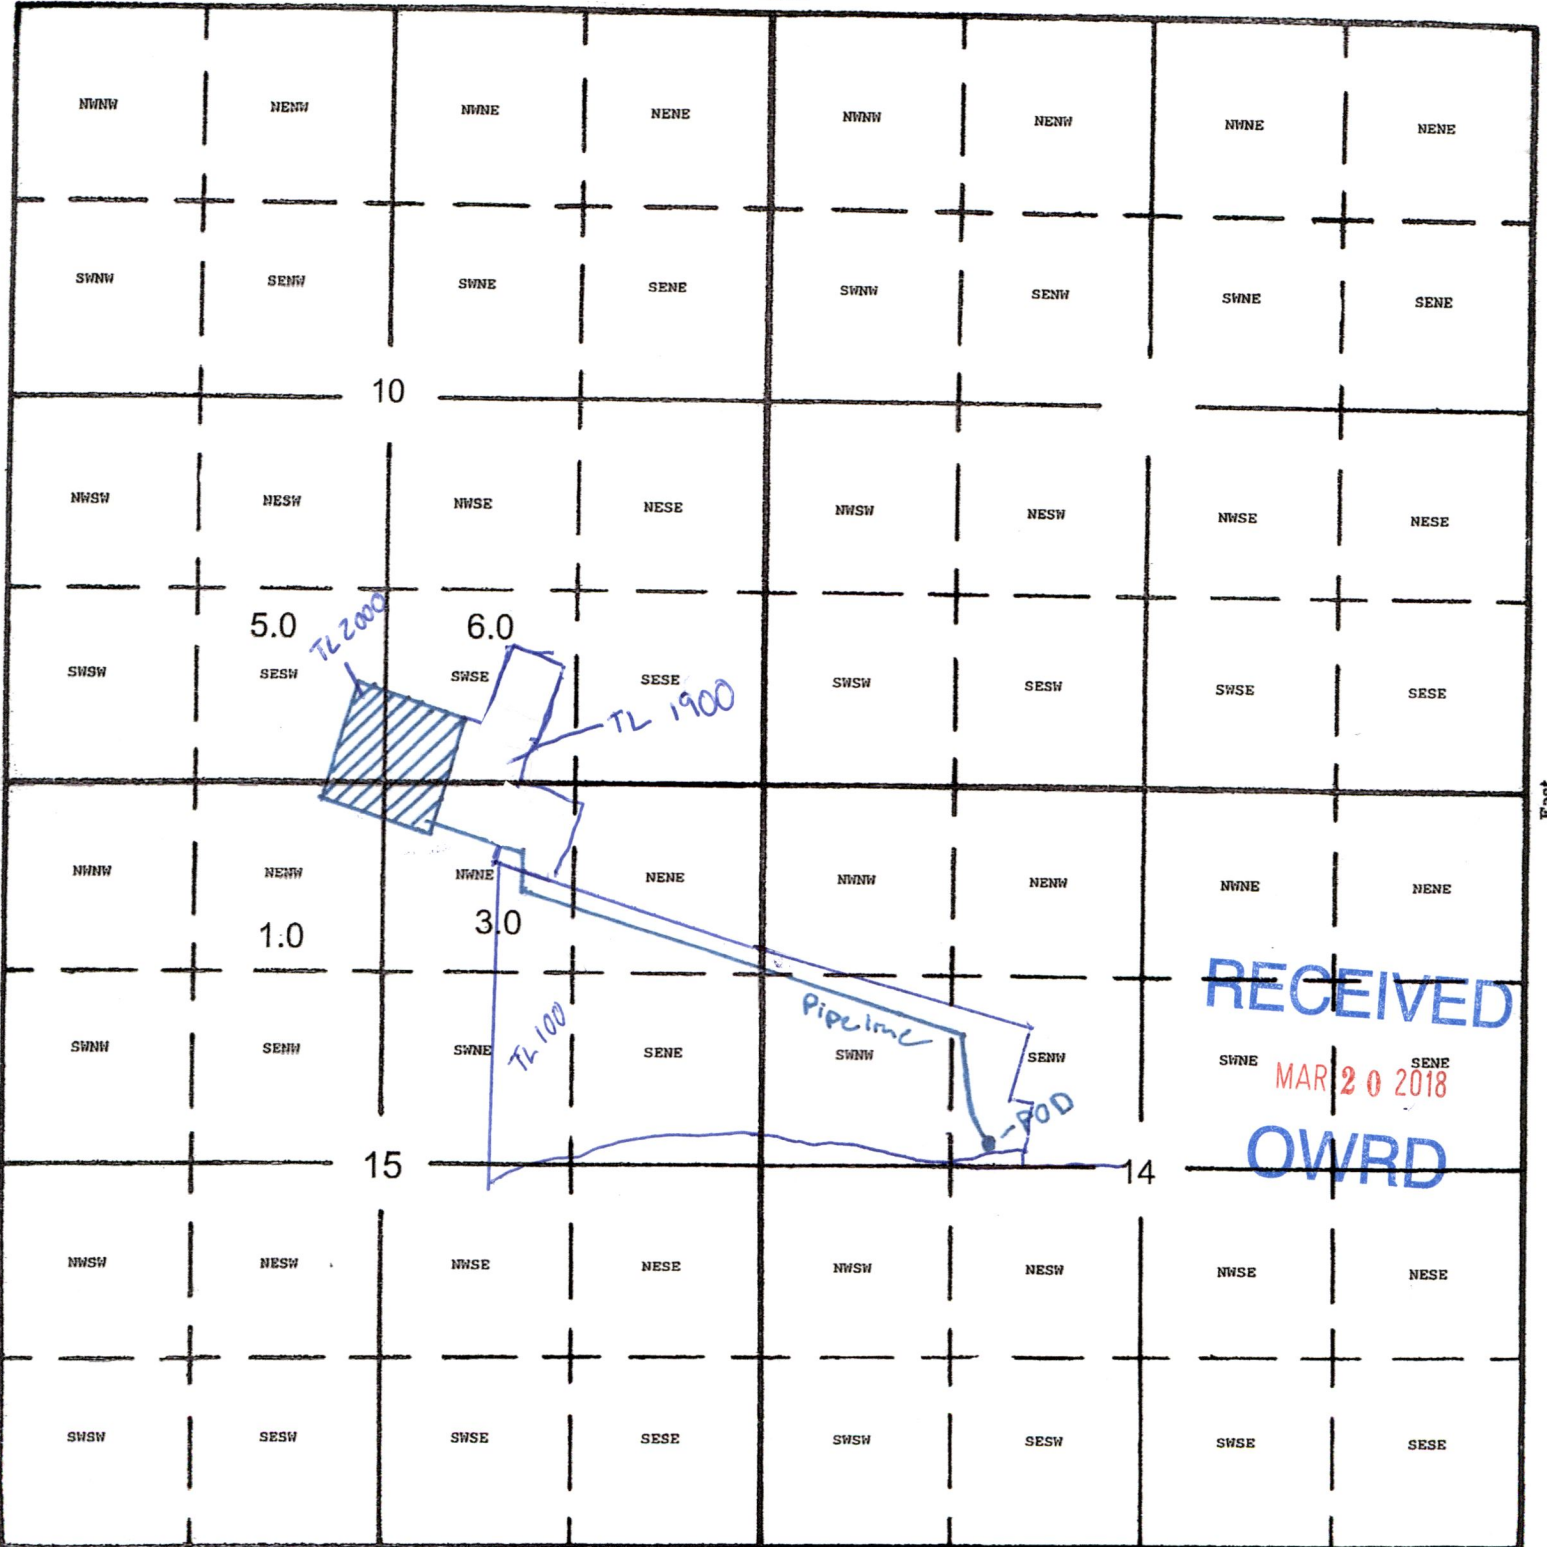

RECEIVED

MAR 20 2018

OW/RD

South

RECEIVED

MAR 16 2018

OW/RD

POD: 2400 South and 1580 East from NW Corner Section 14  
15.0 Acres Irrigation

589522