


Township 4 North, Range 30 East, W.M.
SECTIONS 29, 30, 31, & 32
UMATILLA COUNTY

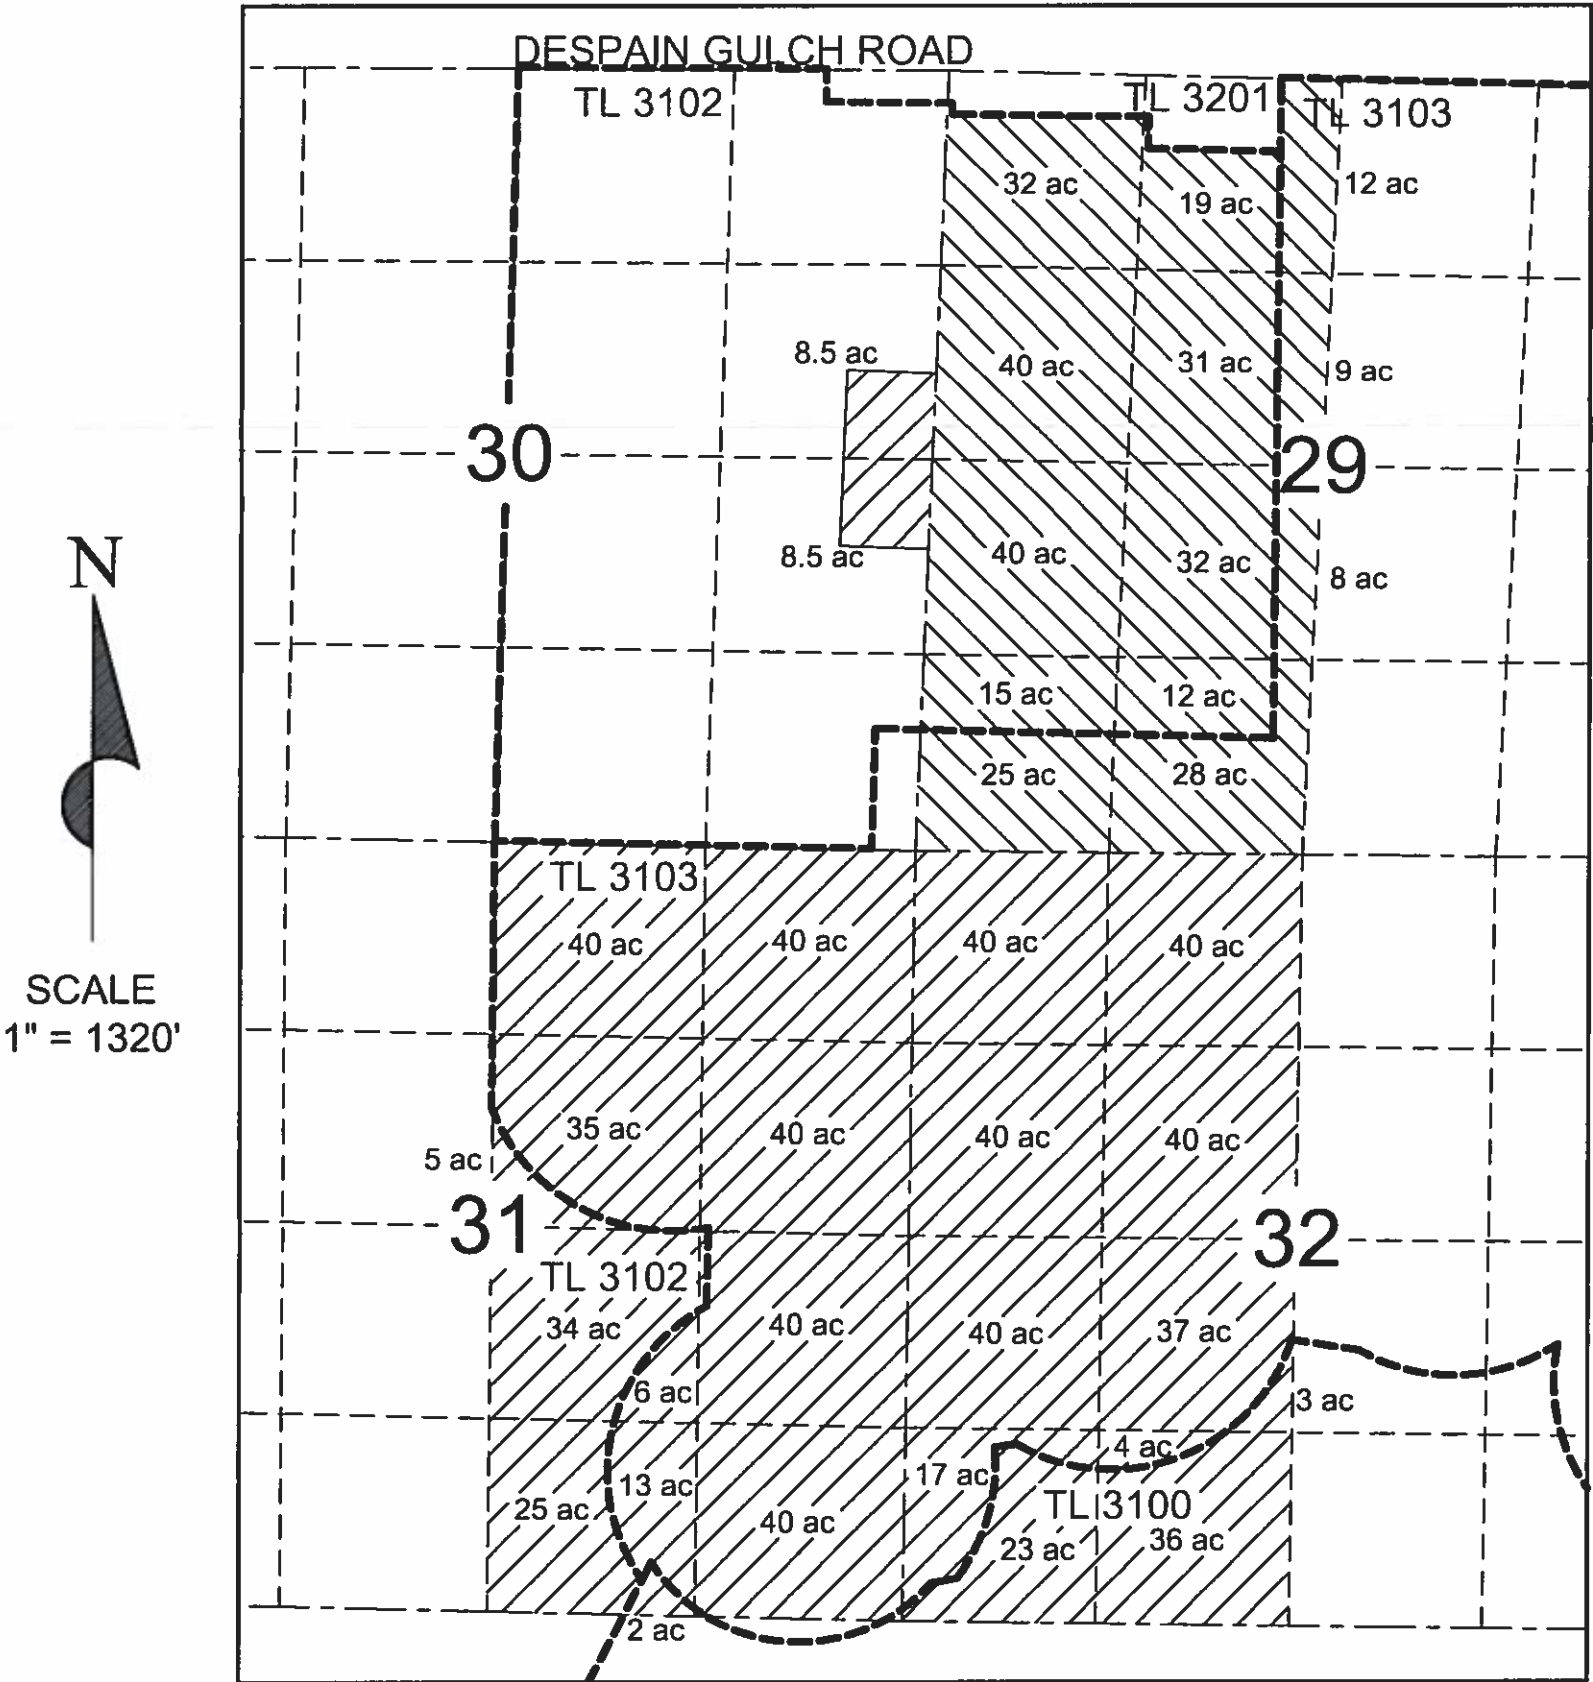

KEY



PROPOSED PLACE OF USE FOR
PRIMARY IRRIGATION FROM THE
COLUMBIA RIVER: 657 AC OF
960 AC TOTAL - UNCHANGED



PROPOSED PLACE OF USE FOR
PRIMARY IRRIGATION FROM THE
COLUMBIA RIVER: 303 AC OF
960 AC TOTAL - REVISED

* PORTIONS OF THESE LANDS ARE
CURRENTLY UNDER TEMPORARY
TRANSFER T-11616.



TAX LOTS

PRIMARY IRRIGATION

122 AC NW 1/4 & 99 AC SW 1/4
T.4N, R.30E, SECTION 29 (TL 3102)

21 AC NW 1/4 & 61 AC SW 1/4
T.4N, R.30E, SECTION 29 (TL 3103)

8.5 AC NE 1/4 & 8.5 AC SE 1/4
T.4N, R.30E, SECTION 30 (TL 3102)

155 AC NE 1/4 & 99 AC SE 1/4
T.4N, R.30E, SECTION 31 (TL 3103)

5 AC NE 1/4 & 59 AC SE 1/4
T.4N, R.30E, SECTION 31 (TL 3102)

2 AC SE 1/4
T.4N, R.30E, SECTION 31 (TL 3100)

160 AC NW 1/4 & 98 AC SW 1/4
T.4N, R.30E, SECTION 32 (TL 3103)

62 AC SW 1/4
T.4N, R.30E, SECTION 32 (TL 3100)

REVISED MAP


RECEIVED BY OWRD

SEP 21 2017

I 12751

SALEM, OR

Township 4 North, Range 30 East, W.M.
SECTIONS 29, 30, 31, & 32
UMATILLA COUNTY

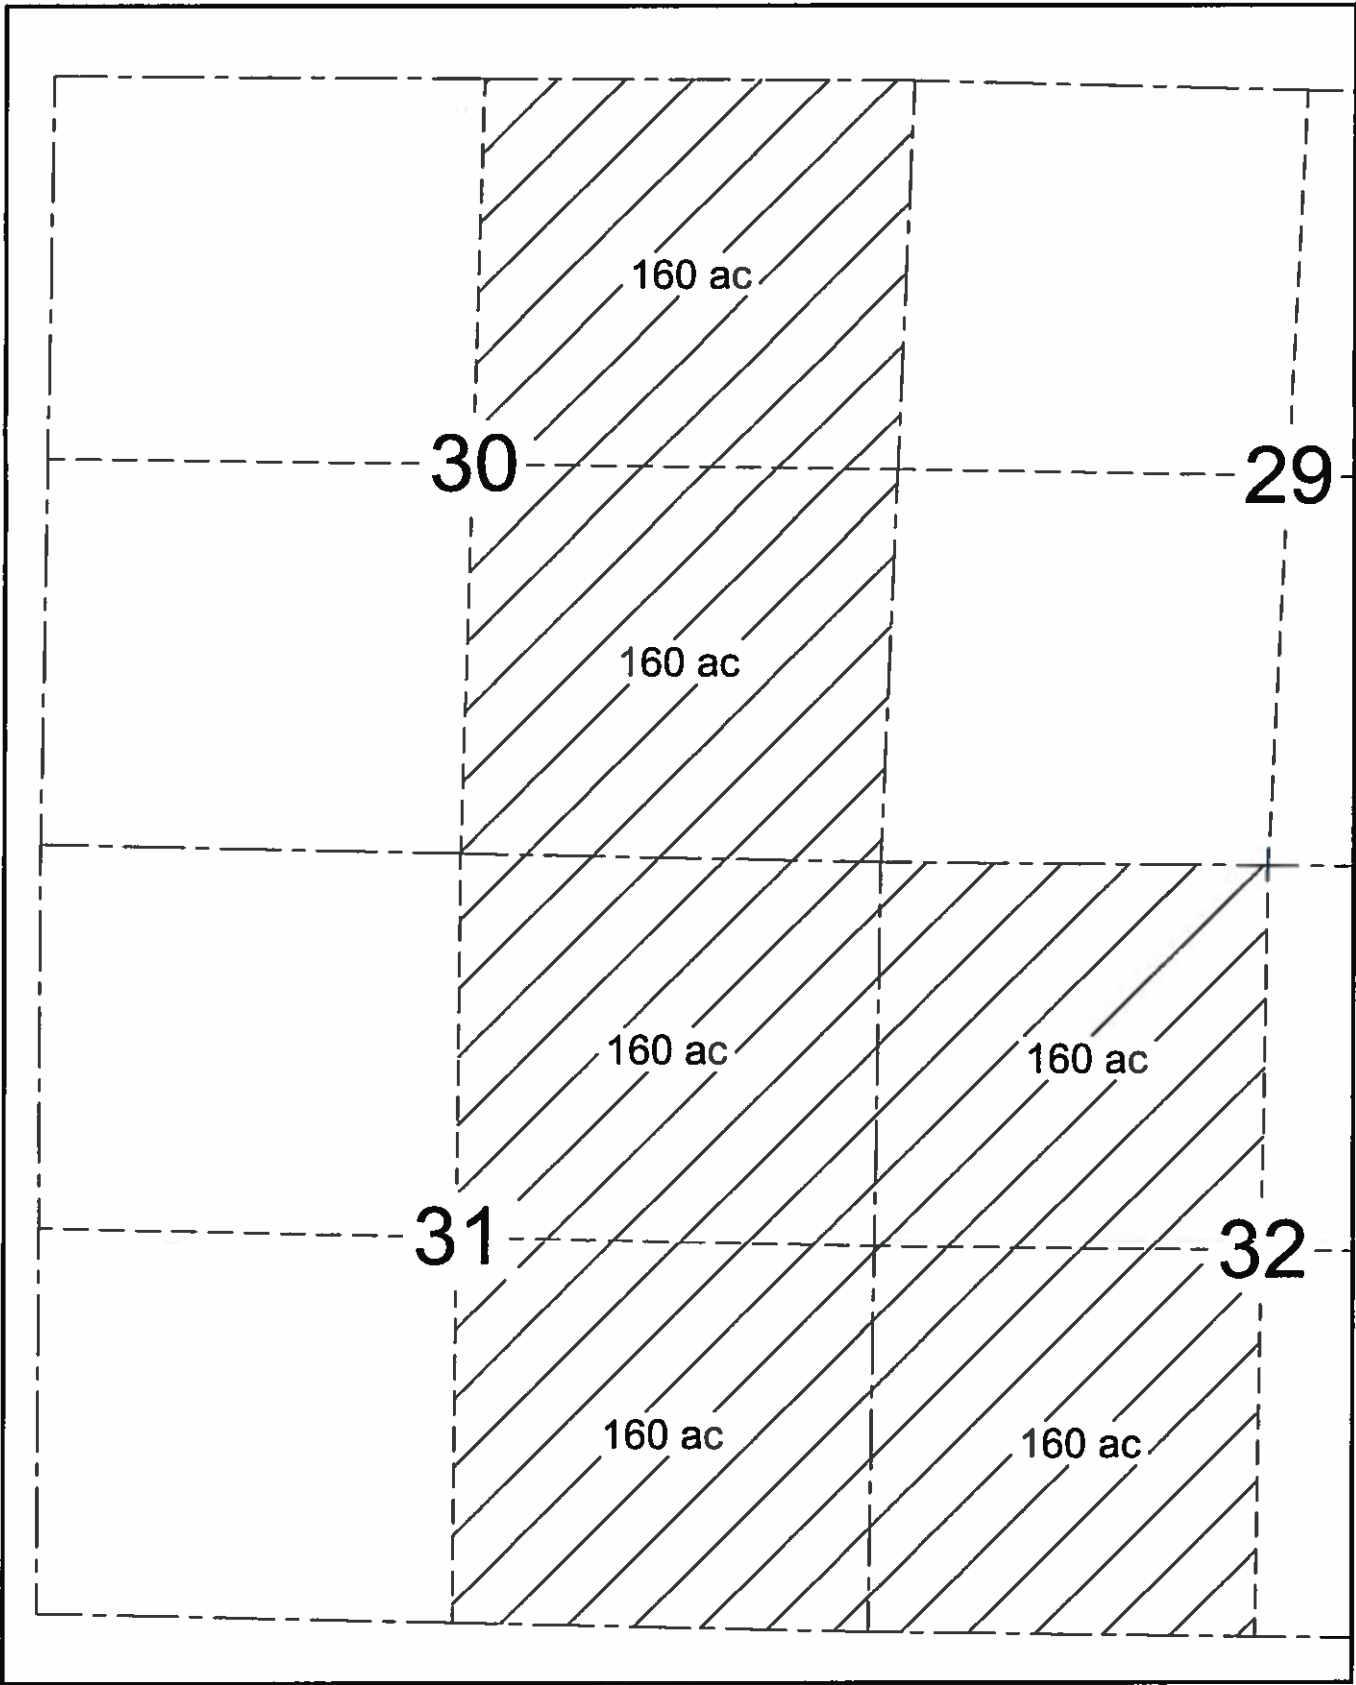

KEY



PROPOSED PLACE OF USE FOR
PRIMARY IRRIGATION FROM THE
COLUMBIA RIVER TOTAL: 960 AC

* PORTIONS OF THESE LANDS ARE
CURRENTLY UNDER TEMPORARY
TRANSFERS 9899 & 9643.

PRIMARY IRRIGATION

160.0 AC NE 1/4
160.0 AC SE 1/4
T.4N, R.30E, SECTION 30 (TL 3200)

160.0 AC NE 1/4
160.0 AC SE 1/4
T.4N, R.30E, SECTION 31 (TL 3200)

160.0 AC NW 1/4
160.0 AC SW 1/4
T.4N, R.30E, SECTION 32 (TL 3200)

RECEIVED BY OWRD

SEP 21 2017



SALEM, OR

ORIGINAL MAP
(RECEIVED NOV. 17 2006)

12751

Pod Location : 2910' North & 120' East
from the SW Corner
Sec. 8., T. 5N., R. 30E. WM.


Attachment "B"
Columbia River Pod
to Serve all 3249.4 acres

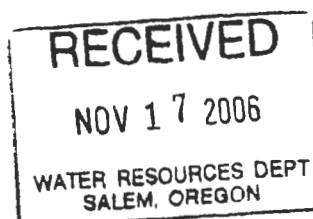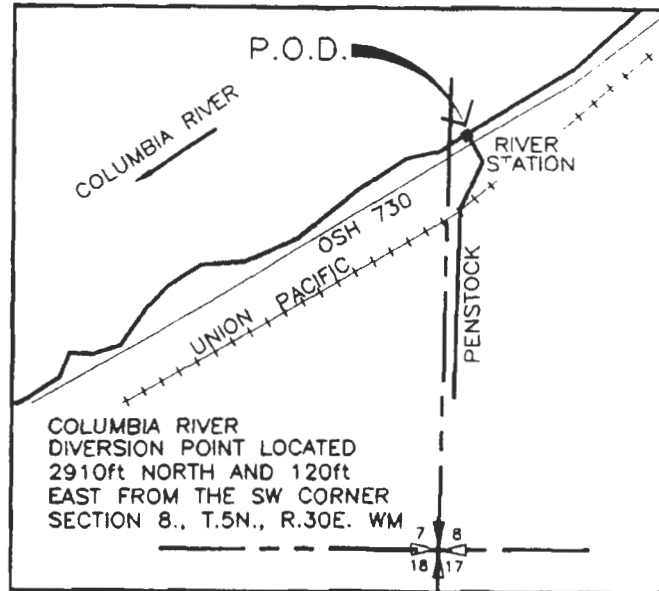

RECEIVED BY OWRD

SEP 21 2017

SALEM, OR

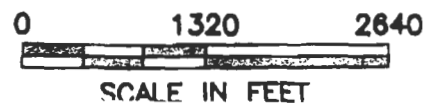

T 12751

app no S-86717 Permit no S-54385