


1" = 1320'  
Tax Lot: 604

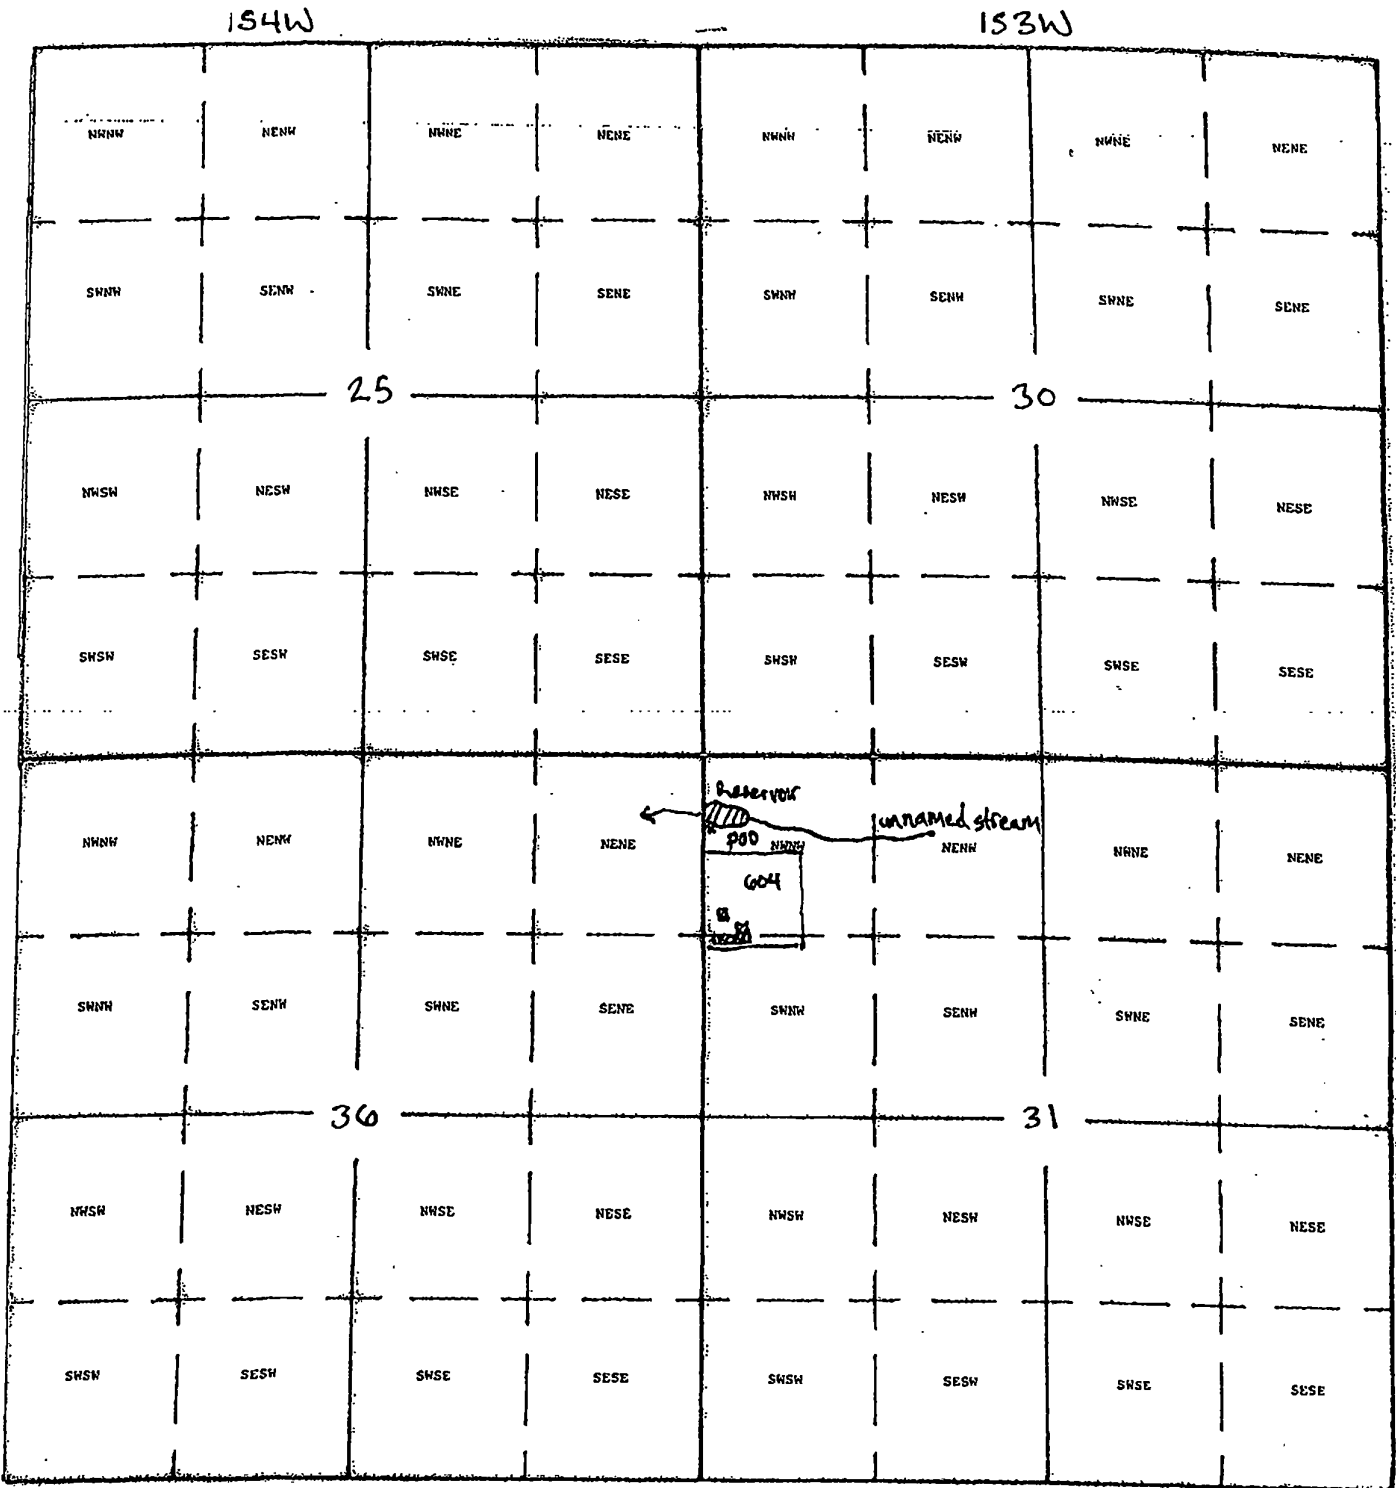

POD location = 550' south and 40' east of the Northwest corner of section 31, 153W

- = reservoir
- x = POD
- = POLI
- S-88588



RECEIVED  
 JUN 11 2018  
 OWRD

62588-5

Reg. Co. Rd. No. 912

WITHEGOMB

Co. Rd. No. 912

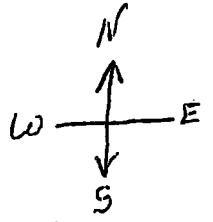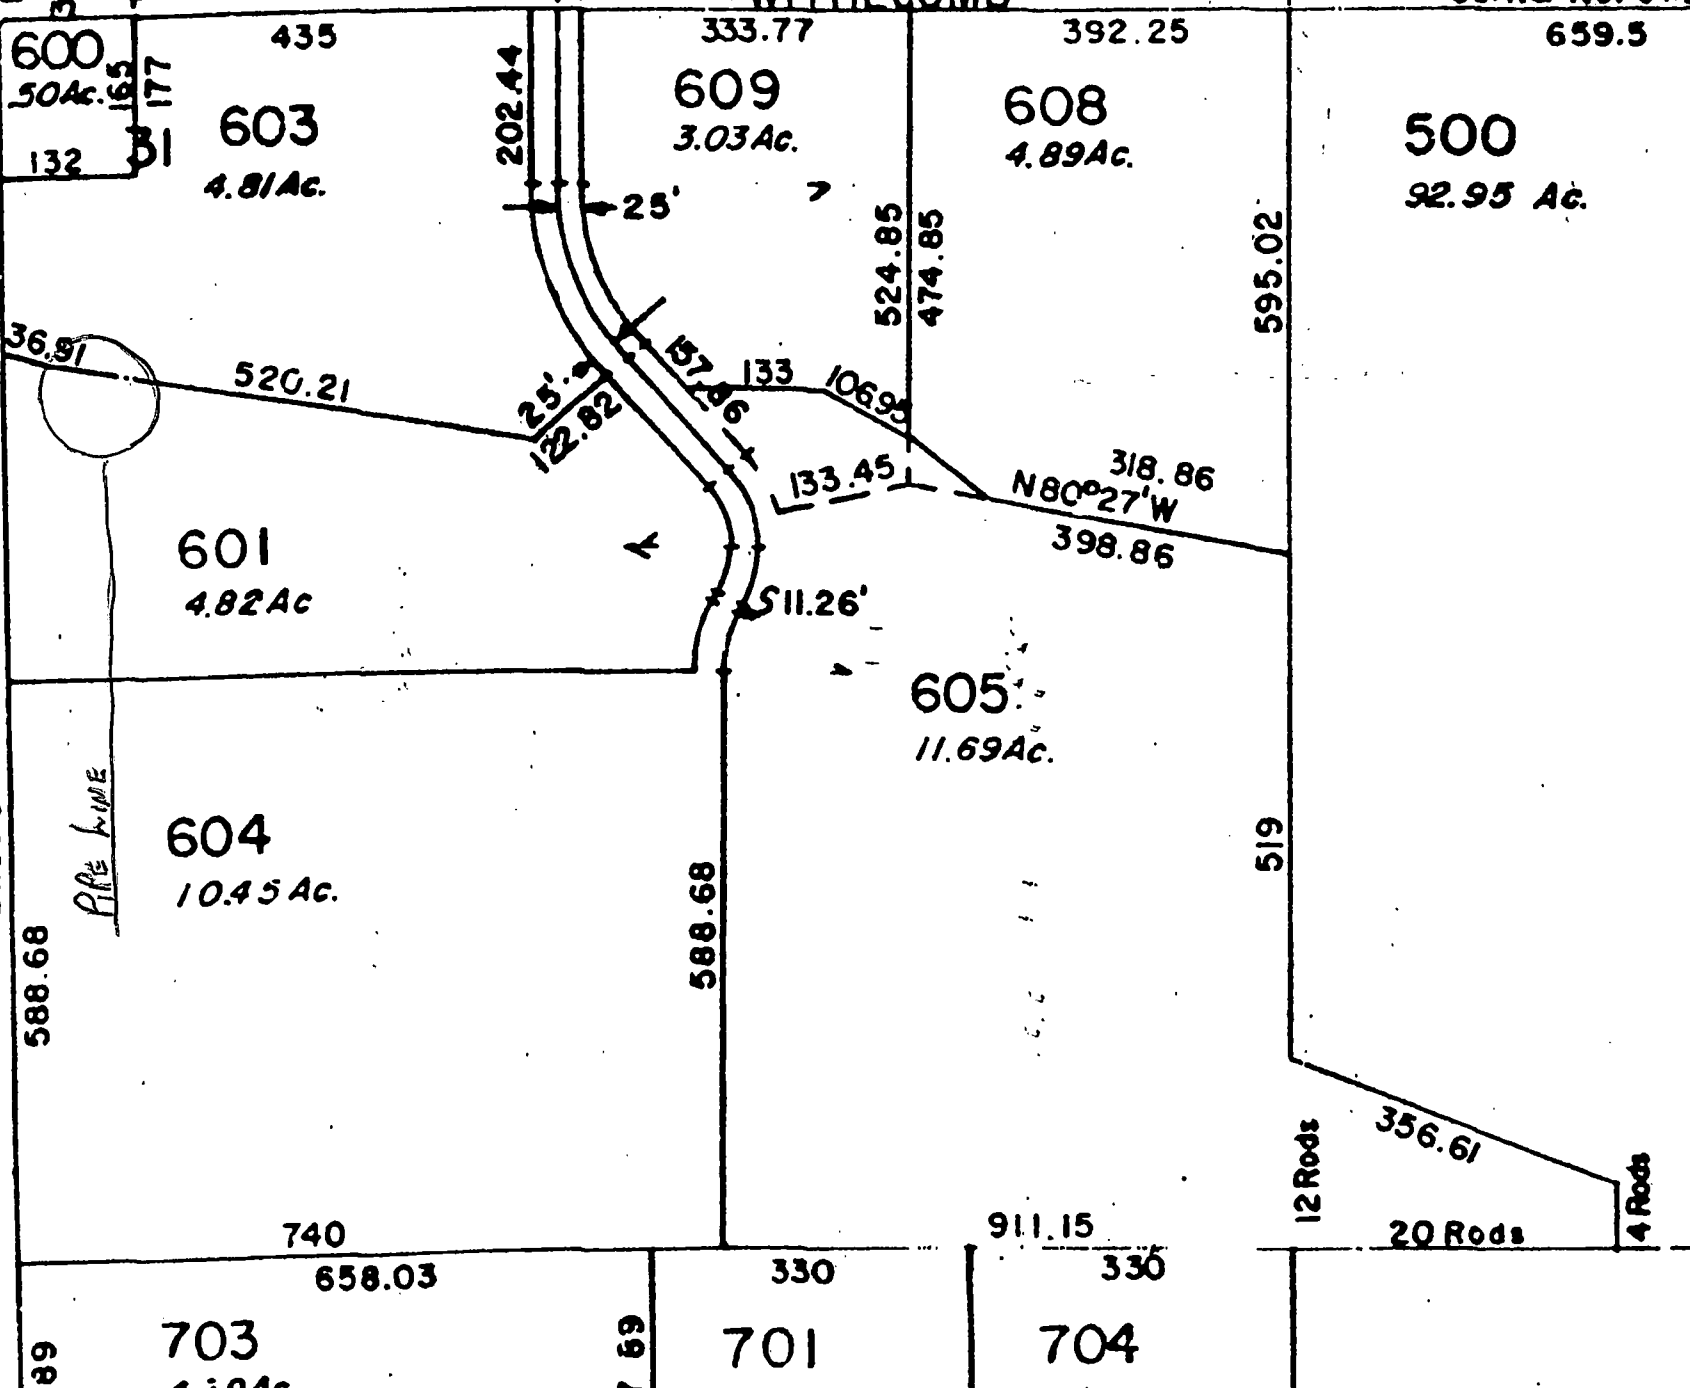

RECEIVED  
 JUN 11 2018  
 OWRD  
 36  
 4AP

RECEIVED  
 JUN 11 2018  
 OWRD