
North A

Rump

1305 and 390 w from NE Corner, SUSW Sez 23

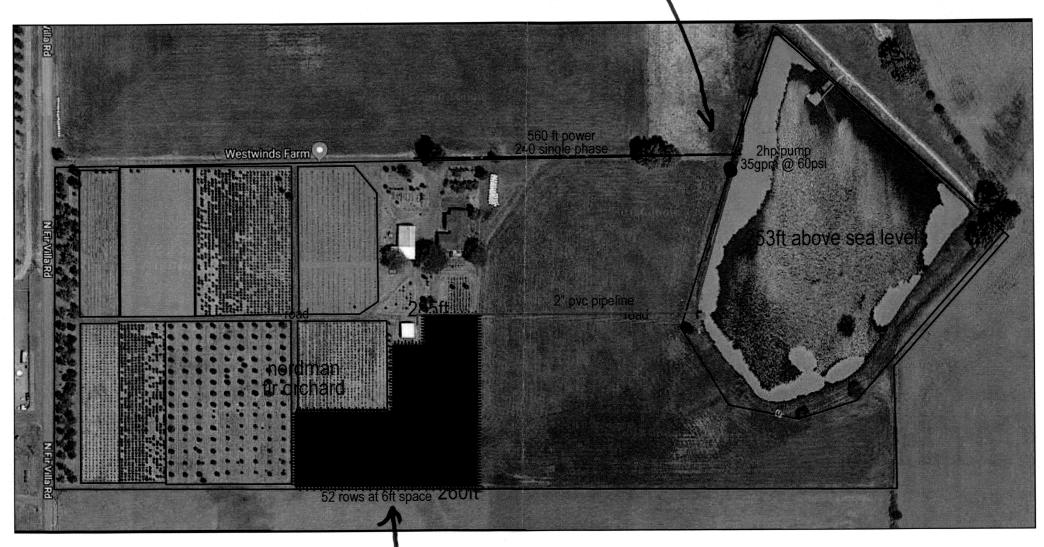

Z acres Show

RECEIVED

JAN 02 2019

**OWRD** 

## Ret Colner



## **RECEIVED**

JAN 02 2019

**OWRD**