



NOTES

1. This map was prepared for the purpose of identifying the location of water rights only and is not intended to provide legal dimensions or locations of property ownership lines.

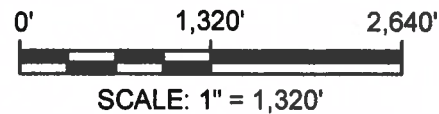


**SURFACE WATER APPLICATION MAP
TAX LOT 100 & 1700**

Located in Section 26, 34, 35, & 36
T.16.S, R.23.E W.M.
Deschutes Basin, Crook County, Oregon

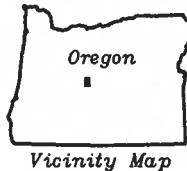

EXPLANATION

- Proposed Place of Use
Total = 372.8 Ac
- 203 Tax Lot ID Number
- Tax Lot Boundary

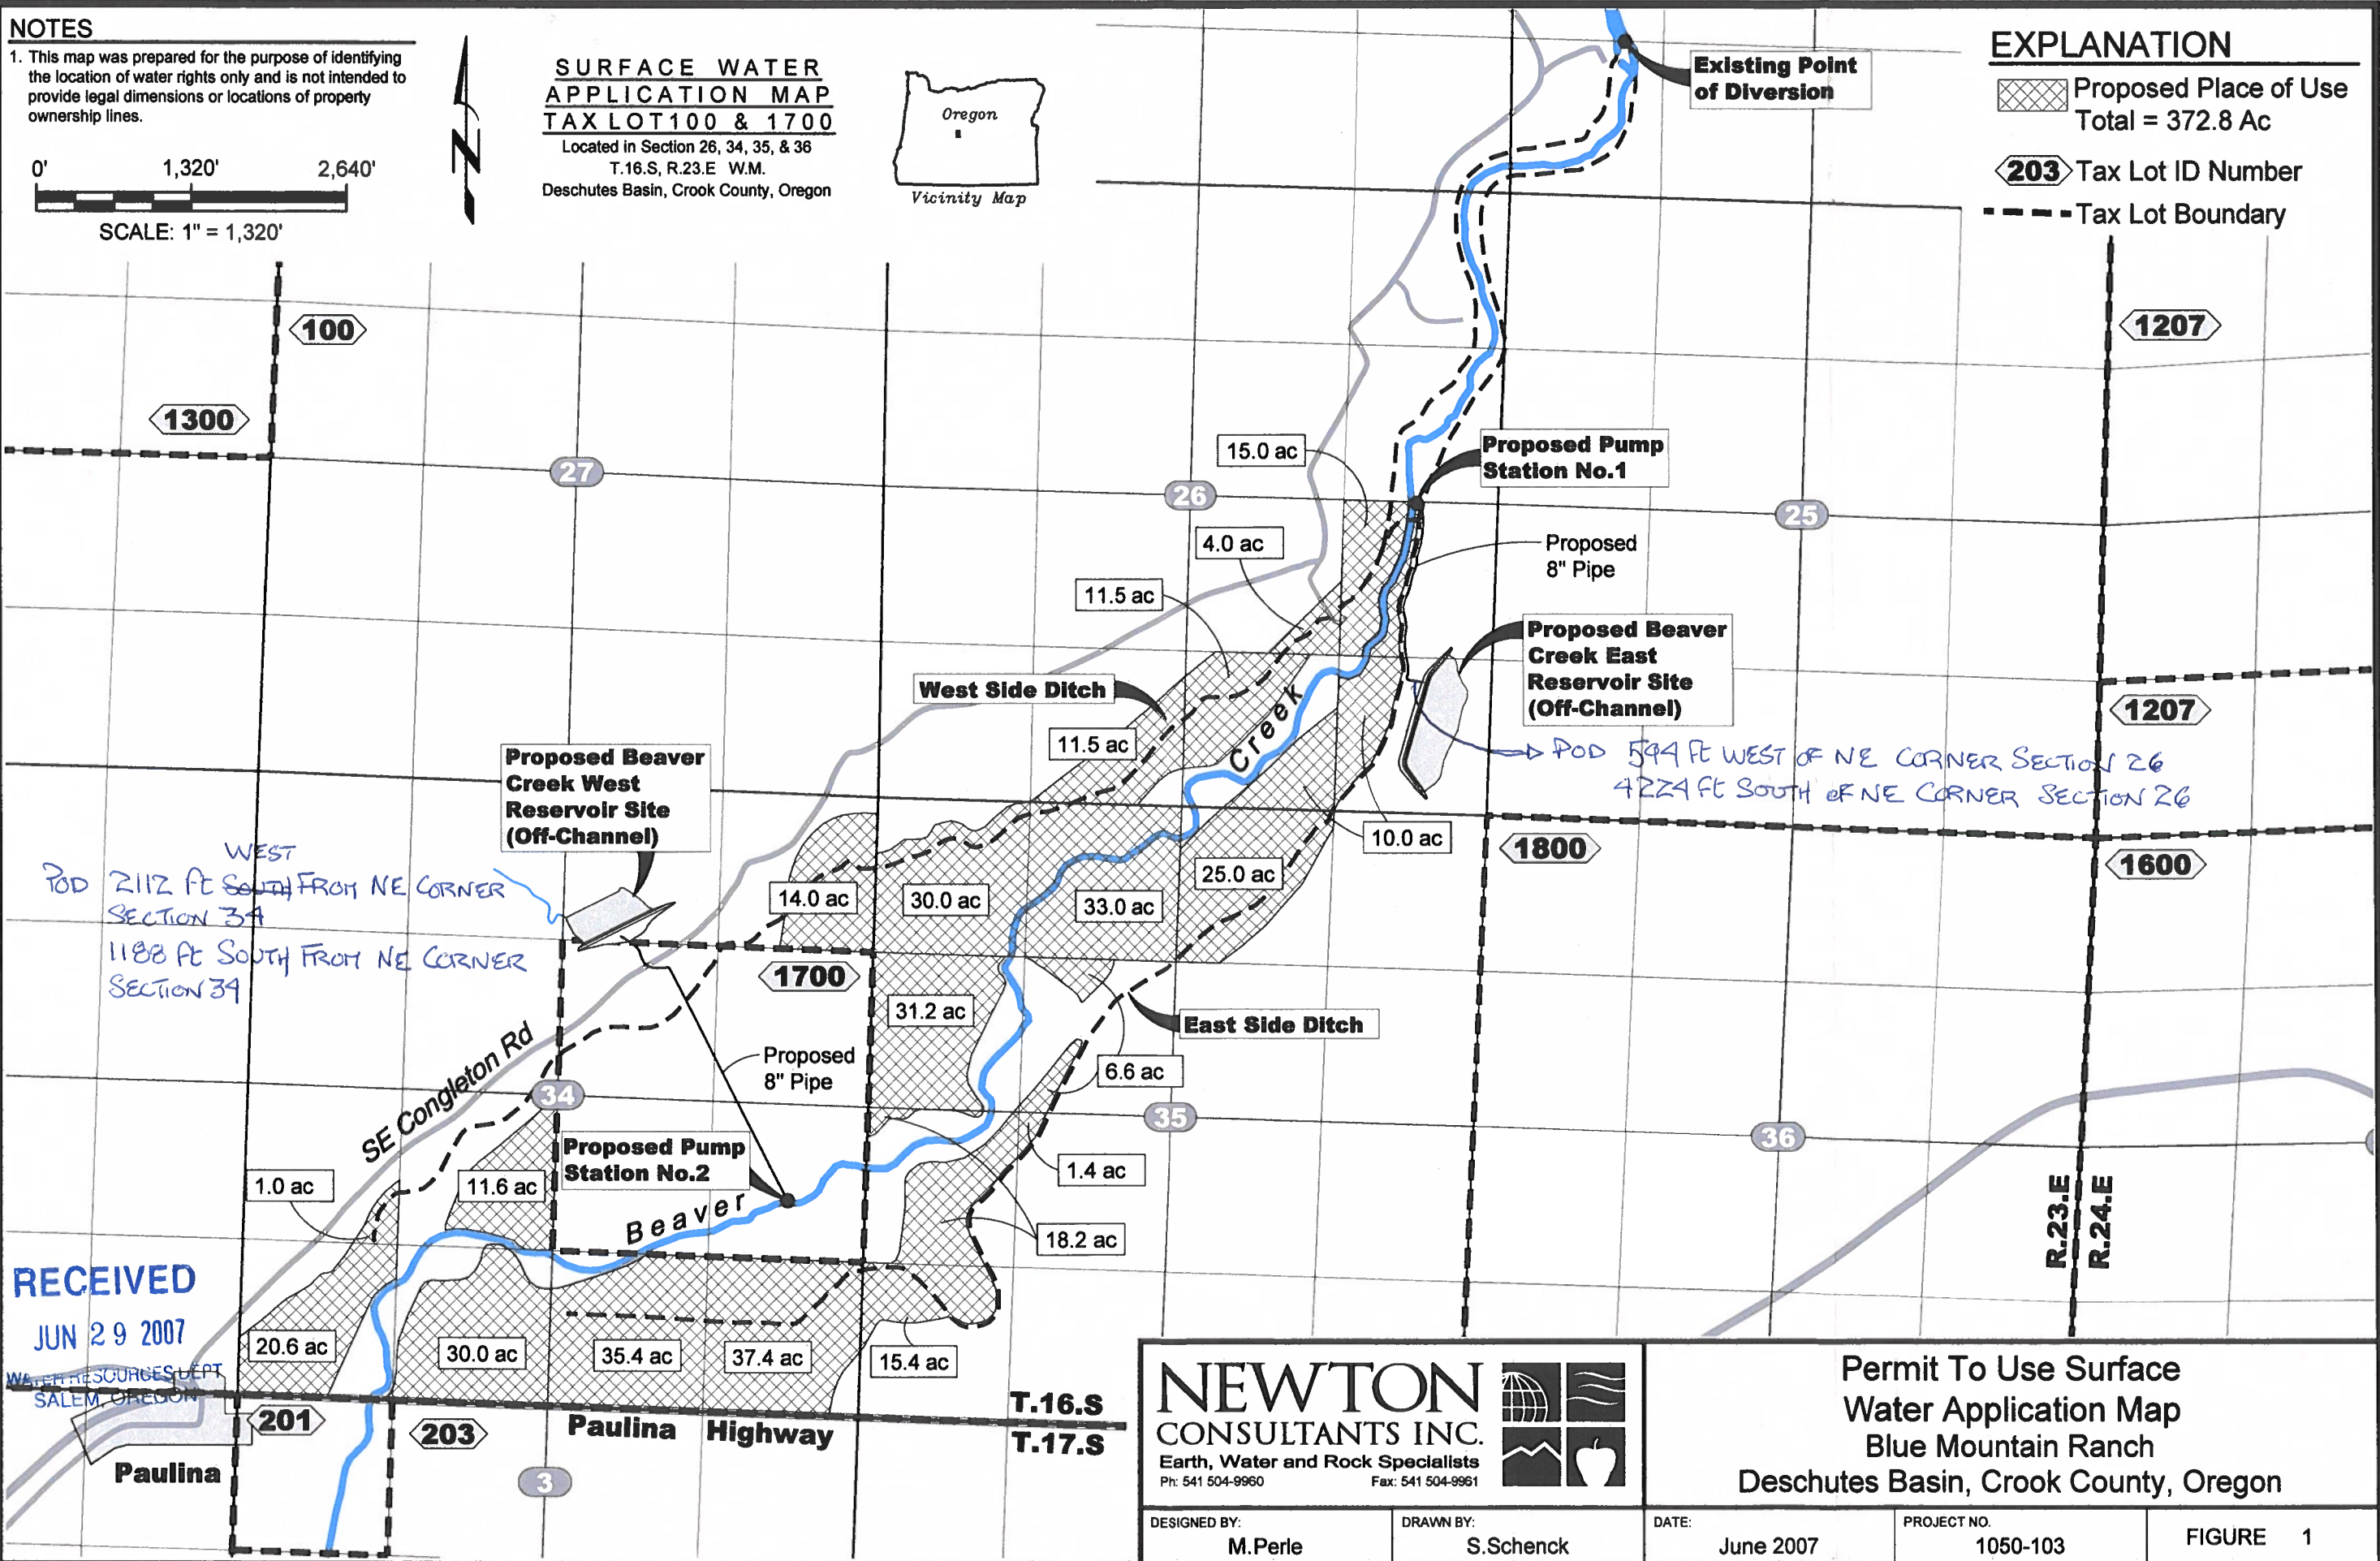

G:\1000\1050\103\Cad\Water\W1050103_F1_WrRight 10:00 06/29/2007 SS

RECEIVED
JUN 29 2007
WATER RESOURCES DEPT
SALEM, OREGON

NEWTON CONSULTANTS INC.
Earth, Water and Rock Specialists
Ph: 541 504-9960 Fax: 541 504-9961

Permit To Use Surface Water Application Map
Blue Mountain Ranch
Deschutes Basin, Crook County, Oregon

DESIGNED BY: M.Perle	DRAWN BY: S.Schenck	DATE: June 2007	PROJECT NO. 1050-103	FIGURE 1
--------------------------------	-------------------------------	---------------------------	--------------------------------	--------------------

C-210921