

Niklas C. White
 NIKLAS C. WHITE
 JUNE 12, 2013
 STATE OF OREGON

- Legend**
- PLSS corner
 - ▲ Weir
 - Pipelines/canals
 - ▭ Full pool outline
 - ▭ Tax parcels
 - ▭ Section line
 - ▭ Qtr-qtr sections

WPN Watershed Professionals Network, LLC
 Map date: 5/7/2016

Source: Esri, DigitalGlobe, GeoEye, Earthstar Geographics, CNES/Airbus DS, USDA, USGS, AEX, Getmapping, Aerogrid, IGN, IGP, Swisstopo, and the GIS User Community

RECEIVED

MAY 23 2016

S-00222


OWHD

APR 21 2016
OWRD

RECEIVED

CERTIFIED WATER RIGHT EXAMINER
3525C WRE
NIKLAS CHRISTENSEN
JUNE 13, 2013
STATE OF OREGON

Section 4
High Line pipe
Certificate 85974

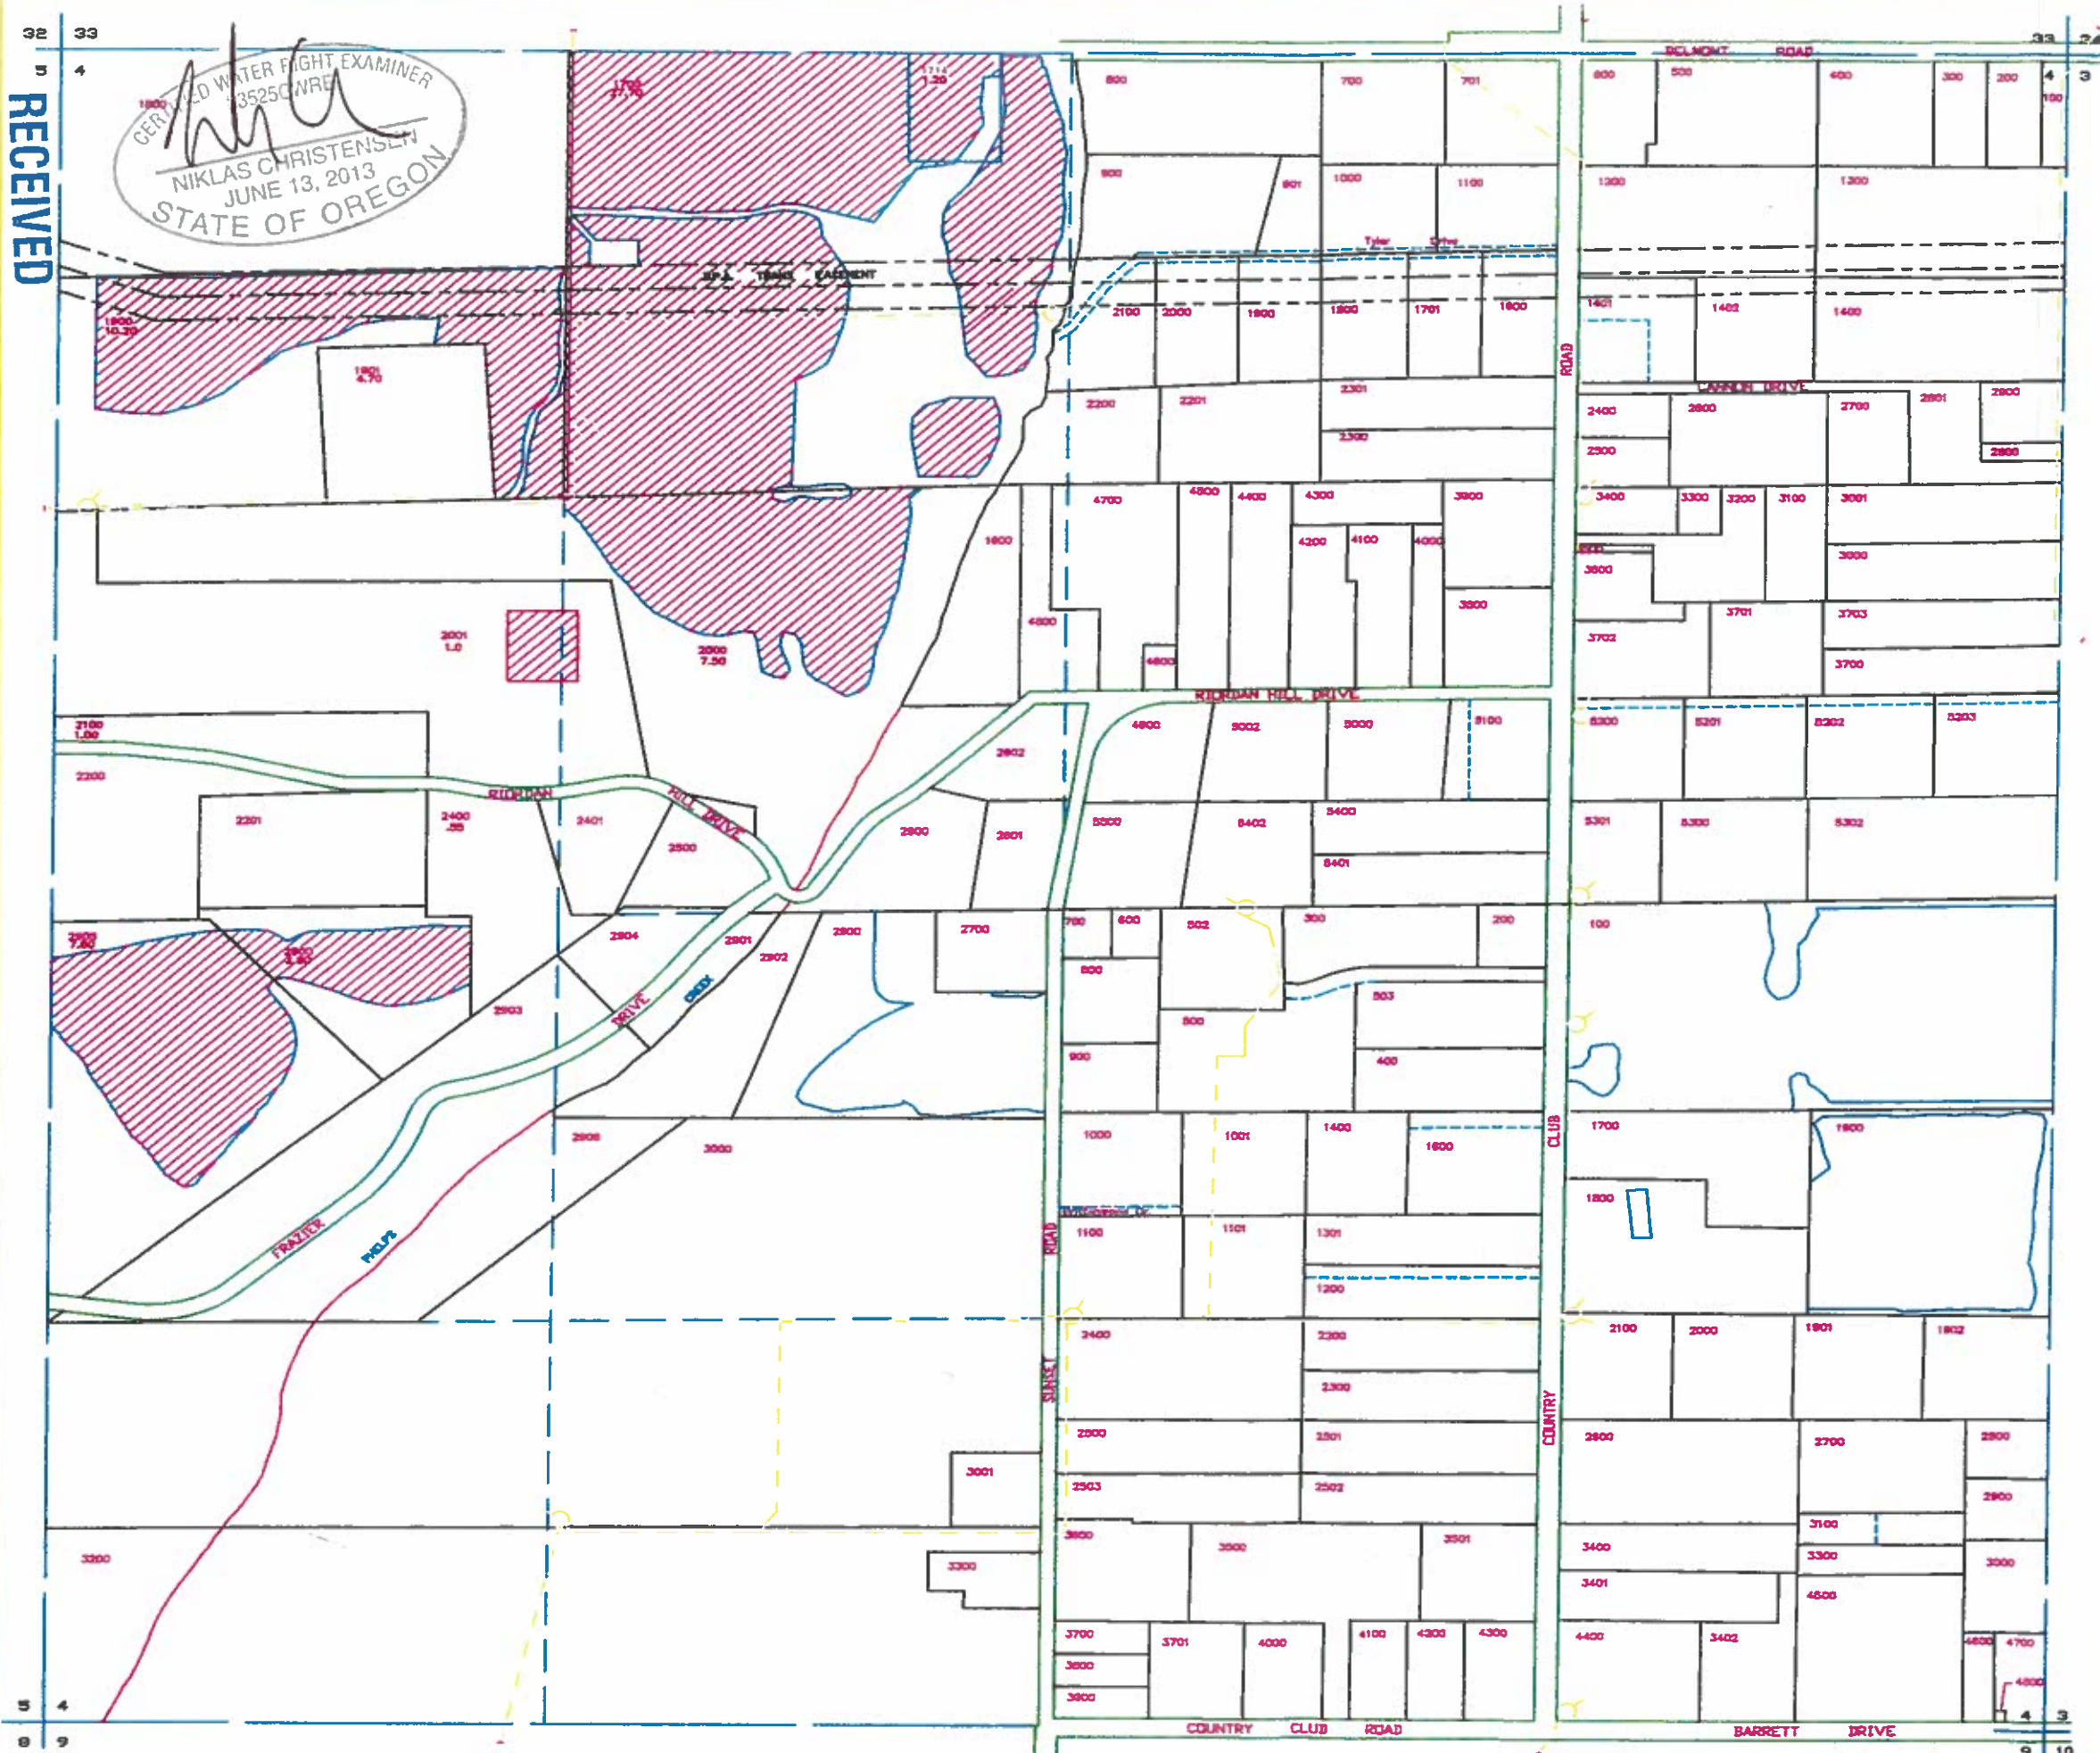

MAP SYMBOL LEGEND

- SECTION LINE
- DISTRICT BOUNDARY
- QTR-SECTION LINE
- PROPERTY LINE
- RIGHT OF WAY
- PRIVATE ROAD
- DLC LINE
- EASEMENT
- RIVER
- CANAL
- CREEK
- B.P.A. EASEMENT
- PIPE
- PENSTOCK
- OPEN DITCH
- TURNOUT BOX
- PUMP FROM FARMERS DITCH

WATER RIGHTS CERTIFICATES LEGEND



2016
Supplemental
Upper Reservoir
water on map,
under the
primary layer.

RECEIVED
MAY 23 2016
OWRD

FARMERS IRRIGATION DISTRICT
HOOD RIVER OREGON
SECTION 4 T2N R10E
REVISION DATE: March 10, 2016



SCALE: 1" = 400'

5-88232

Section 5
High Line &
Rainy Creek
Certificate
85974 &
76230

CERTIFIED WATER RIGHT
1854 SCWRE
NIKLAS CHRISTENSEN
JUNE 13, 2013
STATE OF OREGON

MAP SYMBOL LEGEND	
	SECTION LINE
	DISTRICT BOUNDARY
	QTR-SECTION LINE
	PROPERTY LINE
	RIGHT OF WAY
	PRIVATE ROAD
	DLC LINE
	EASEMENT
	RIVER
	CANAL
	CREEK
	B.P.A. EASEMENT
	PIPE
	PENSTOCK
	OPEN DITCH
	TURNOUT BOX

WATER RIGHTS CERTIFICATES LEGEND

2016 Supplemental Upper Reservoir water ON map, under the Primary layer of all properties.


RECEIVED
MAY 23 2016
OWRD

FARMERS IRRIGATION DISTRICT
HOOD RIVER OREGON
SECTION 5 T2N R10E
REVISION DATE: March 10, 2016



SCALE: 1" = 400'

588252

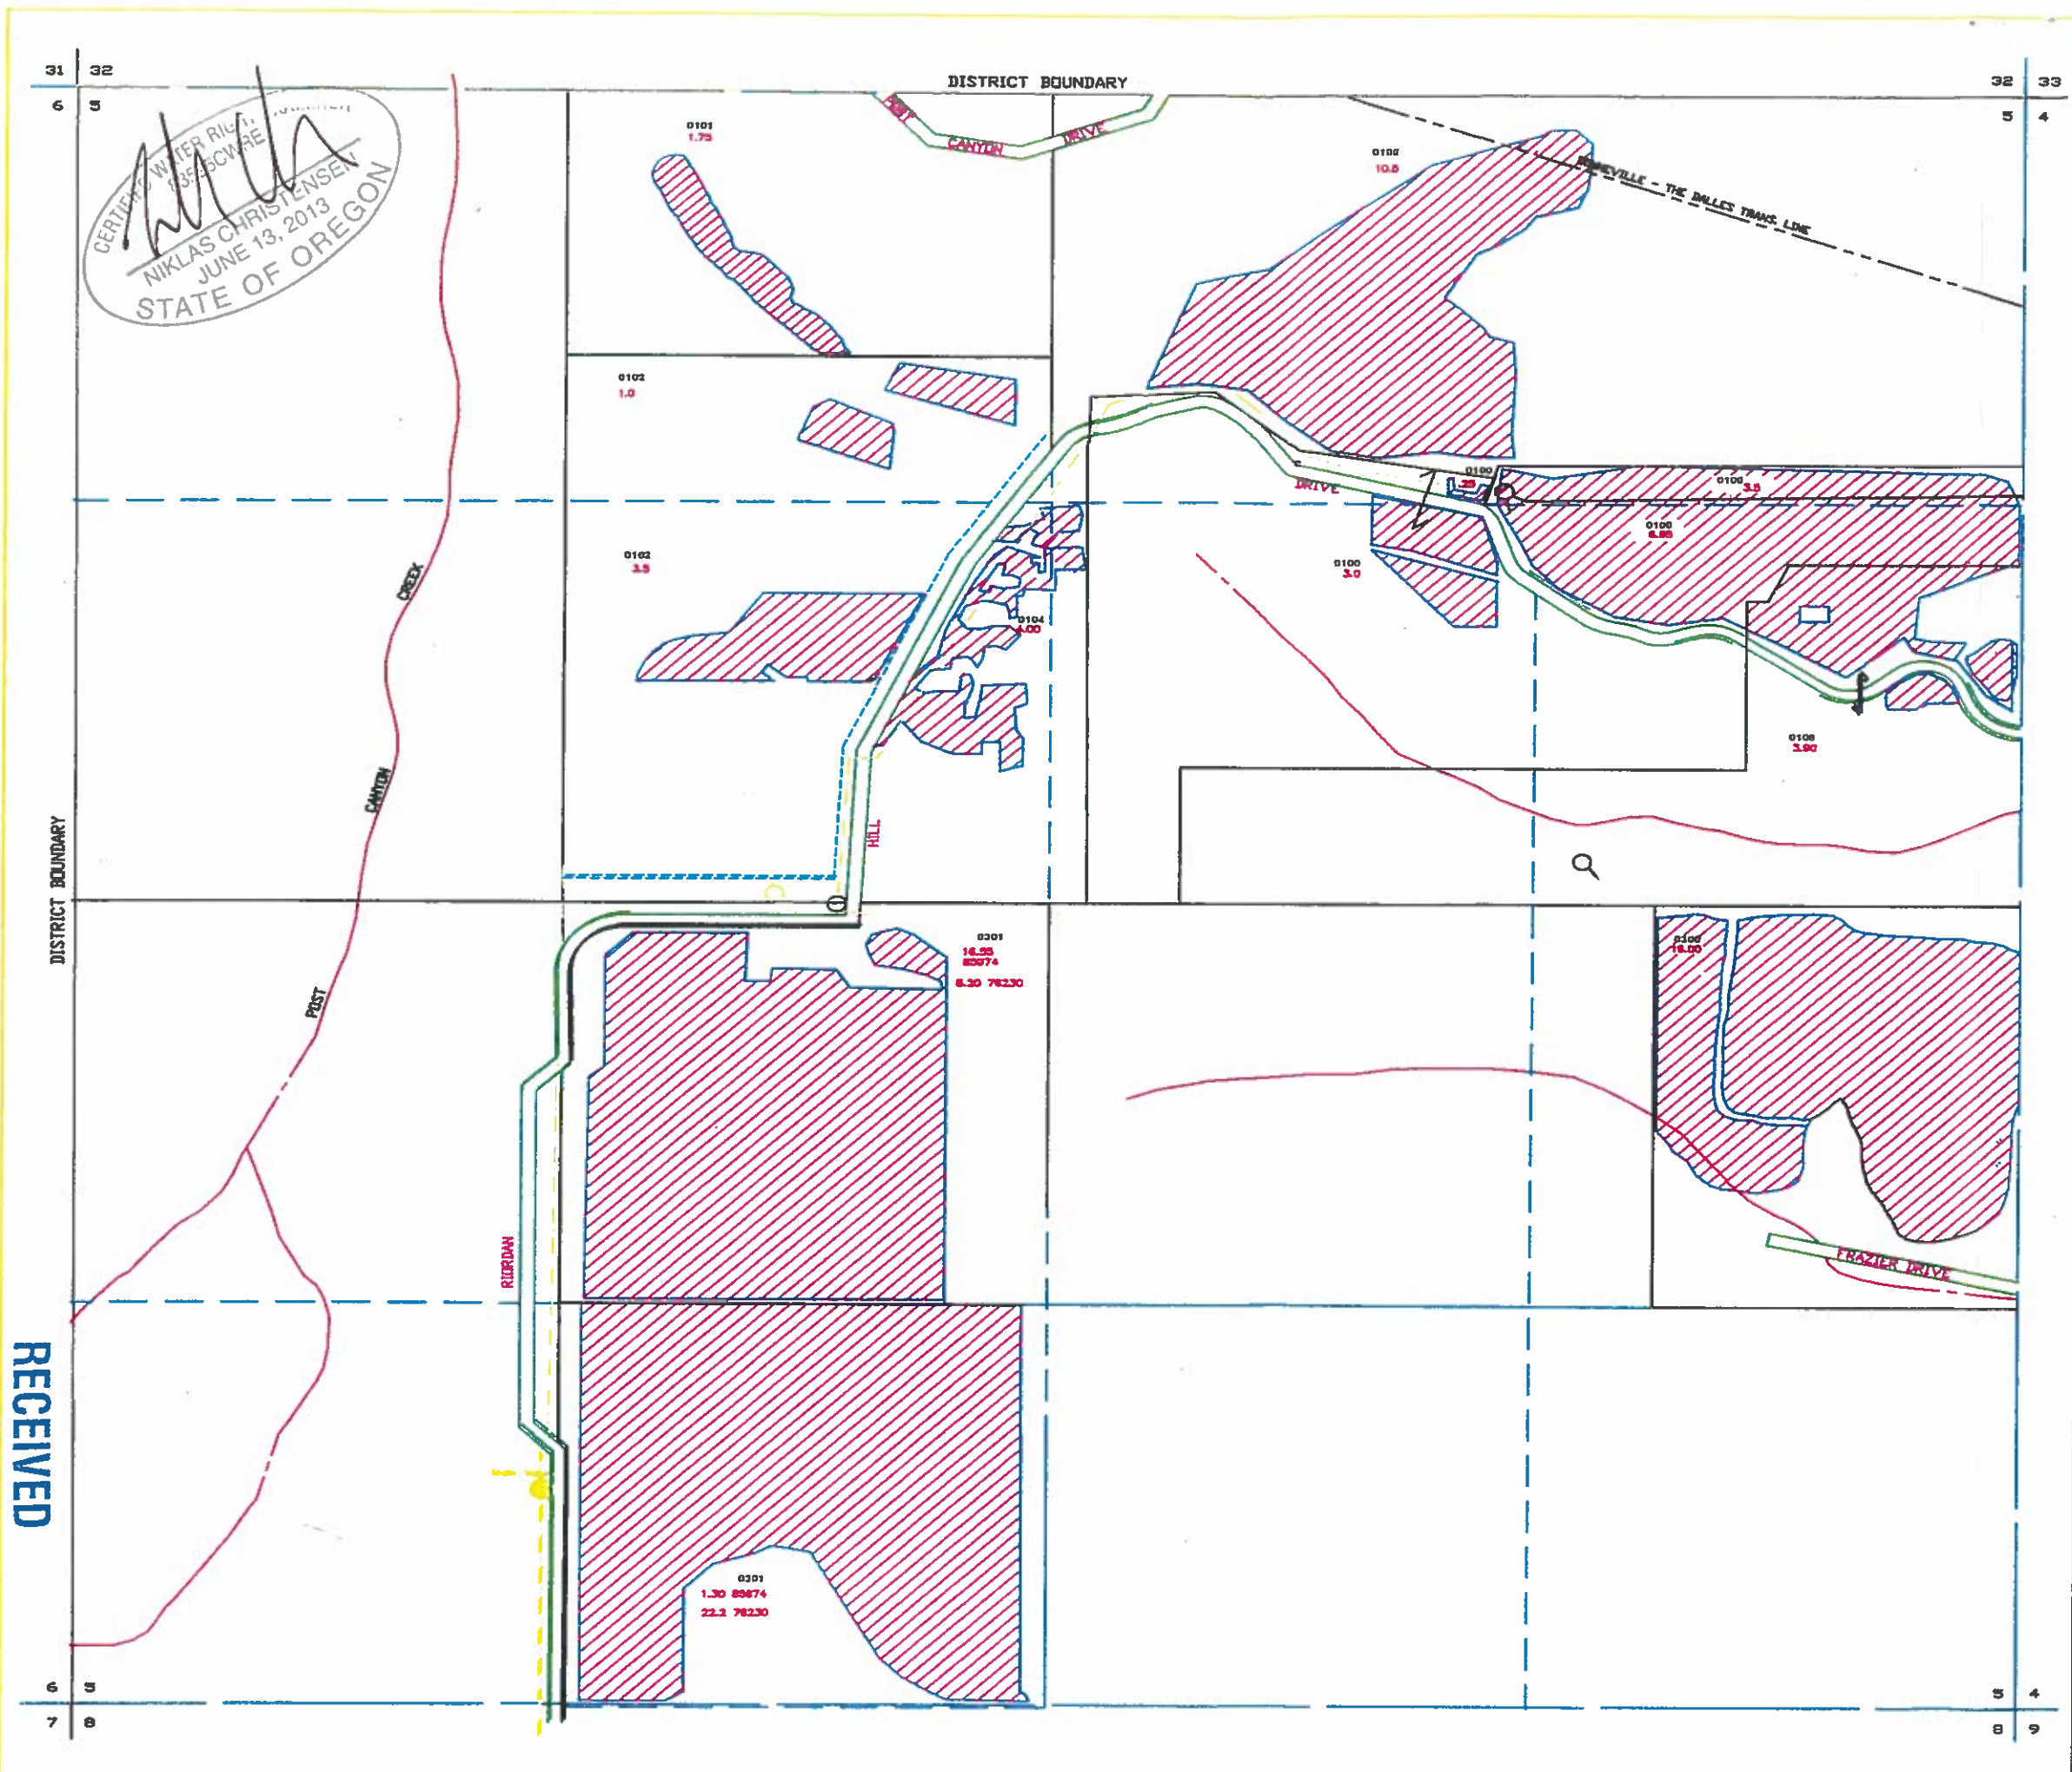

RECEIVED
APR 21 2016
OWPRD

Section 8
Rainy Creek
76230

CERTIFIED WATER RIGHT EXAMINER
35250 WFE
Mark
NIKLAS CHRISTENSEN
JUNE 13, 2013
STATE OF OREGON




MAP SYMBOL LEGEND

	SECTION LINE
	DISTRICT BOUNDARY
	QTR-SECTION LINE
	PROPERTY LINE
	RIGHT OF WAY
	PRIVATE ROAD
	DLC LINE
	EASEMENT
	RIVER
	CANAL
	CREEK
	B.P.A. EASEMENT
	PIPE
	PENSTOCK
	OPEN DITCH
	TURNOUT BOX
	HOUSE

WATER RIGHT PERMIT LEGEND

2016 Supplemental Upper Reservoir On Map under the primary layer.

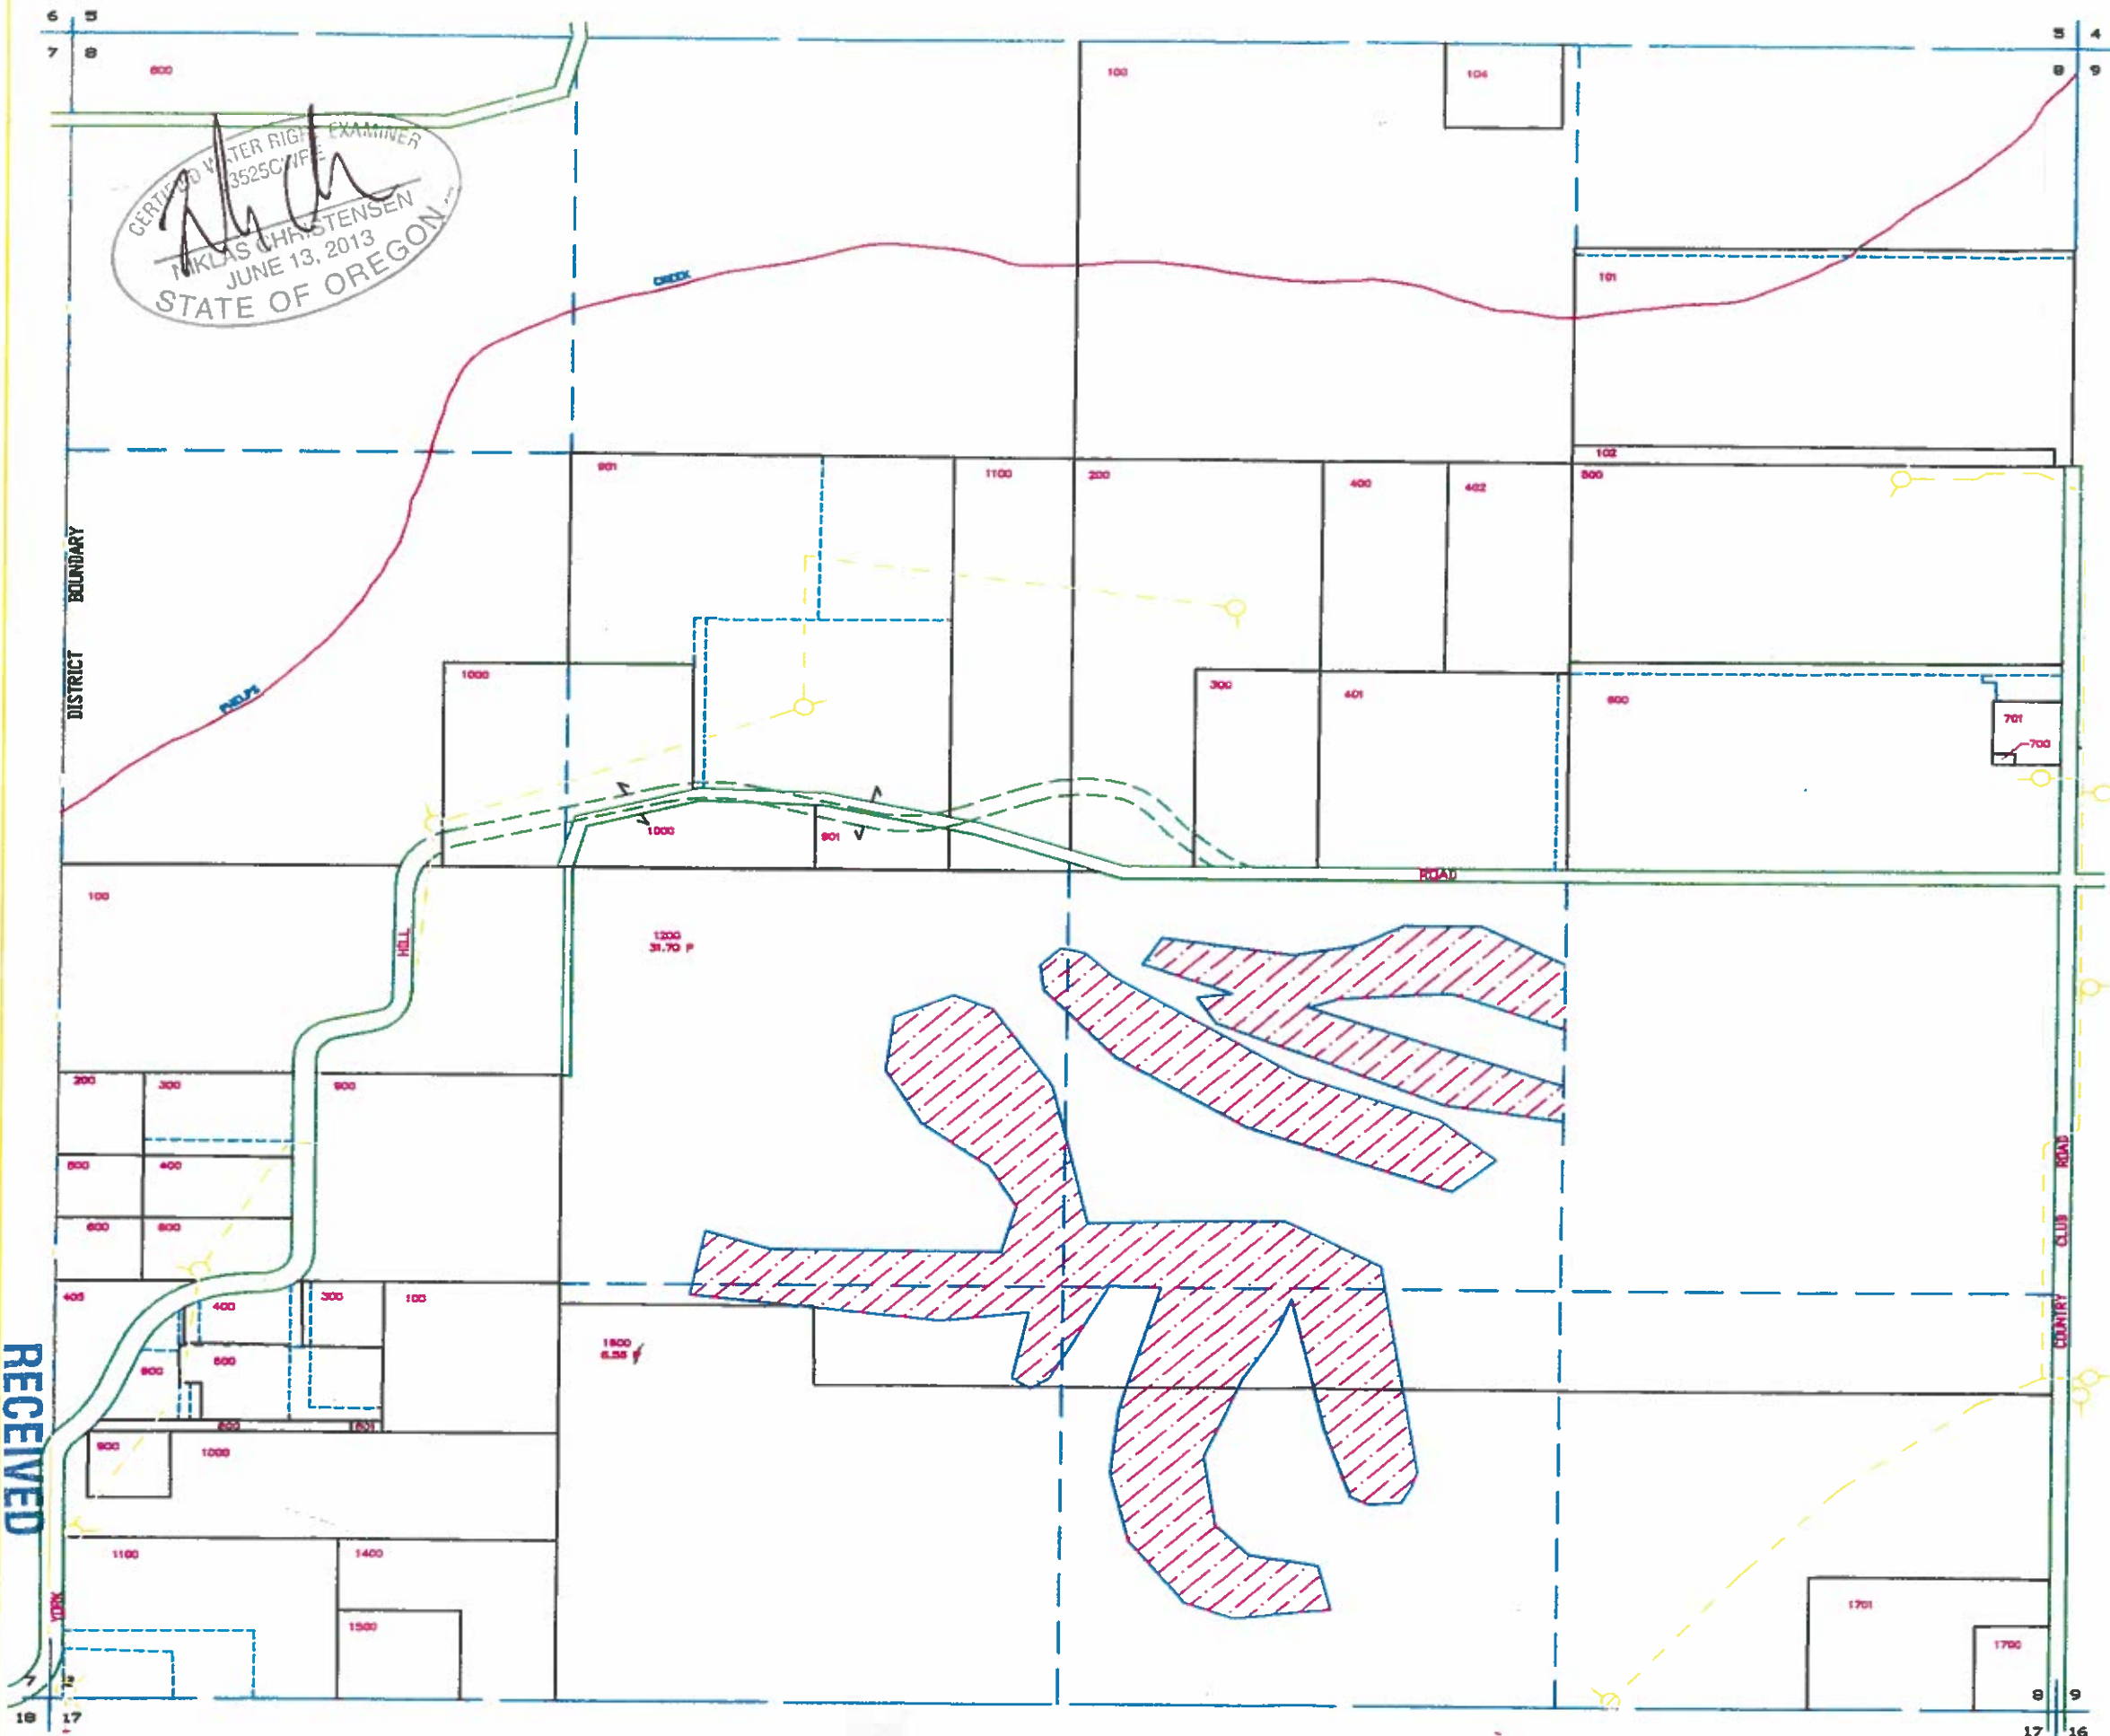

RECEIVED
APR 21 2016
OWWRD

RECEIVED
MAY 23 2016
OWRL

FARMERS IRRIGATION DISTRICT
HOOD RIVER OREGON
SECTION 8 T2N R10E
REVISION DATE: March 10, 2016



SCALE: 1" = 400' Sheet 5 of 11

R-88232

Section 8 High Line Cert 85974



MAP SYMBOL LEGEND

- SECTION LINE
- DISTRICT BOUNDARY
- QTR-SECTION LINE
- PROPERTY LINE
- RIGHT OF WAY
- PRIVATE ROAD
- DLC LINE
- EASEMENT
- RIVER
- CANAL
- CREEK
- B.P.A. EASEMENT
- PIPE
- PENSTOCK
- OPEN DITCH
- TURNOUT BOX
- PUMP FROM FARMERS DITCH

WATER RIGHTS CERTIFICATES LEGEND



2016 Supplemental Upper Reservoir water ON, Under the primary water right layer.

RECEIVED
MAY 23 2016
OWRL


FARMERS IRRIGATION DISTRICT
HOOD RIVER OREGON
SECTION 8 T2N R10E
REVISION DATE: March 10, 2016



SCALE: 1" = 400'

S-08222

CERTIFIED WATER RIGHT ADMIN/LE
3525CW
Niklas Christensen
NIKLAS CHRISTENSEN
JUNE 13, 2013
STATE OF OREGON

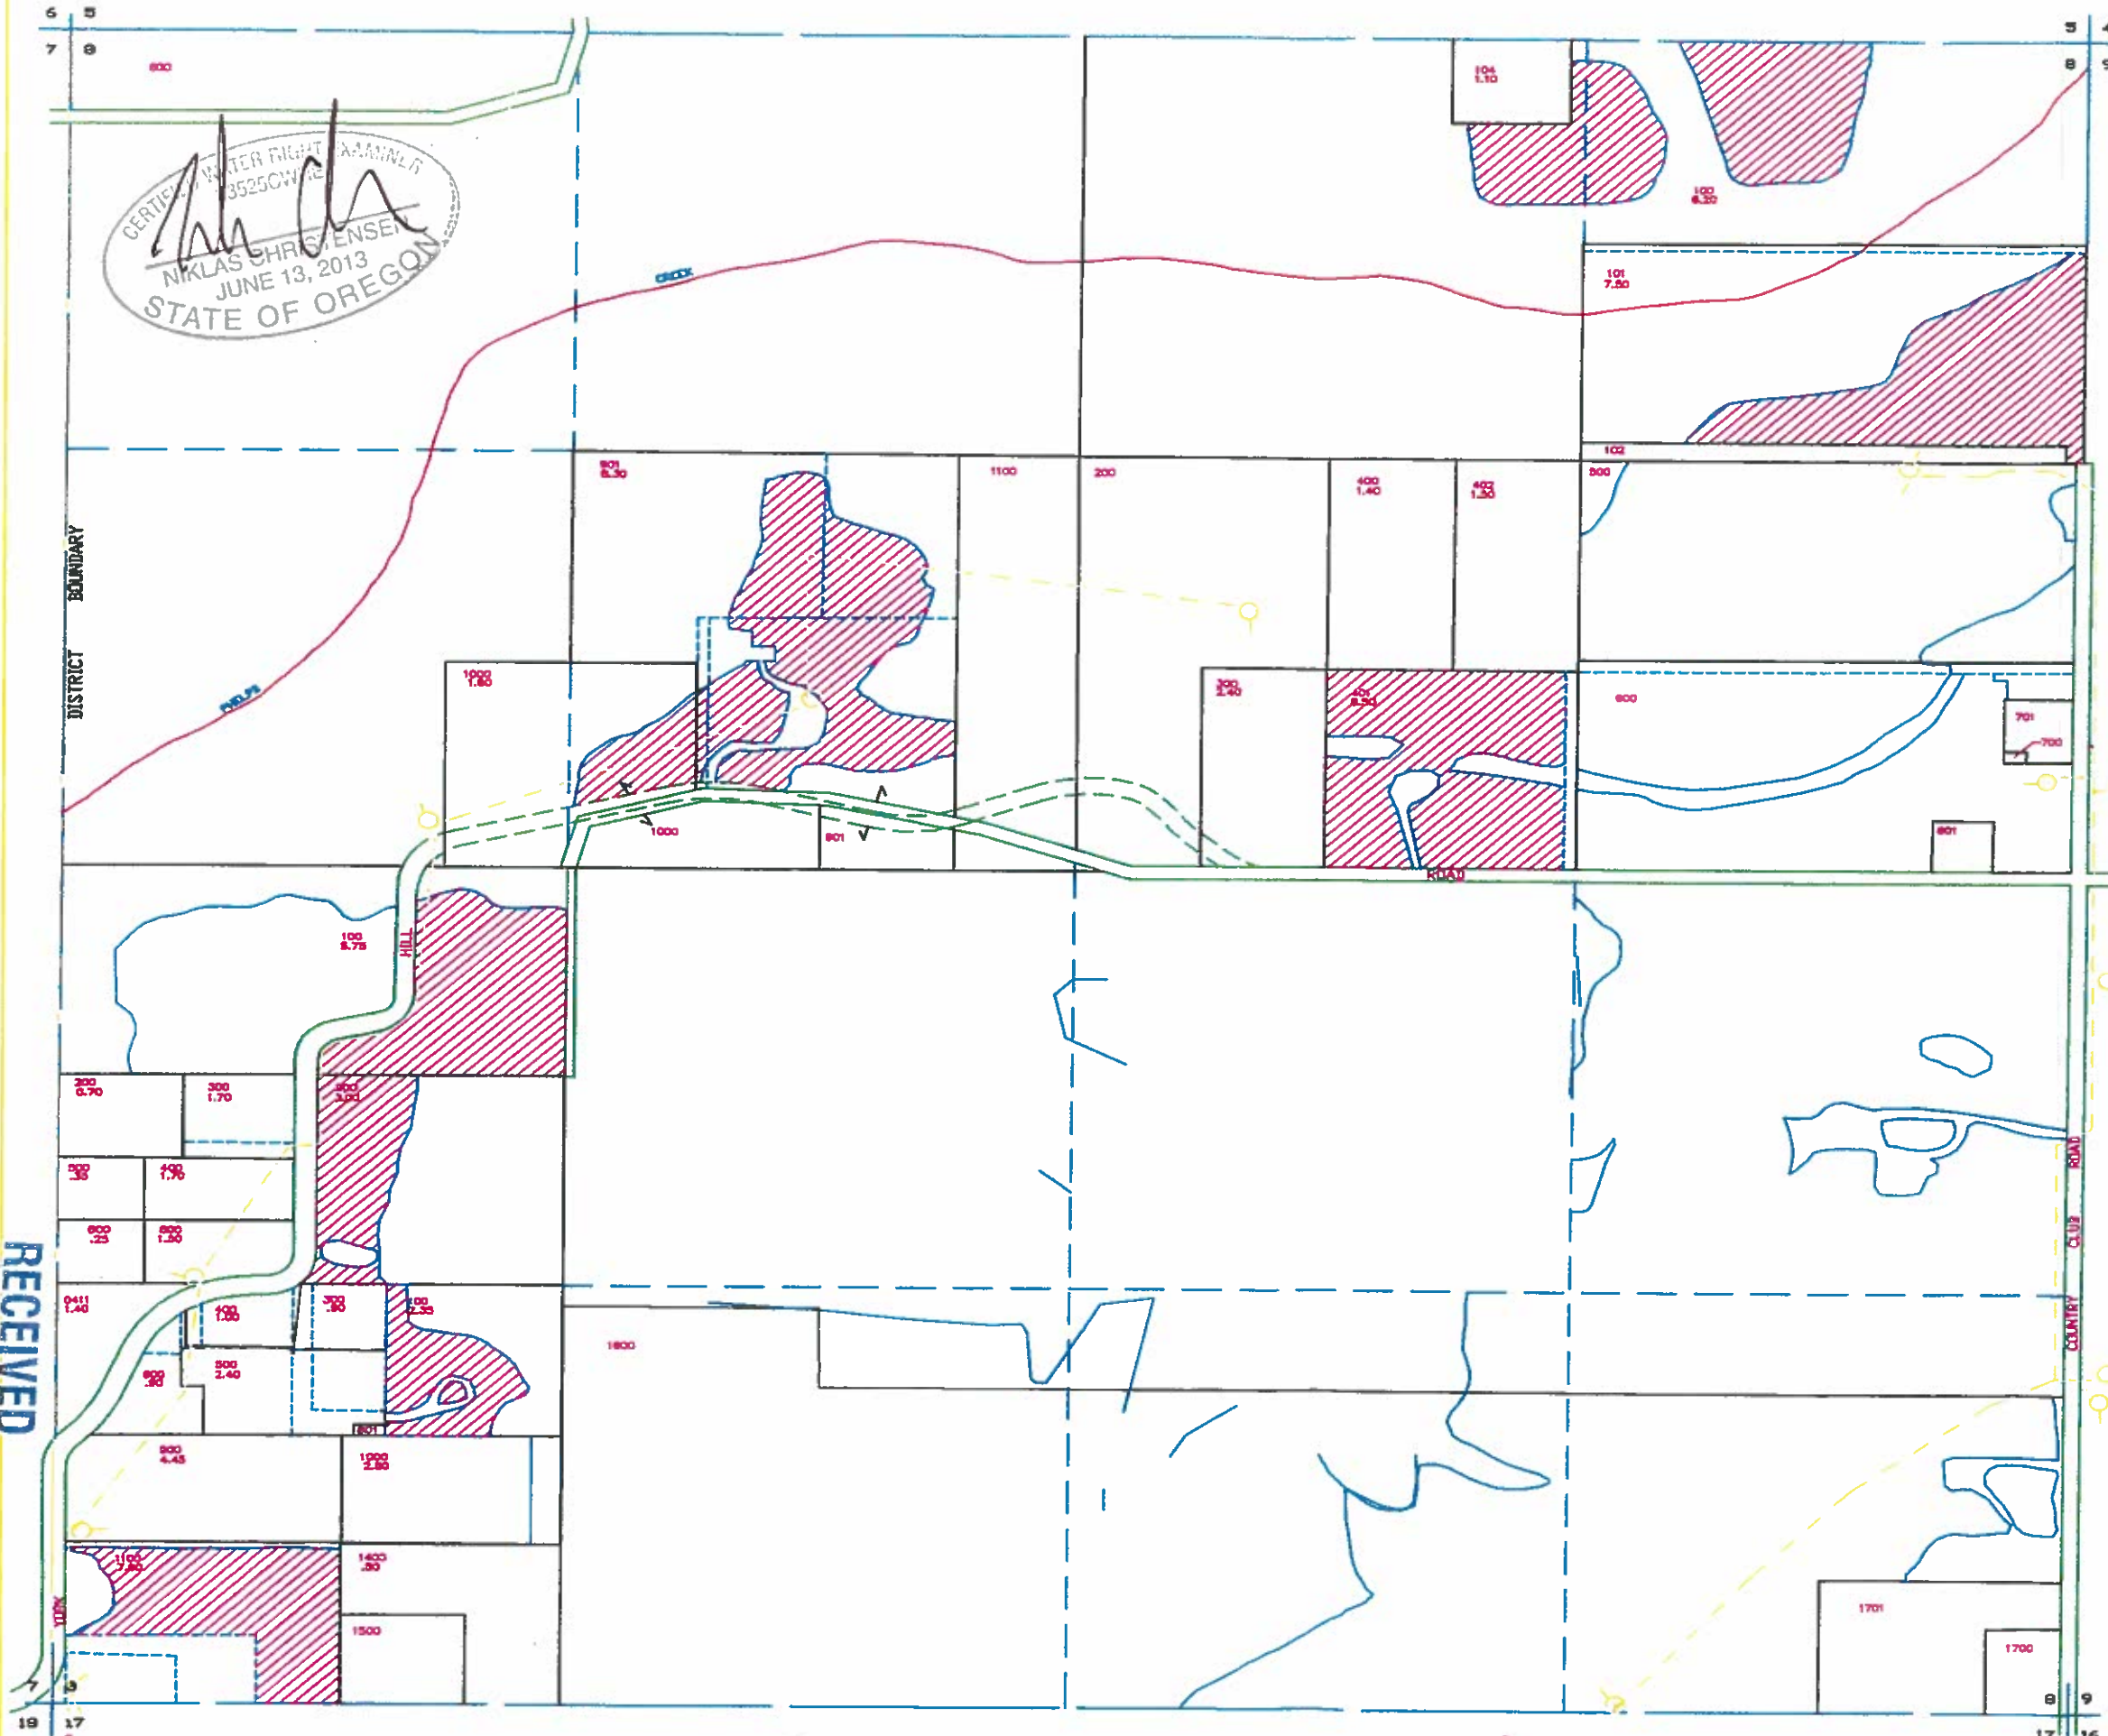


















RECEIVED

APR 21 2016
OWWRD

Section 10
Rainy Creek
Cert 76230

RECEIVED
MAY 23 2016
OWRD

MAP SYMBOL LEGEND

-  SECTION LINE
-  DISTRICT BOUNDARY
-  QTR-SECTION LINE
-  PROPERTY LINE
-  RIGHT OF WAY
-  PRIVATE ROAD
-  DLC LINE
-  EASEMENT
-  RIVER
-  CANAL
-  CREEK
-  B.P.A. EASEMENT
-  PIPE
-  PENSTOCK
-  OPEN DITCH
-  TURNOUT BOX
-  PUMP FROM FARMERS DITCH

WATER RIGHTS CERTIFICATES LEGEND




2016 Supplemental
Upper
Reservoir On Map,
under the
Primary Layer.

FARMERS IRRIGATION DISTRICT
HOOD RIVER OREGON
SECTION 10 T2N R10E
REVISION DATE: March 10, 2016

SCALE: 1" = 400'

580232

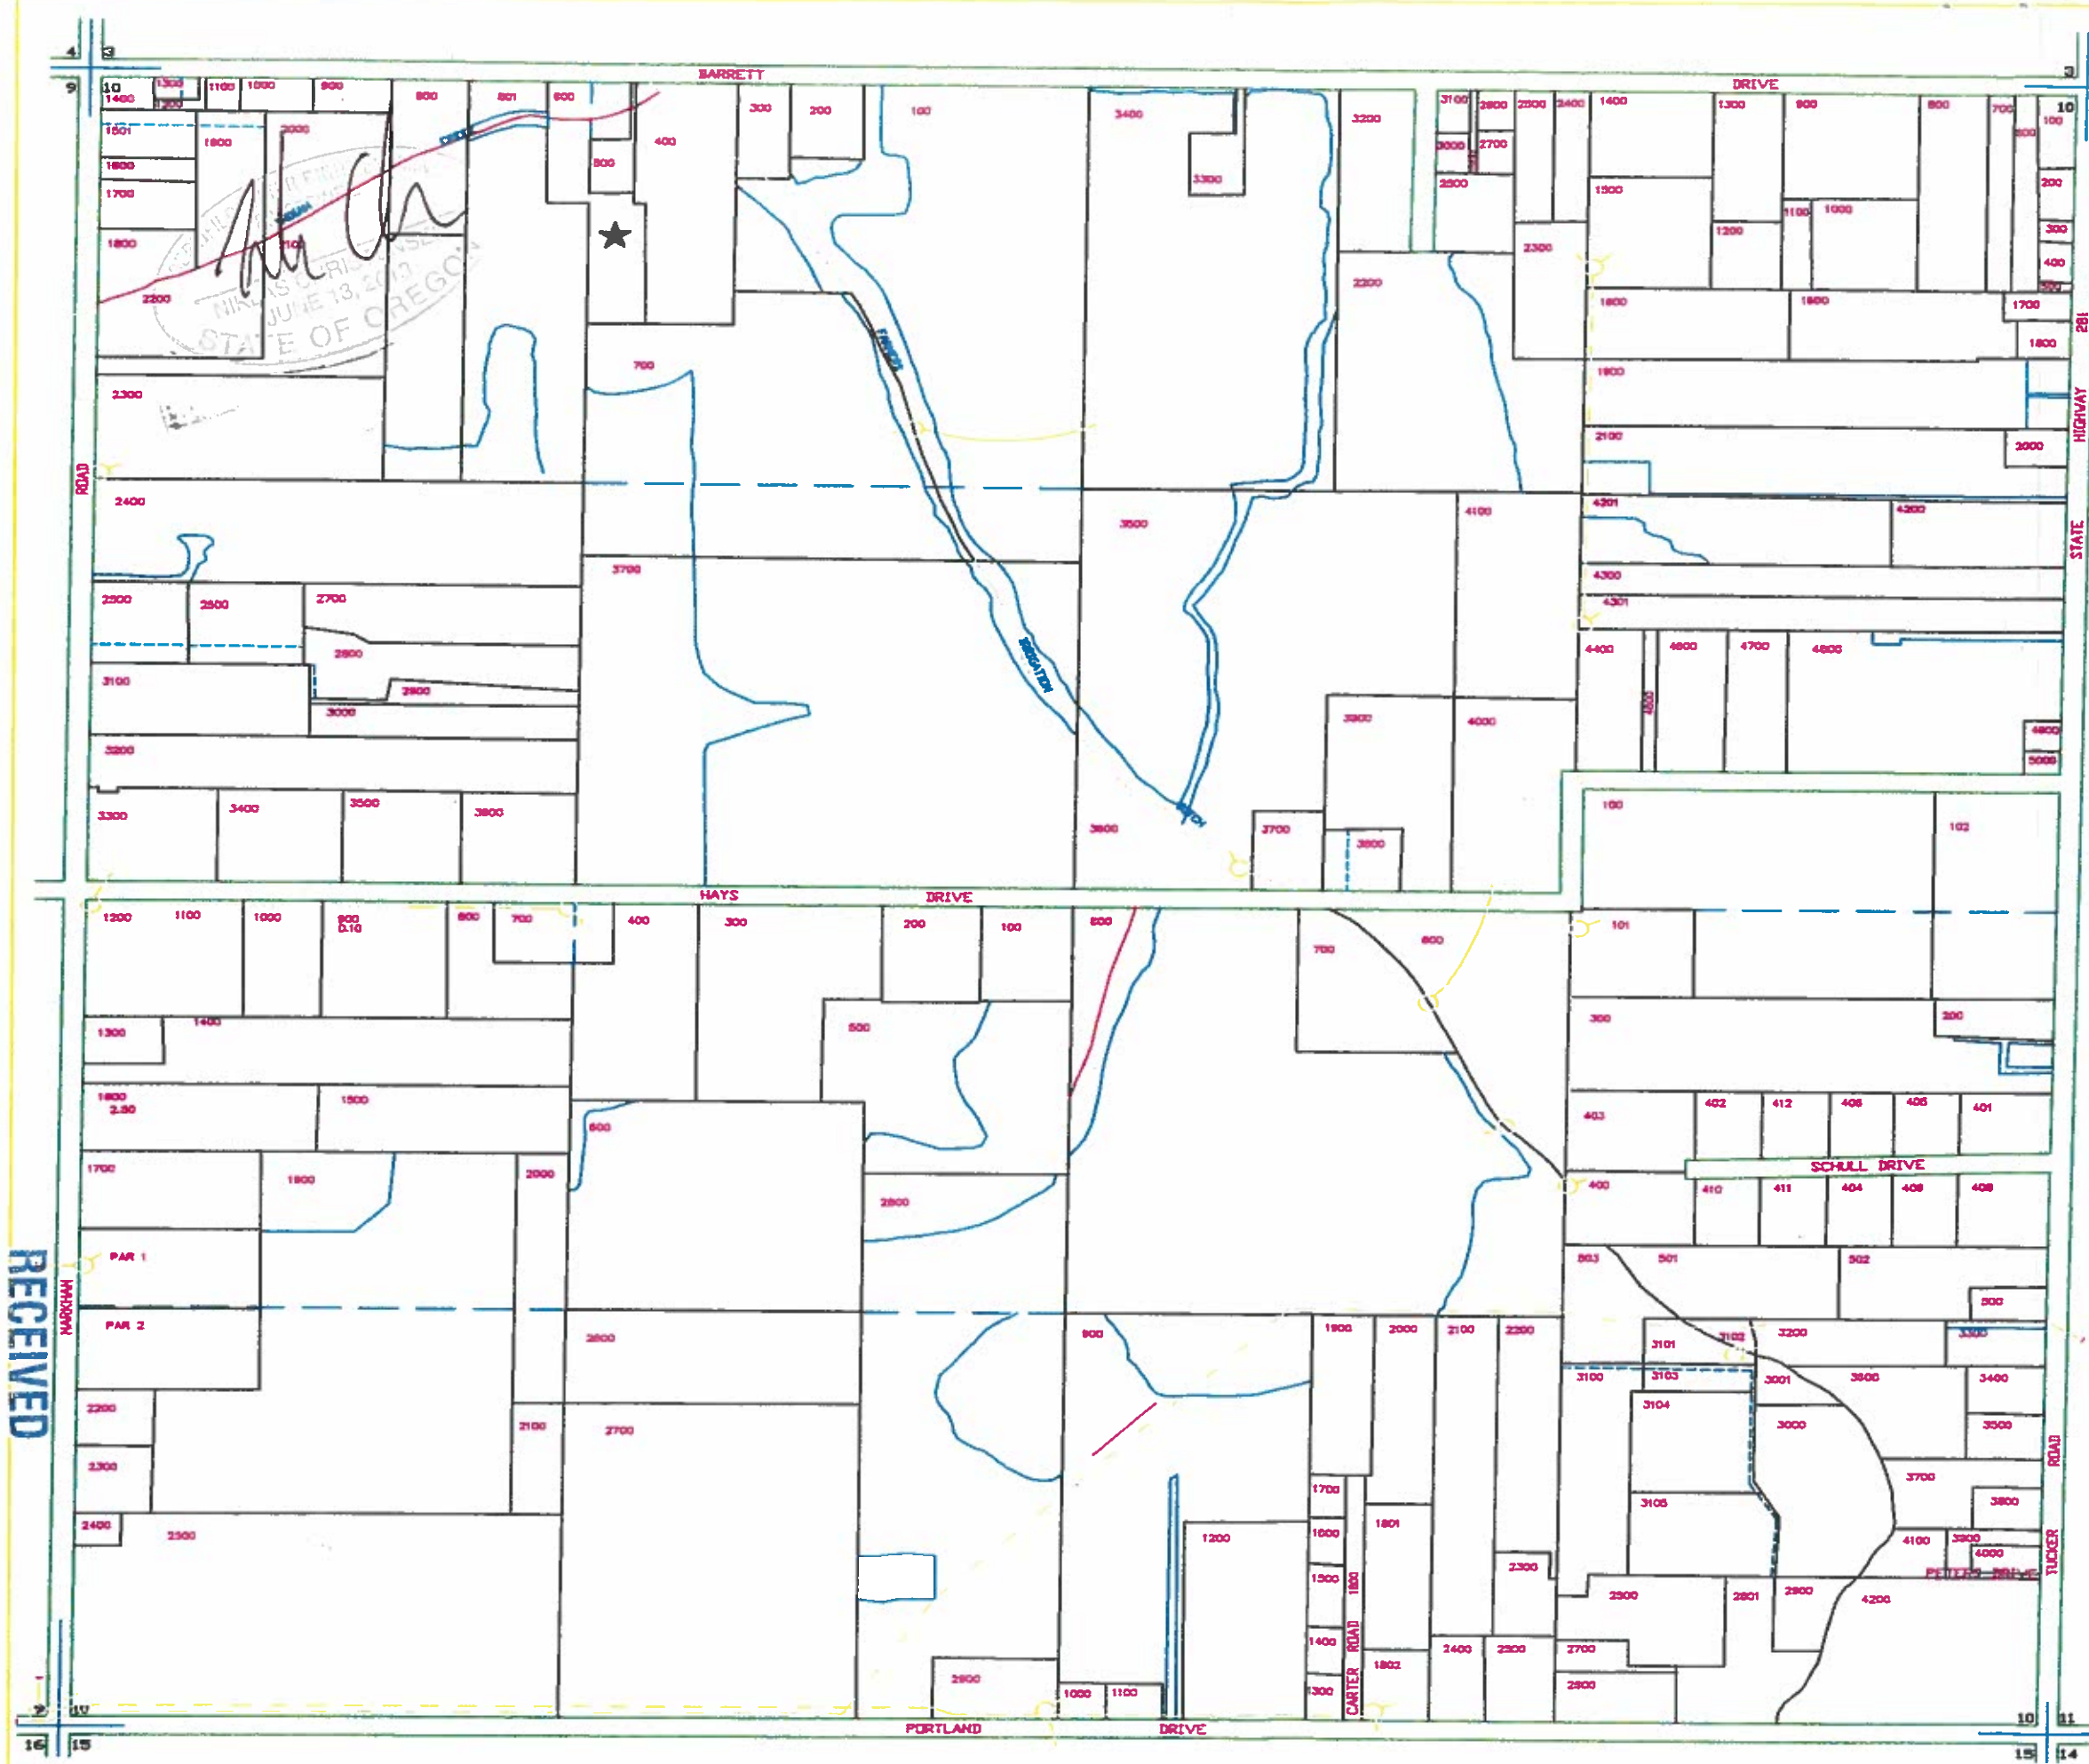


RECEIVED
APR 21 2016
OWPRD

Section 15
Rainy Creek
Cert, 76230

RECEIVED
MAY 23 2016
OWR

CERTIFIED WATER RIGHT EXAMINER
83225CV
WILLAS CHRISTENSEN
JUNE 13, 2013
STATE OF OREGON

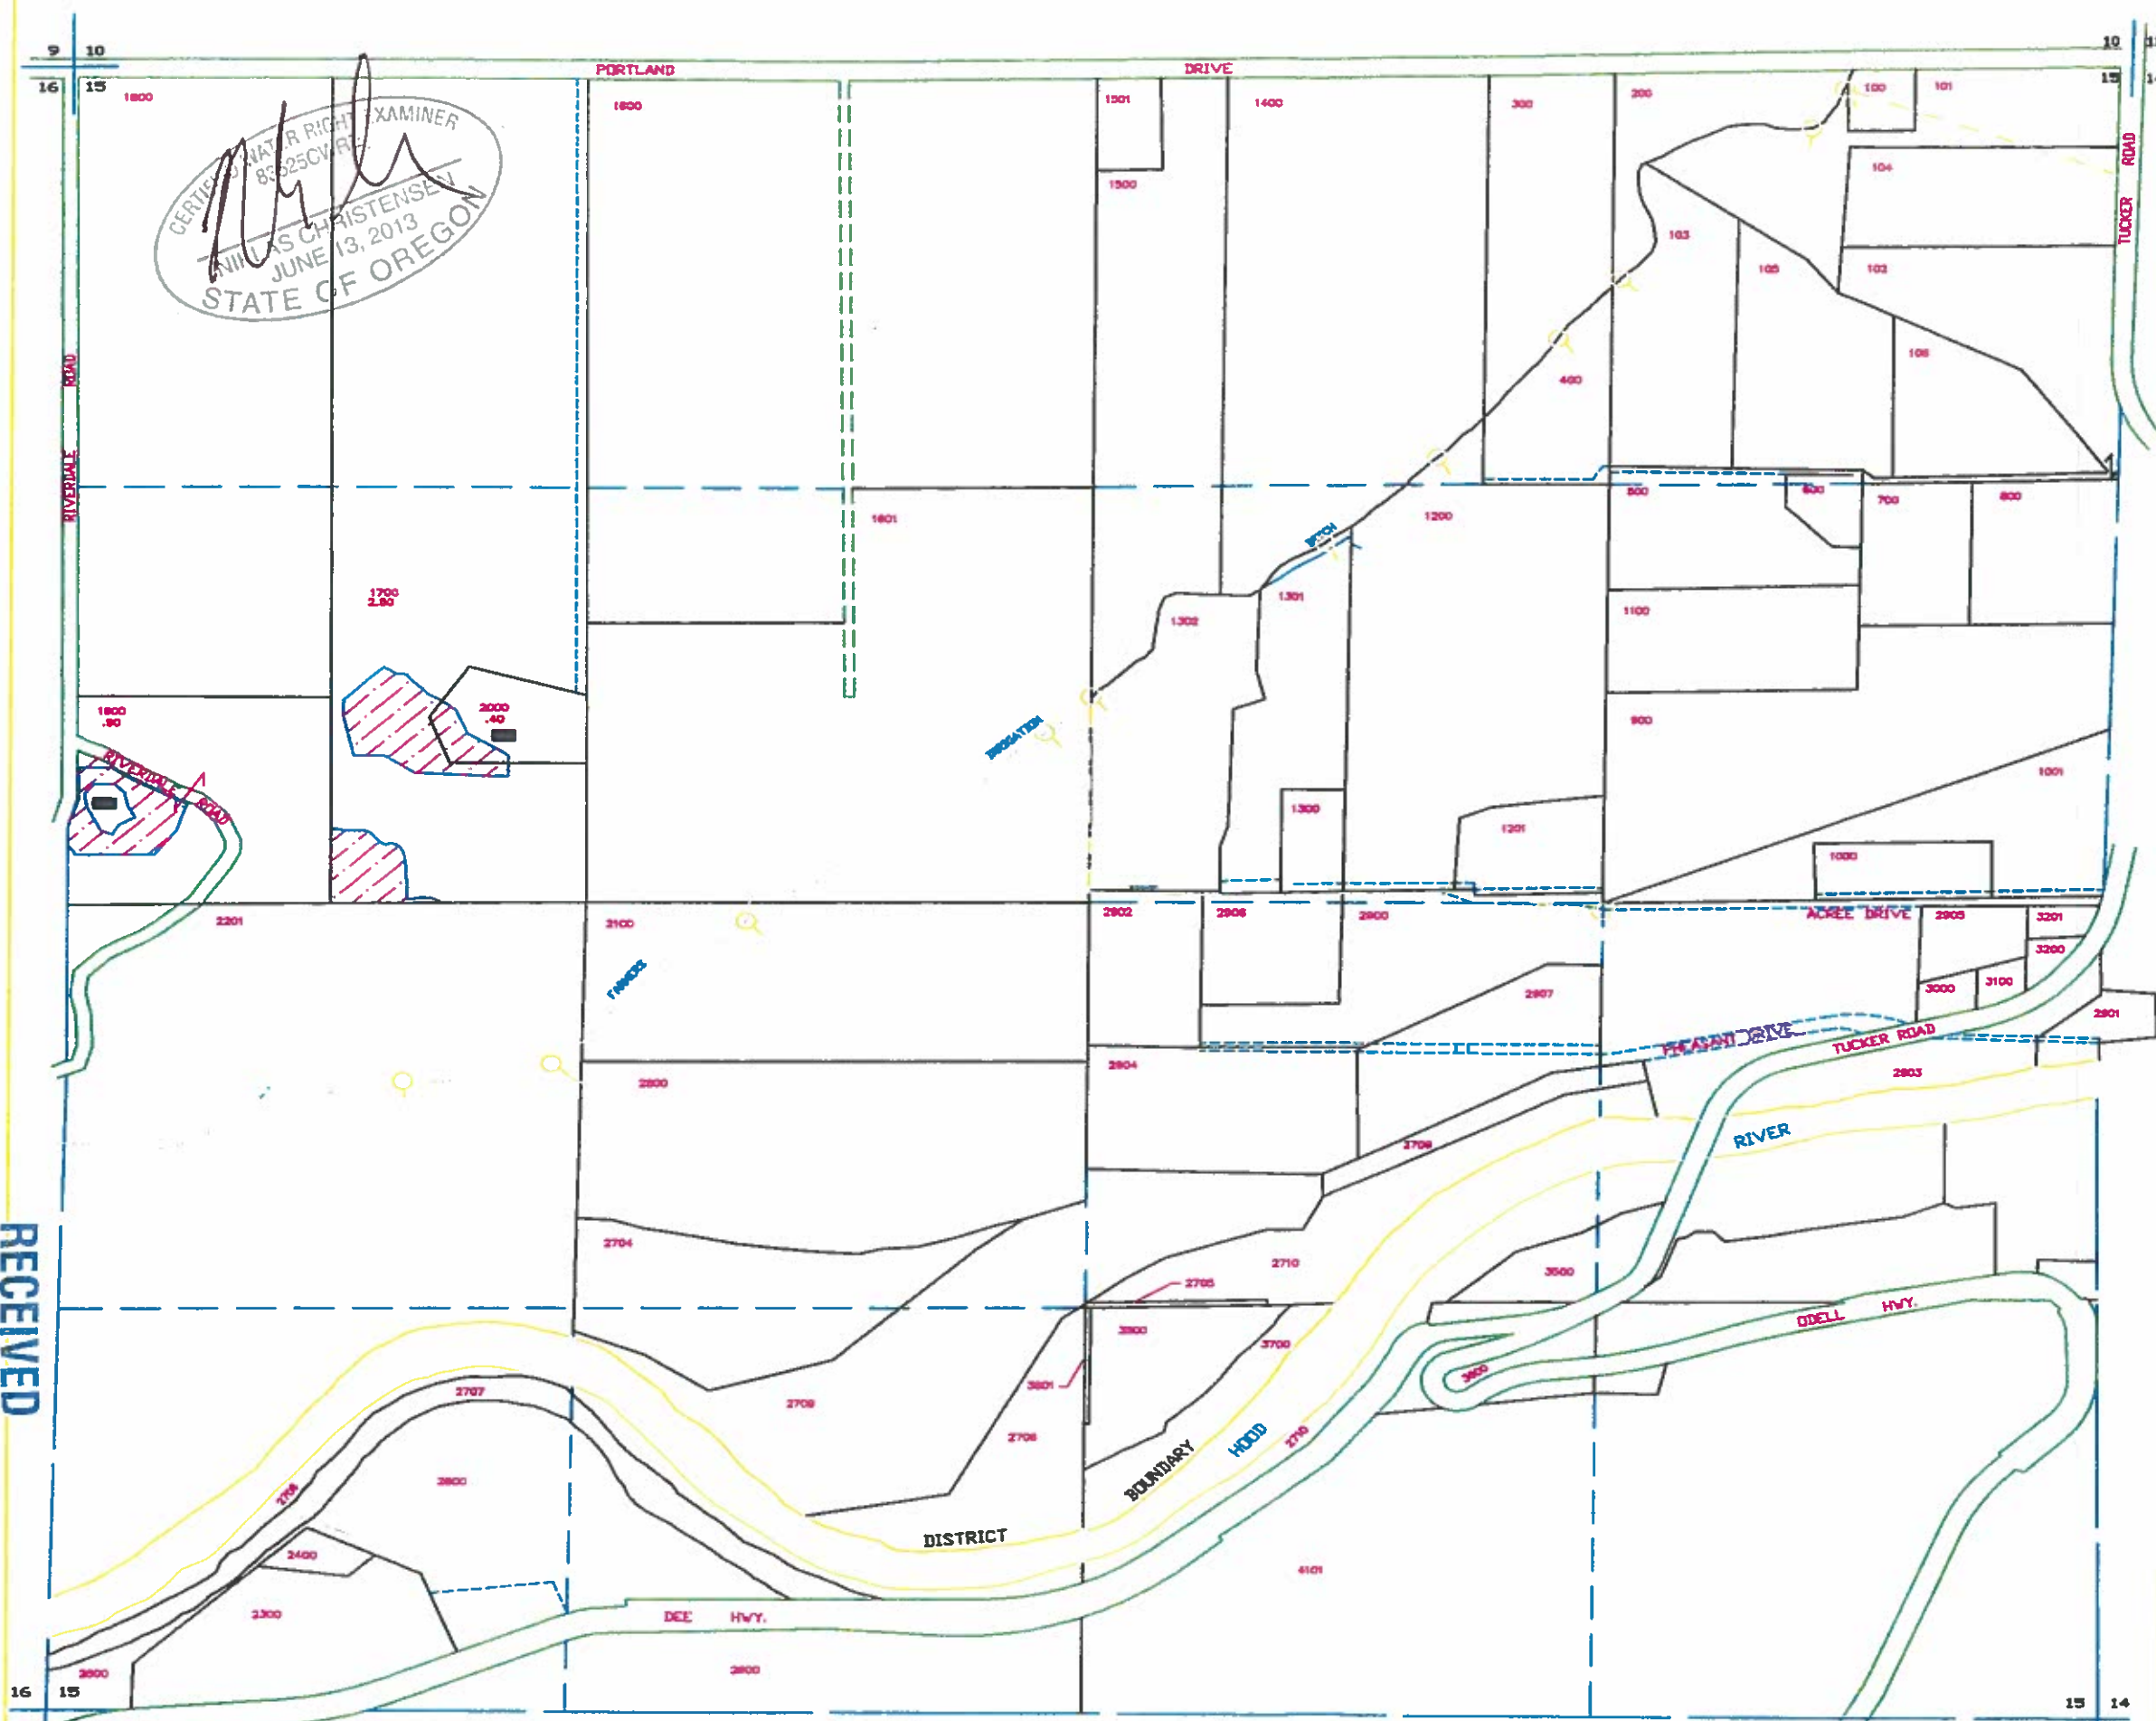

MAP SYMBOL LEGEND

- SECTION LINE
- DISTRICT BOUNDARY
- QTR-SECTION LINE
- PROPERTY LINE
- RIGHT OF WAY
- PRIVATE ROAD
- DLC LINE
- EASEMENT
- RIVER
- CANAL
- CREEK
- B.P.A. EASEMENT
- PIPE
- PENSTOCK
- OPEN DITCH
- TURNOUT BOX
- HOUSE

WATER RIGHT PERMIT LEGEND

2016 Supplemental Upper Reservoir water ON map, under the primary layer.


FARMERS IRRIGATION DISTRICT
HOOD RIVER OREGON
SECTION 15 T2N R10E
REVISION DATE: March 10, 2016



SCALE: 1" = 400' Sheet 7 of 11

S-80252

RECEIVED
APR 21 2016
OW/PRN

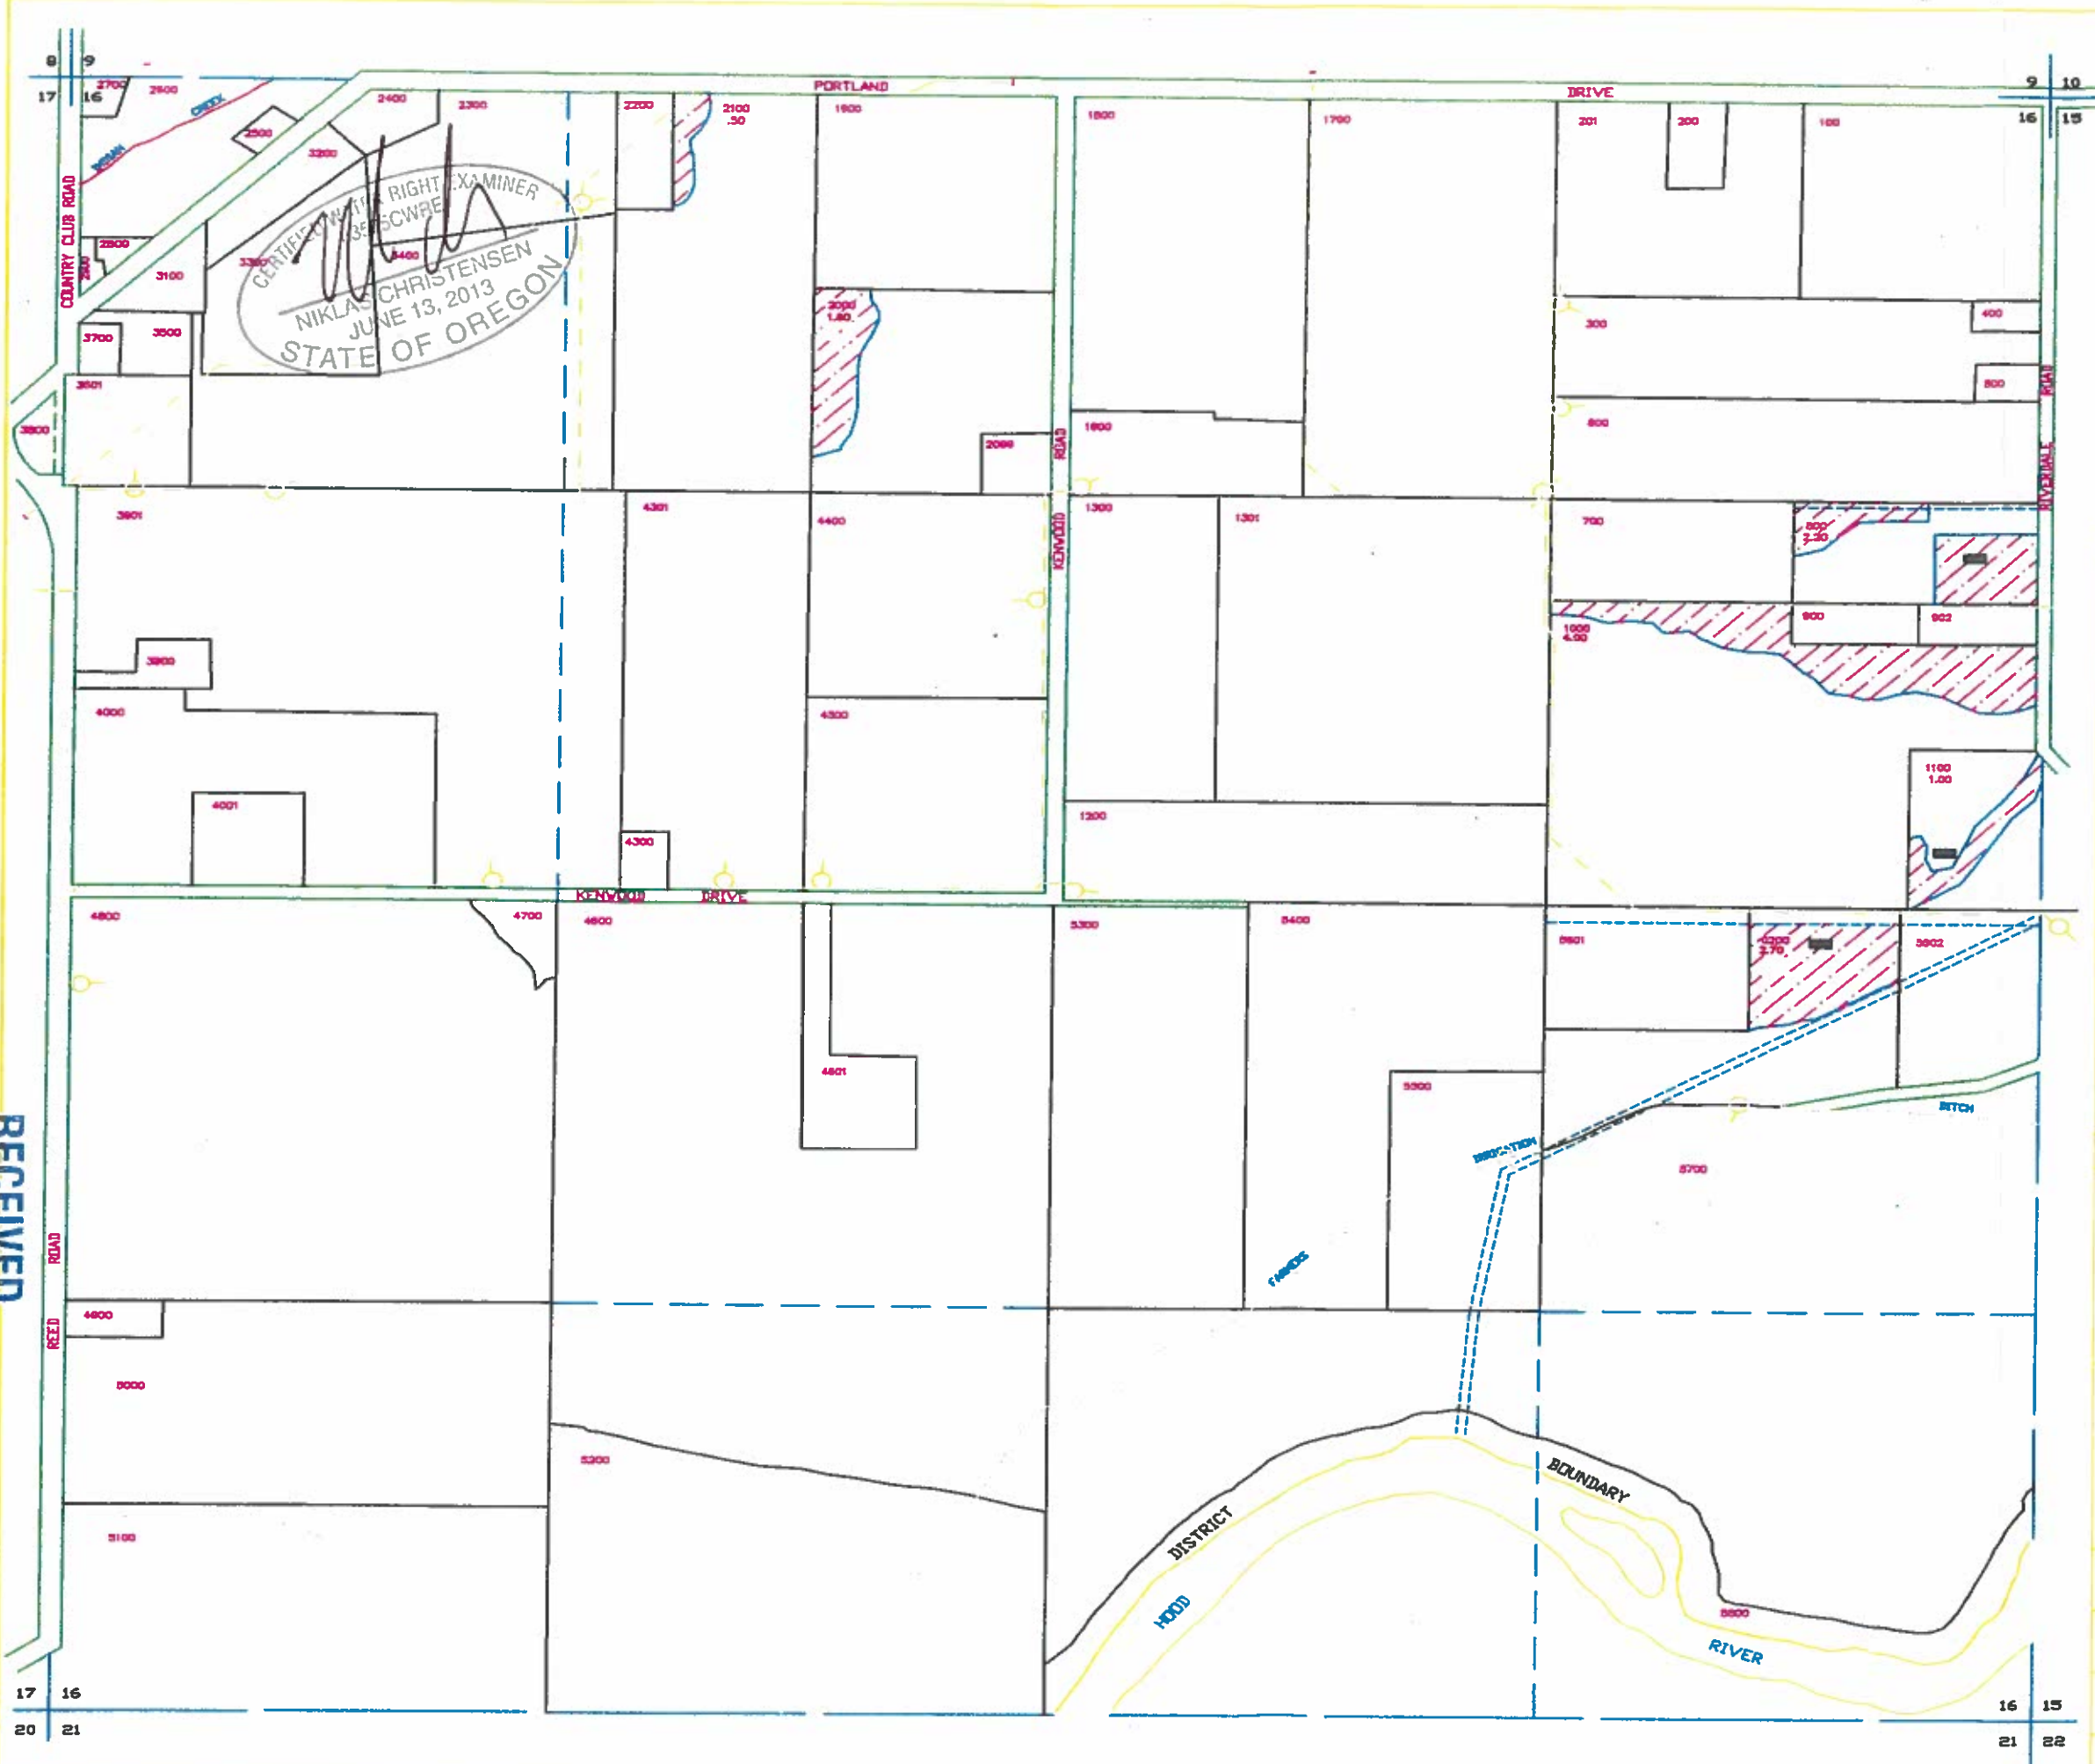

Section 16
 Rainy
 Creek
 Cert
 76230

RECEIVED
 MAY 23 2016
 OWPRD

MAP SYMBOL LEGEND

- SECTION LINE
- DISTRICT BOUNDARY
- QTR-SECTION LINE
- PROPERTY LINE
- RIGHT OF WAY
- PRIVATE ROAD
- DLC LINE
- EASEMENT
- RIVER
- CANAL
- CREEK
- B.P.A. EASEMENT
- PIPE
- PENSTOCK
- OPEN DITCH
- TURNOUT BOX
- HOUSE

WATER RIGHT PERMITS LEGEND

2016 Supplemental Upper Reservoir Water ON map, under existing primary layers.

FARMERS IRRIGATION DISTRICT
 HOOD RIVER OREGON
 SECTION 16 T2N R10E
 REVISION DATE: March 10, 2016



SCALE: 1" = 400' Sheet 8 of 11

S-88222

RECEIVED
 APR 21 2016
 OWPRD

Section 17
Rainy Creek
Cert 76230



CERTIFIED WATER RIGHT EXAMINER
NIKLAS CHRISTENSEN
JUNE 13, 2013
STATE OF OREGON

MAP SYMBOL LEGEND

	SECTION LINE
	DISTRICT BOUNDARY
	QTR-SECTION LINE
	PROPERTY LINE
	RIGHT OF WAY
	PRIVATE ROAD
	DLC LINE
	EASEMENT
	RIVER
	CANAL
	CREEK
	B.P.A. EASEMENT
	PIPE
	PENSTOCK
	OPEN DITCH
	TURNOUT BOX
	HOUSE


WATER RIGHTS PERMIT LEGEND

	2016 Supplemental Upper Reservoir Water On map, under the primary layers.
--	---

RECEIVED
MAY 23 2016
OWRD

FARMERS IRRIGATION DISTRICT
HOOD RIVER OREGON
SECTION 17 T2N R10E
REVISION DATE: March 10, 2016

SCALE: 1" = 400' Sheet 9 of 11

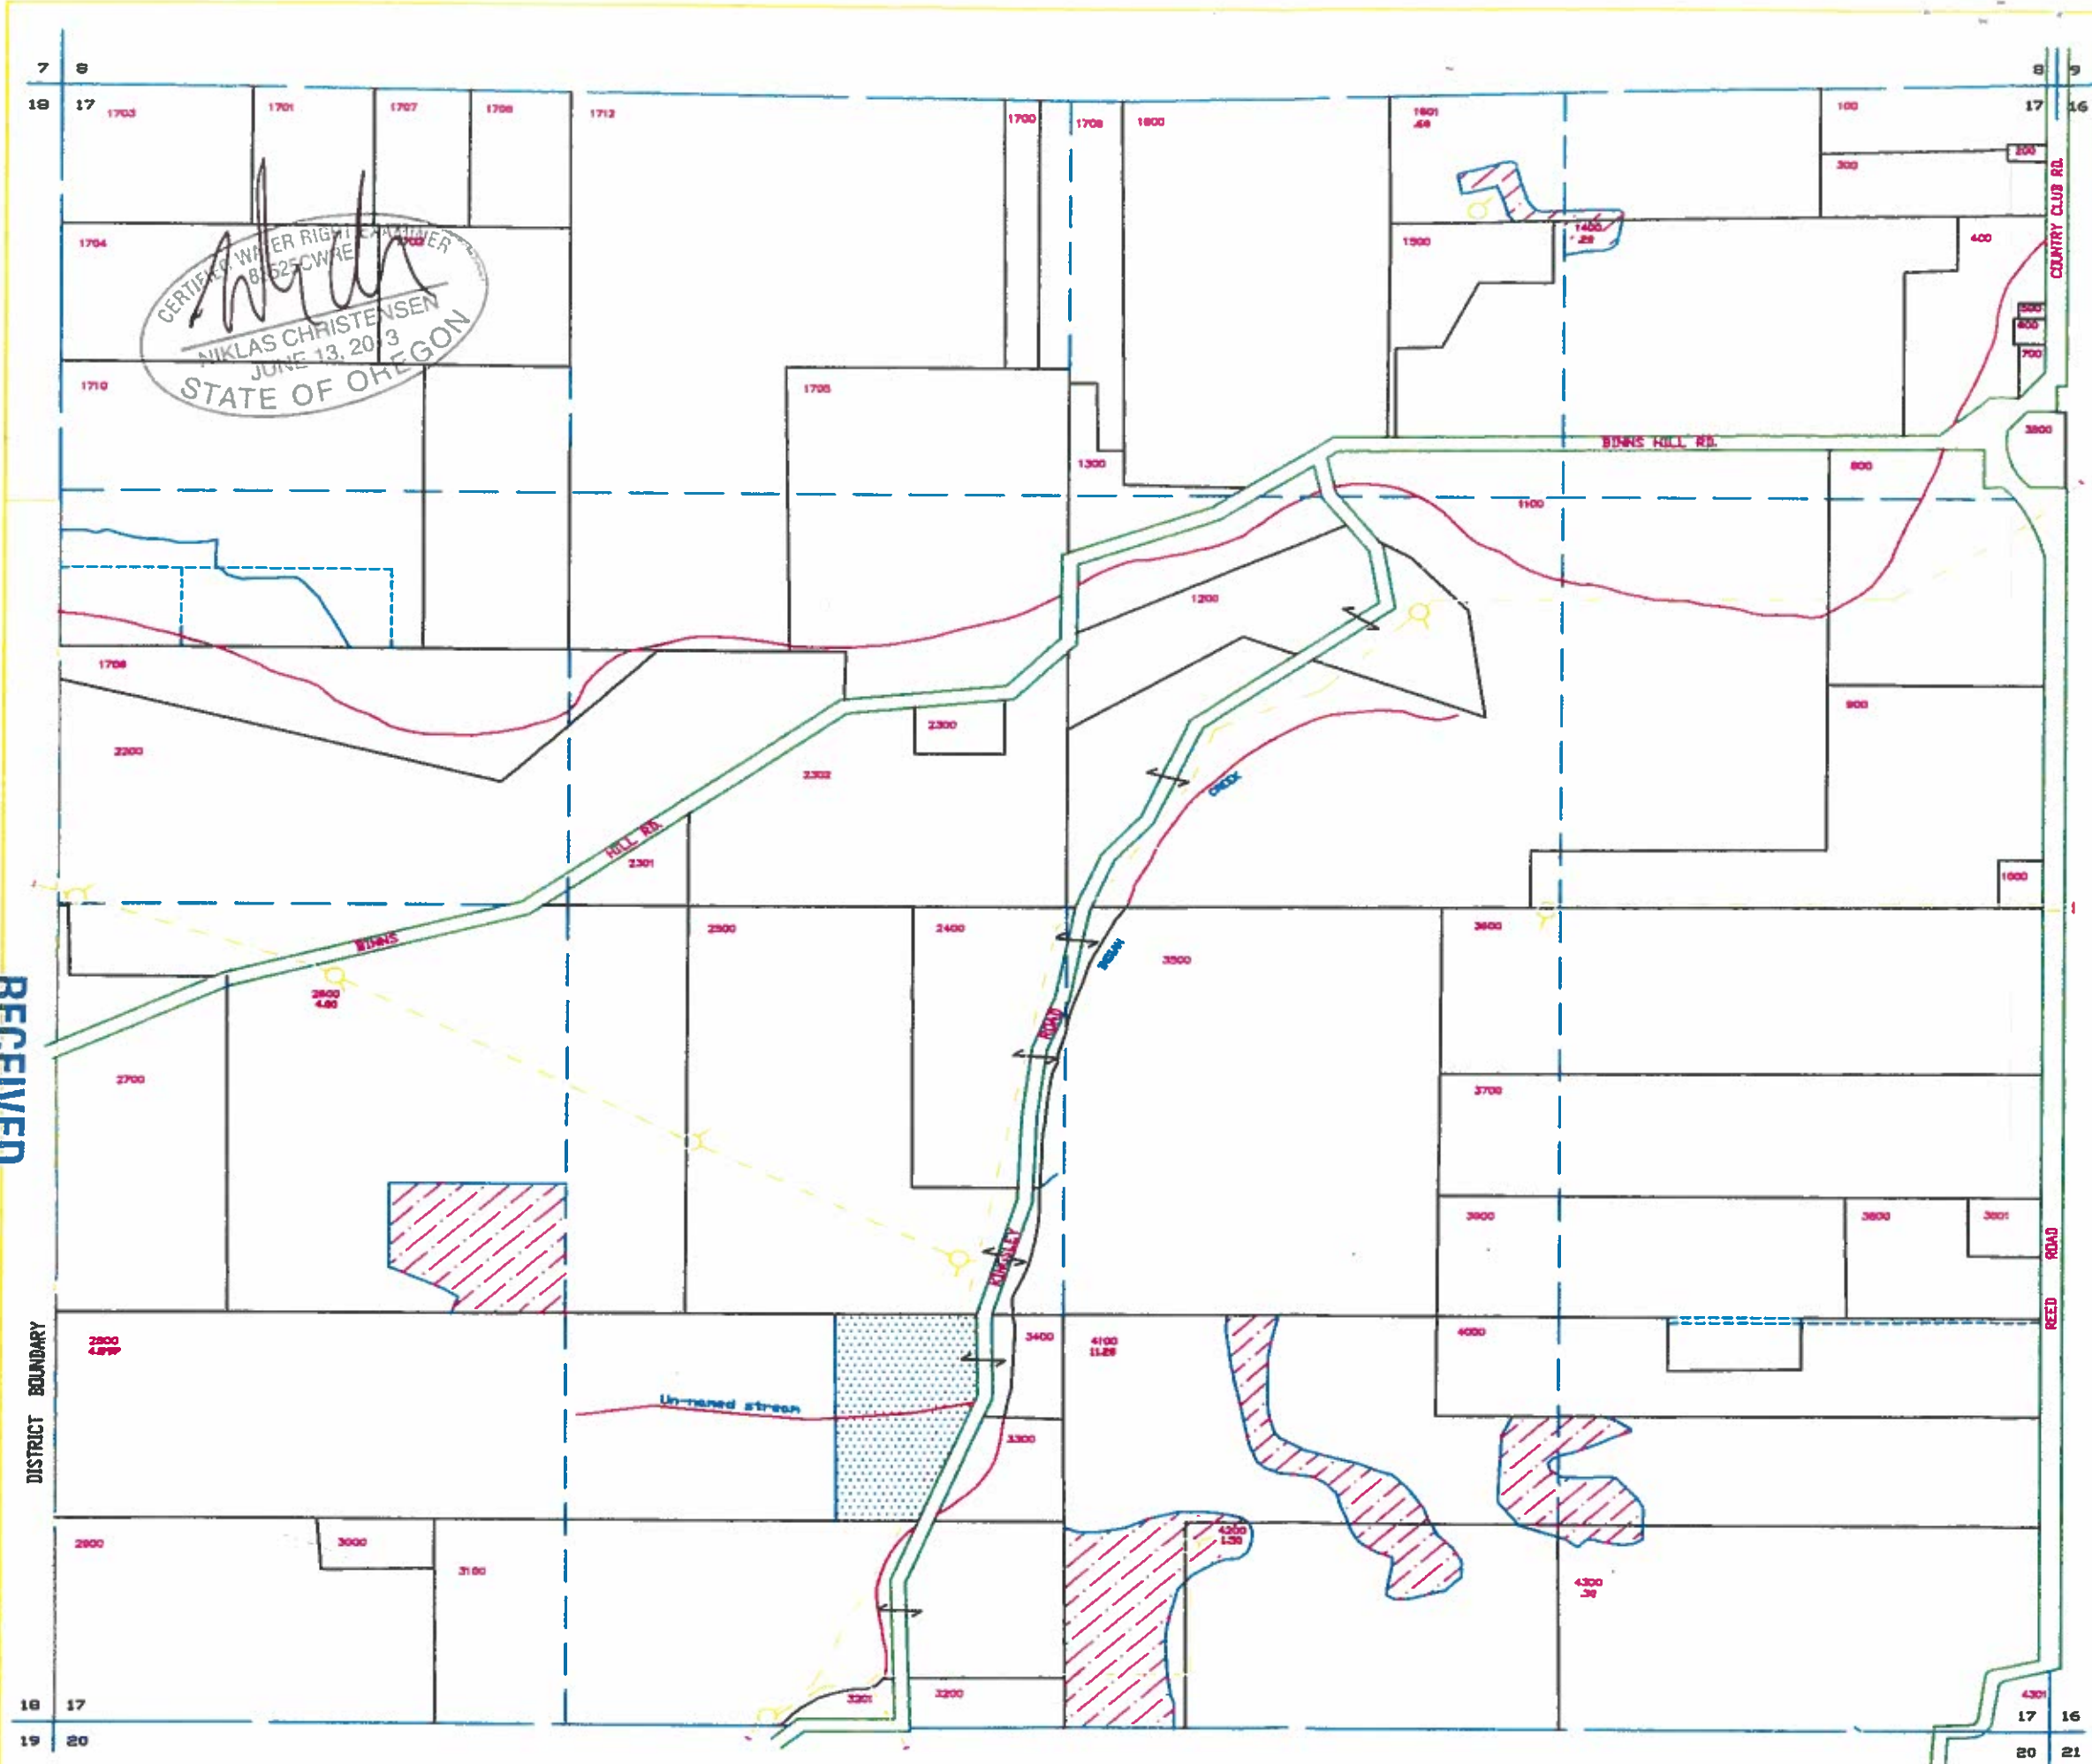

RECEIVED
APR 21 2016
OWWRD

5-98222

Section 17
High Line
Cert
85974



MAP SYMBOL LEGEND

- SECTION LINE
- DISTRICT BOUNDARY
- QTR--SECTION LINE
- PROPERTY LINE
- RIGHT OF WAY
- PRIVATE ROAD
- DLC LINE
- EASEMENT
- RIVER
- CANAL
- CREEK
- B.P.A. EASEMENT
- PIPE
- PENSTOCK
- OPEN DITCH
- TURNOUT BOX
- PUMP FROM FARMERS DITCH

WATER RIGHTS CERTIFICATES LEGEND


2016 Supplemental Upper Reservoir On map, under the primary layer.

RECEIVED
MAY 23 2016
OVR

FARMERS IRRIGATION DISTRICT
HOOD RIVER OREGON
SECTION 17 T2N R10E
REVISION DATE: March 10, 2016



SCALE: 1" = 400' S-00232

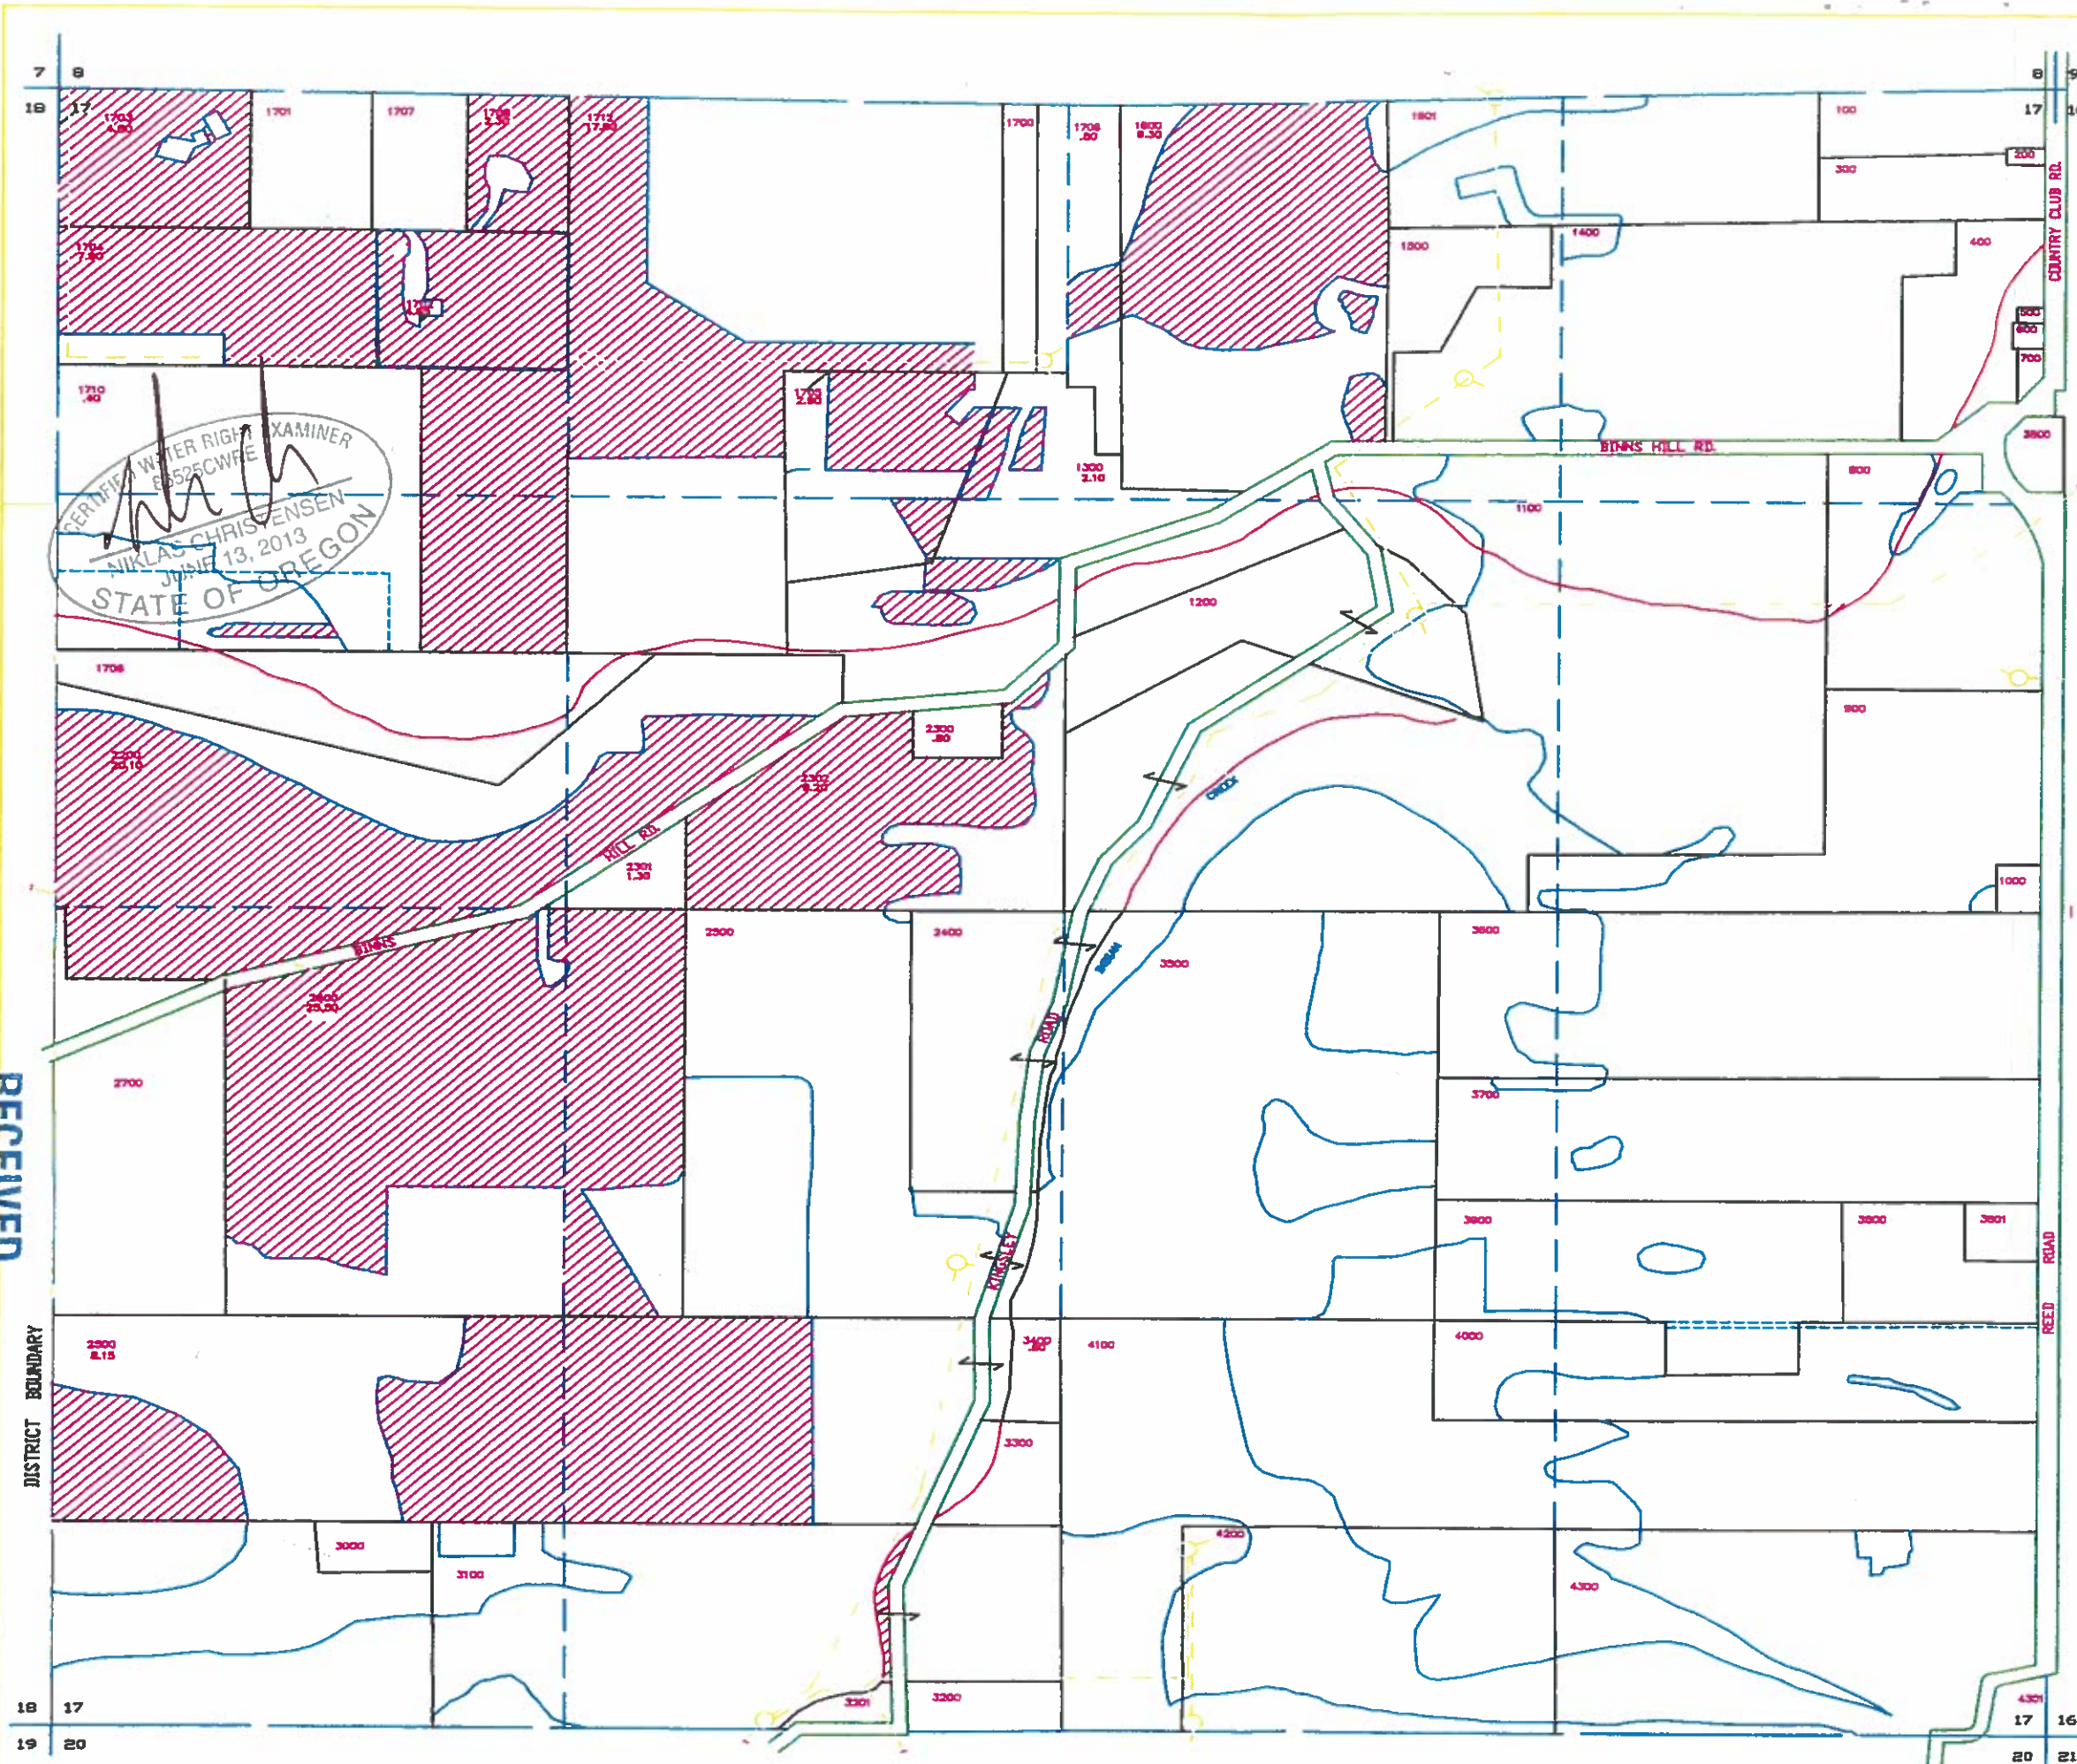

RECEIVED
APR 21 2016
OVR

Section 18
Rainy Creek
Cert 76230

CERTIFIED WATER RIGHT EXAMINER
NICKLAS CHRISTENSEN
JUNE 13, 2013
STATE OF OREGON



MAP SYMBOL LEGEND

	SECTION LINE
	DISTRICT BOUNDARY
	QTR-SECTION LINE
	PROPERTY LINE
	RIGHT OF WAY
	PRIVATE ROAD
	DLC LINE
	EASEMENT
	RIVER
	CANAL
	CREEK
	B.P.A. EASEMENT
	PIPE
	PENSTOCK
	OPEN DITCH
	TURNOUT BOX
	HOUSE


WATER RIGHT PERMIT LEGEND

Supplemental Upper Reservoir ON Map, Under the primary layer.

FARMERS IRRIGATION DISTRICT
HOOD RIVER OREGON
SECTION 18 T2N R10E
REVISION DATE: March 10, 2016



SCALE: 1" = 400' Sheet 10 of 11

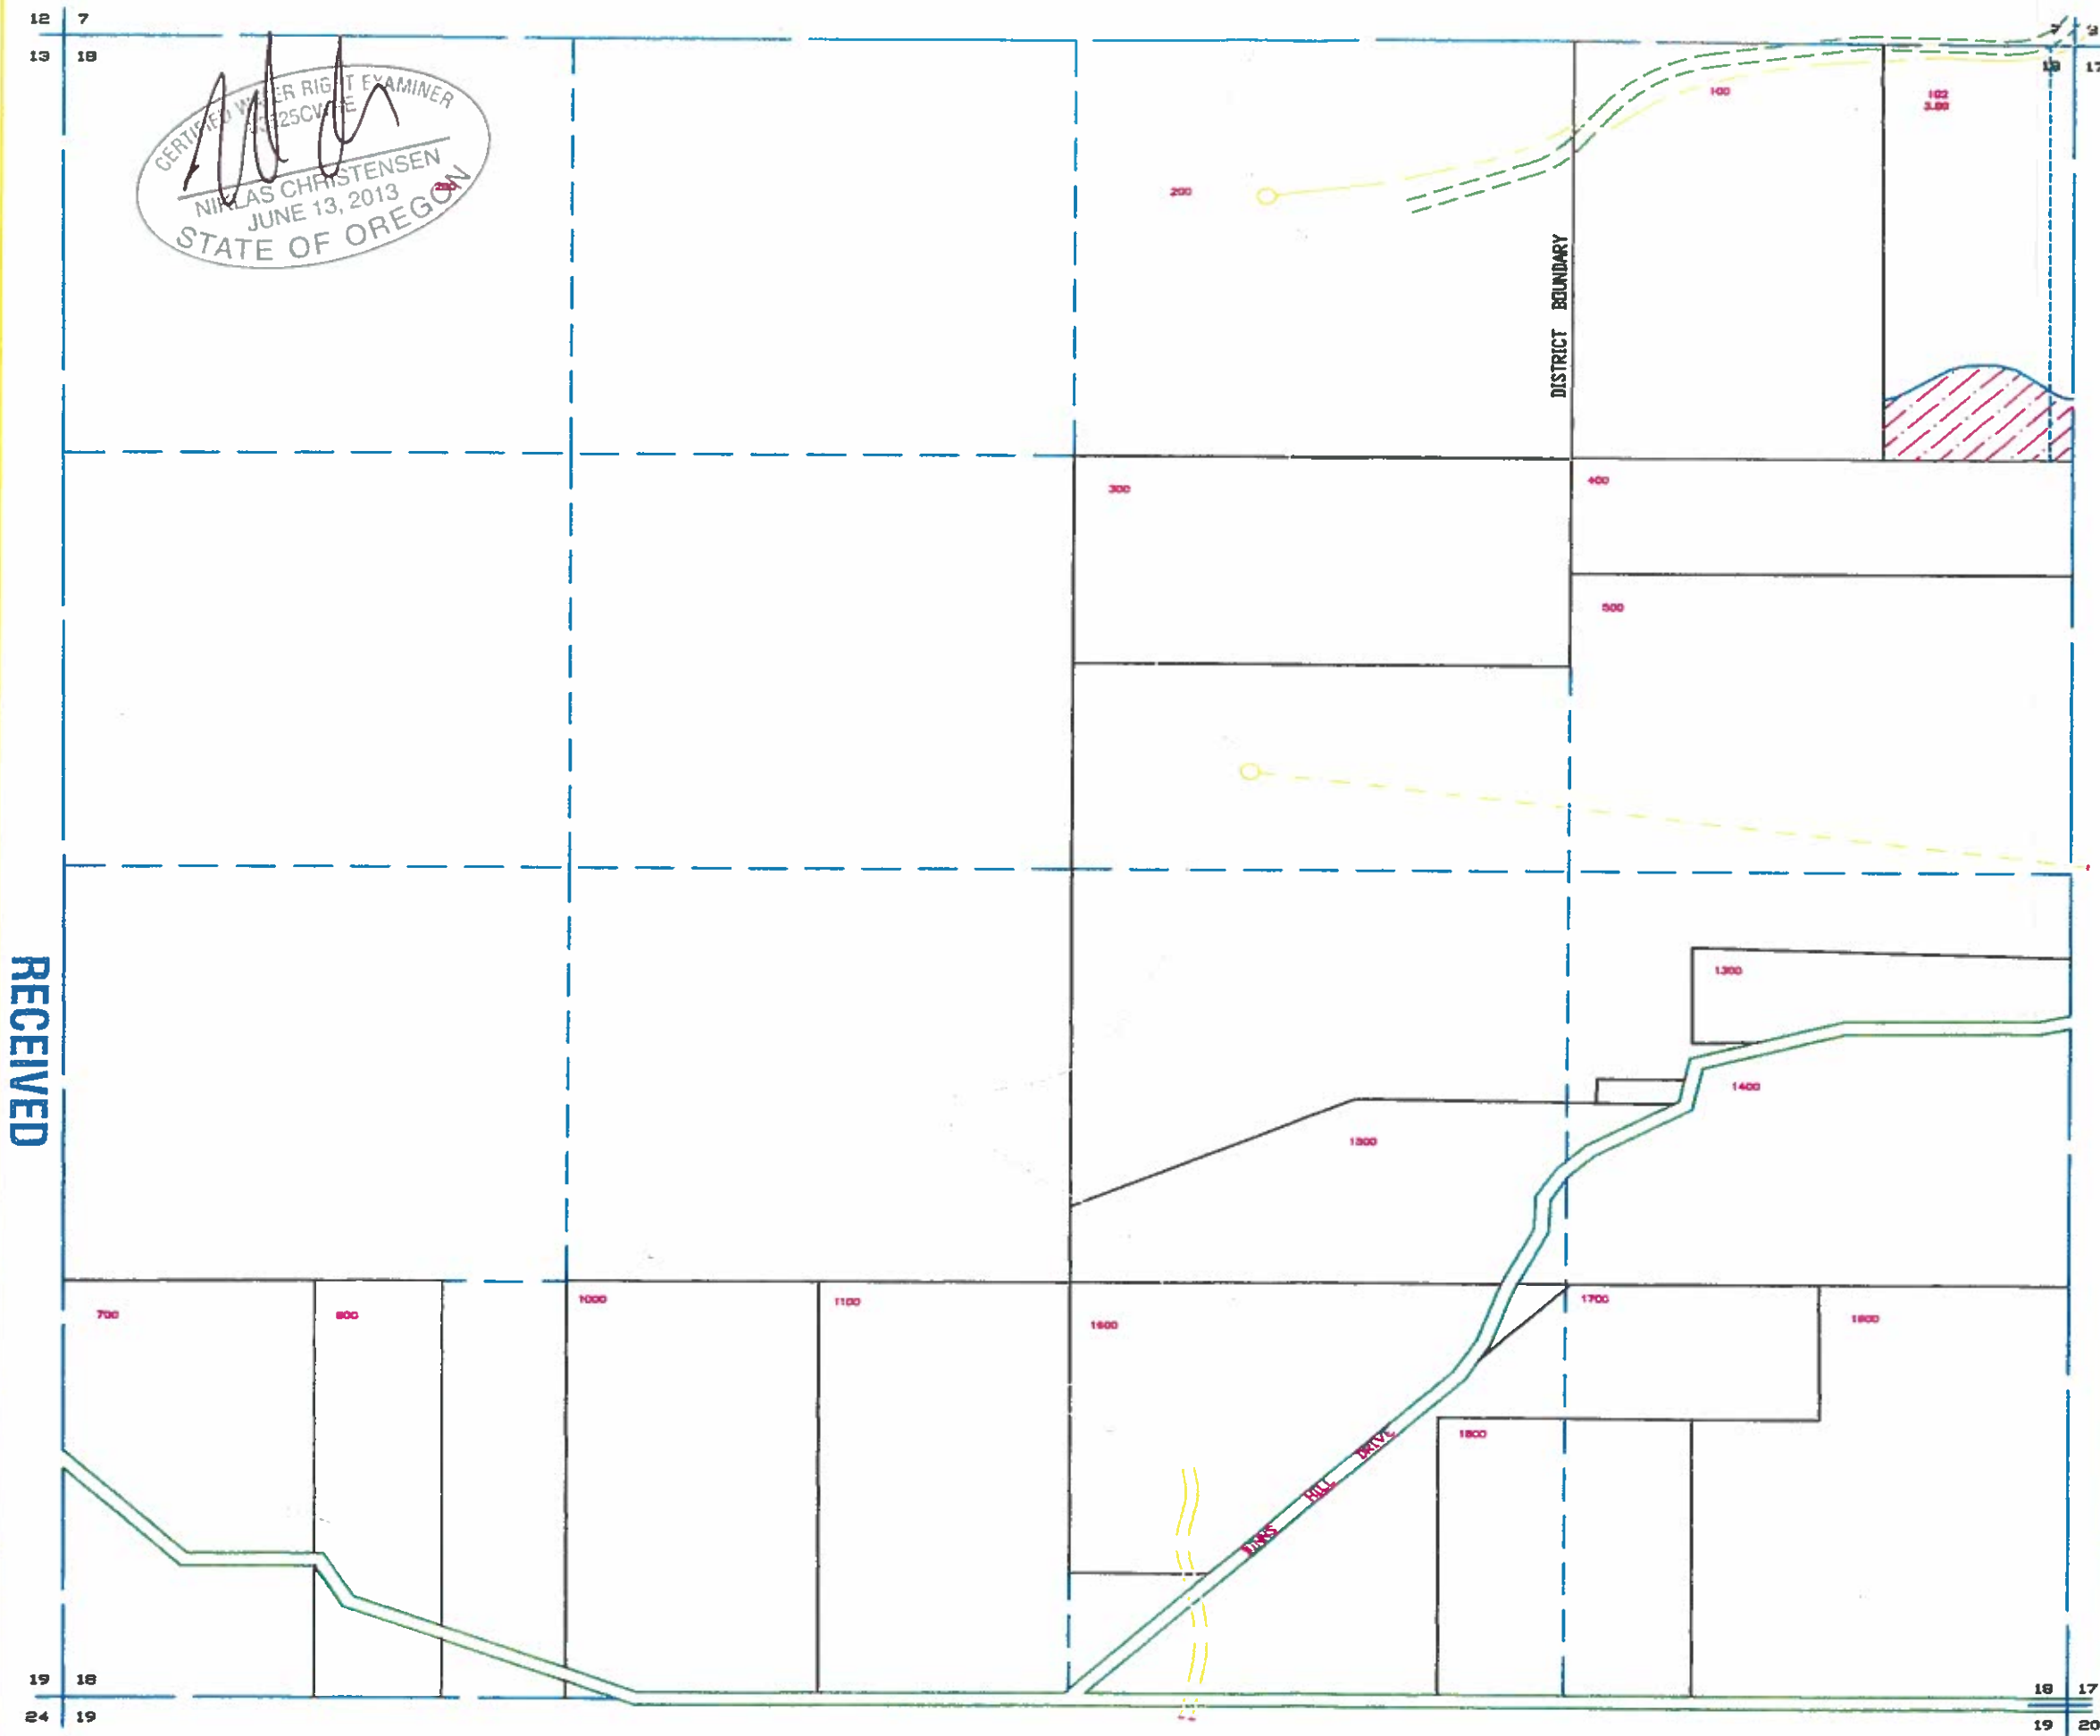

RECEIVED
APR 21 2016
OWRD

RECEIVED
MAY 23 2016
OWRD

8-88232

Section 20
85974

CERTIFIED WATER RIGHT EXAMINER
NIKLAS CHRISTENSEN
JUNE 13, 2013
STATE OF OREGON



MAP SYMBOL LEGEND

- SECTION LINE
- DISTRICT BOUNDARY
- QTR-SECTION LINE
- PROPERTY LINE
- RIGHT OF WAY
- PRIVATE ROAD
- DLC LINE
- EASEMENT
- RIVER
- CANAL
- CREEK
- B.P.A. EASEMENT
- PIPE
- PENSTOCK
- OPEN DITCH
- TURNOUT BOX
- PUMP FROM FARMERS DITCH

WATER RIGHTS CERTIFICATES LEGEND

Supplemental Upper Reservoir ON map, Under the primary layer.


FARMERS IRRIGATION DISTRICT
HOOD RIVER OREGON
SECTION 20 T2N R10E
REVISION DATE: March 10, 2016



SCALE: 1" = 400' 588232

RECEIVED
MAY 23 2016
OWRD

RECEIVED
APR 21 2016
OWPRD

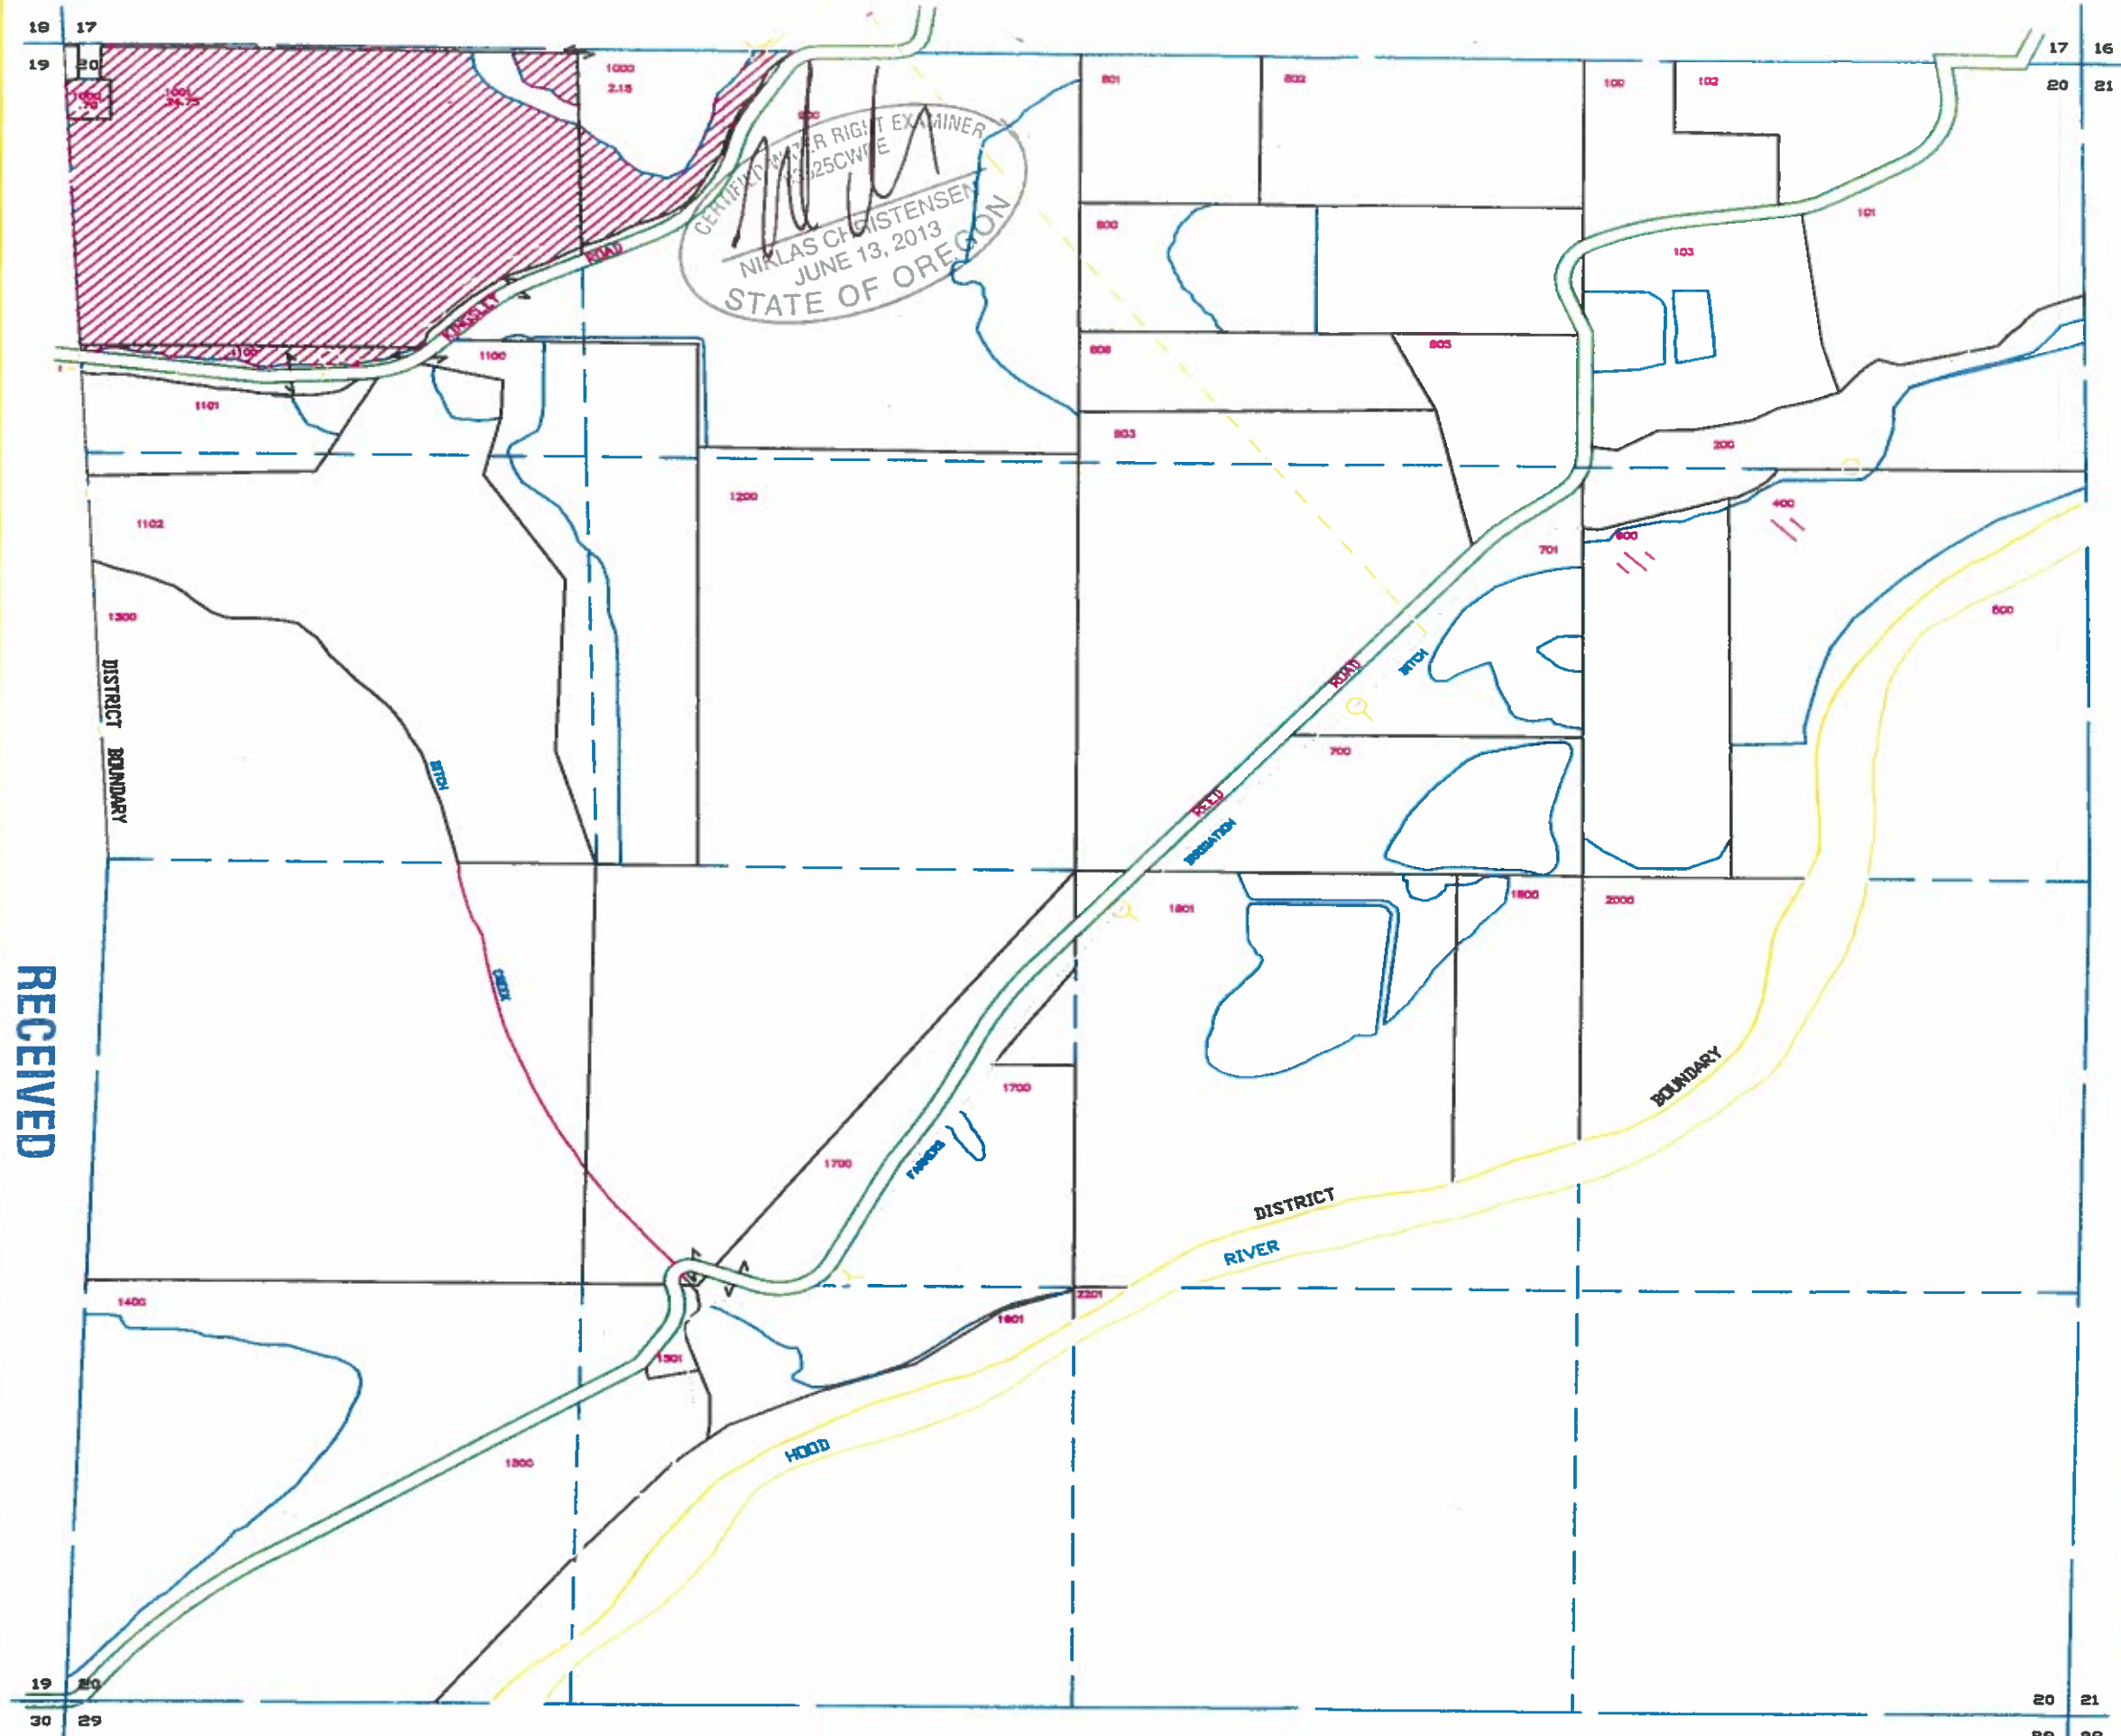

Section 20
Cert 76230



MAP SYMBOL LEGEND

- SECTION LINE
- DISTRICT BOUNDARY
- QTR-SECTION LINE
- PROPERTY LINE
- RIGHT OF WAY
- PRIVATE ROAD
- DLC LINE
- EASEMENT
- RIVER
- CANAL
- CREEK
- B.P.A. EASEMENT
- PIPE
- PENSTOCK
- OPEN DITCH
- TURNOUT BOX
- HOUSE

WATER RIGHT PERMIT LEGEND

Supplemental Upper Reservoir On map, Under the primary Layer


RECEIVED
MAY 23 2016
OWRD

FARMERS IRRIGATION DISTRICT
HOOD RIVER OREGON
SECTION 20 T2N R10E
REVISION DATE: March 10, 2016



SCALE: 1" = 400' Sheet 11 of 11

S-88232

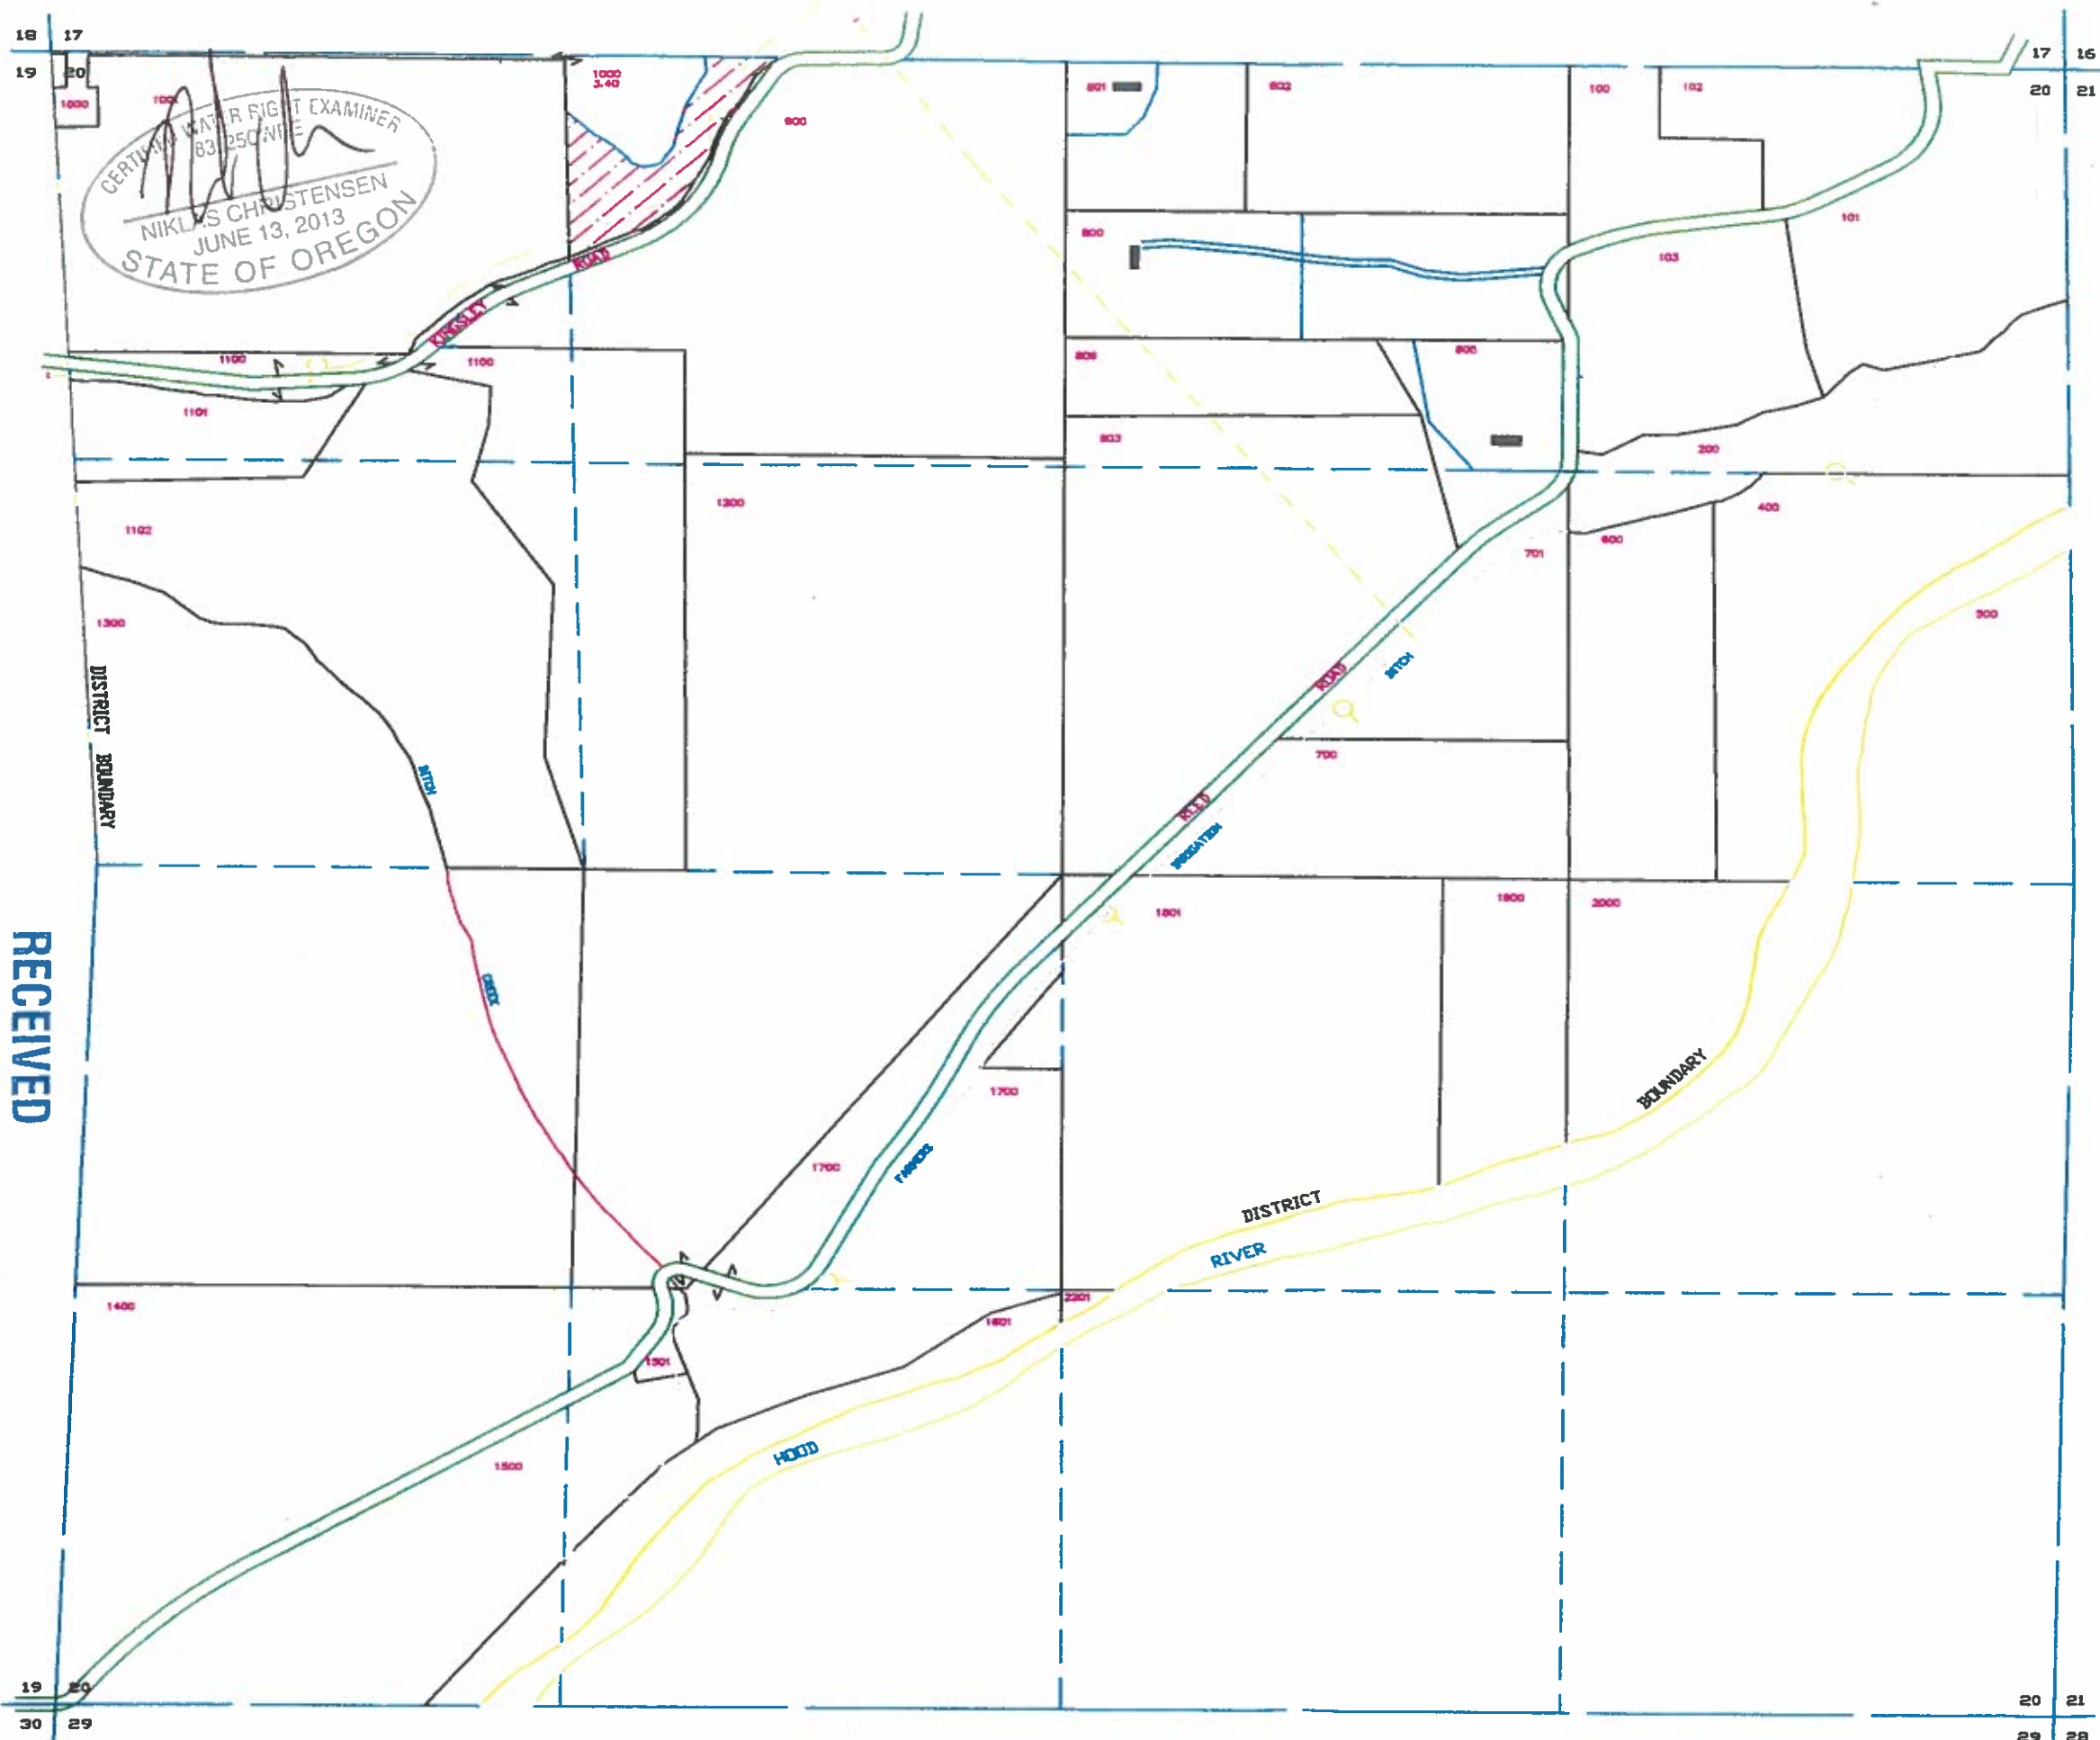

RECEIVED
APR 21 2016
OWPRD

Section 33
85974



MAP SYMBOL LEGEND

- SECTION LINE
- DISTRICT BOUNDARY
- QTR-SECTION LINE
- PROPERTY LINE
- RIGHT OF WAY
- PRIVATE ROAD
- DLC LINE
- EASEMENT
- RIVER
- CANAL
- CREEK
- B.P.A. EASEMENT
- PIPE
- PENSTOCK
- OPEN DITCH
- TURNOUT BOX
- PUMP FROM FARMERS DITCH


WATER RIGHTS CERTIFICATES LEGEND

Supplemental Upper Reservoir water ON map, Under the primary Layer

FARMERS IRRIGATION DISTRICT
HOOD RIVER OREGON
SECTION 33 T3N R10E
REVISION DATE: March 10, 2016

SCALE: 1" = 400'

5-88232

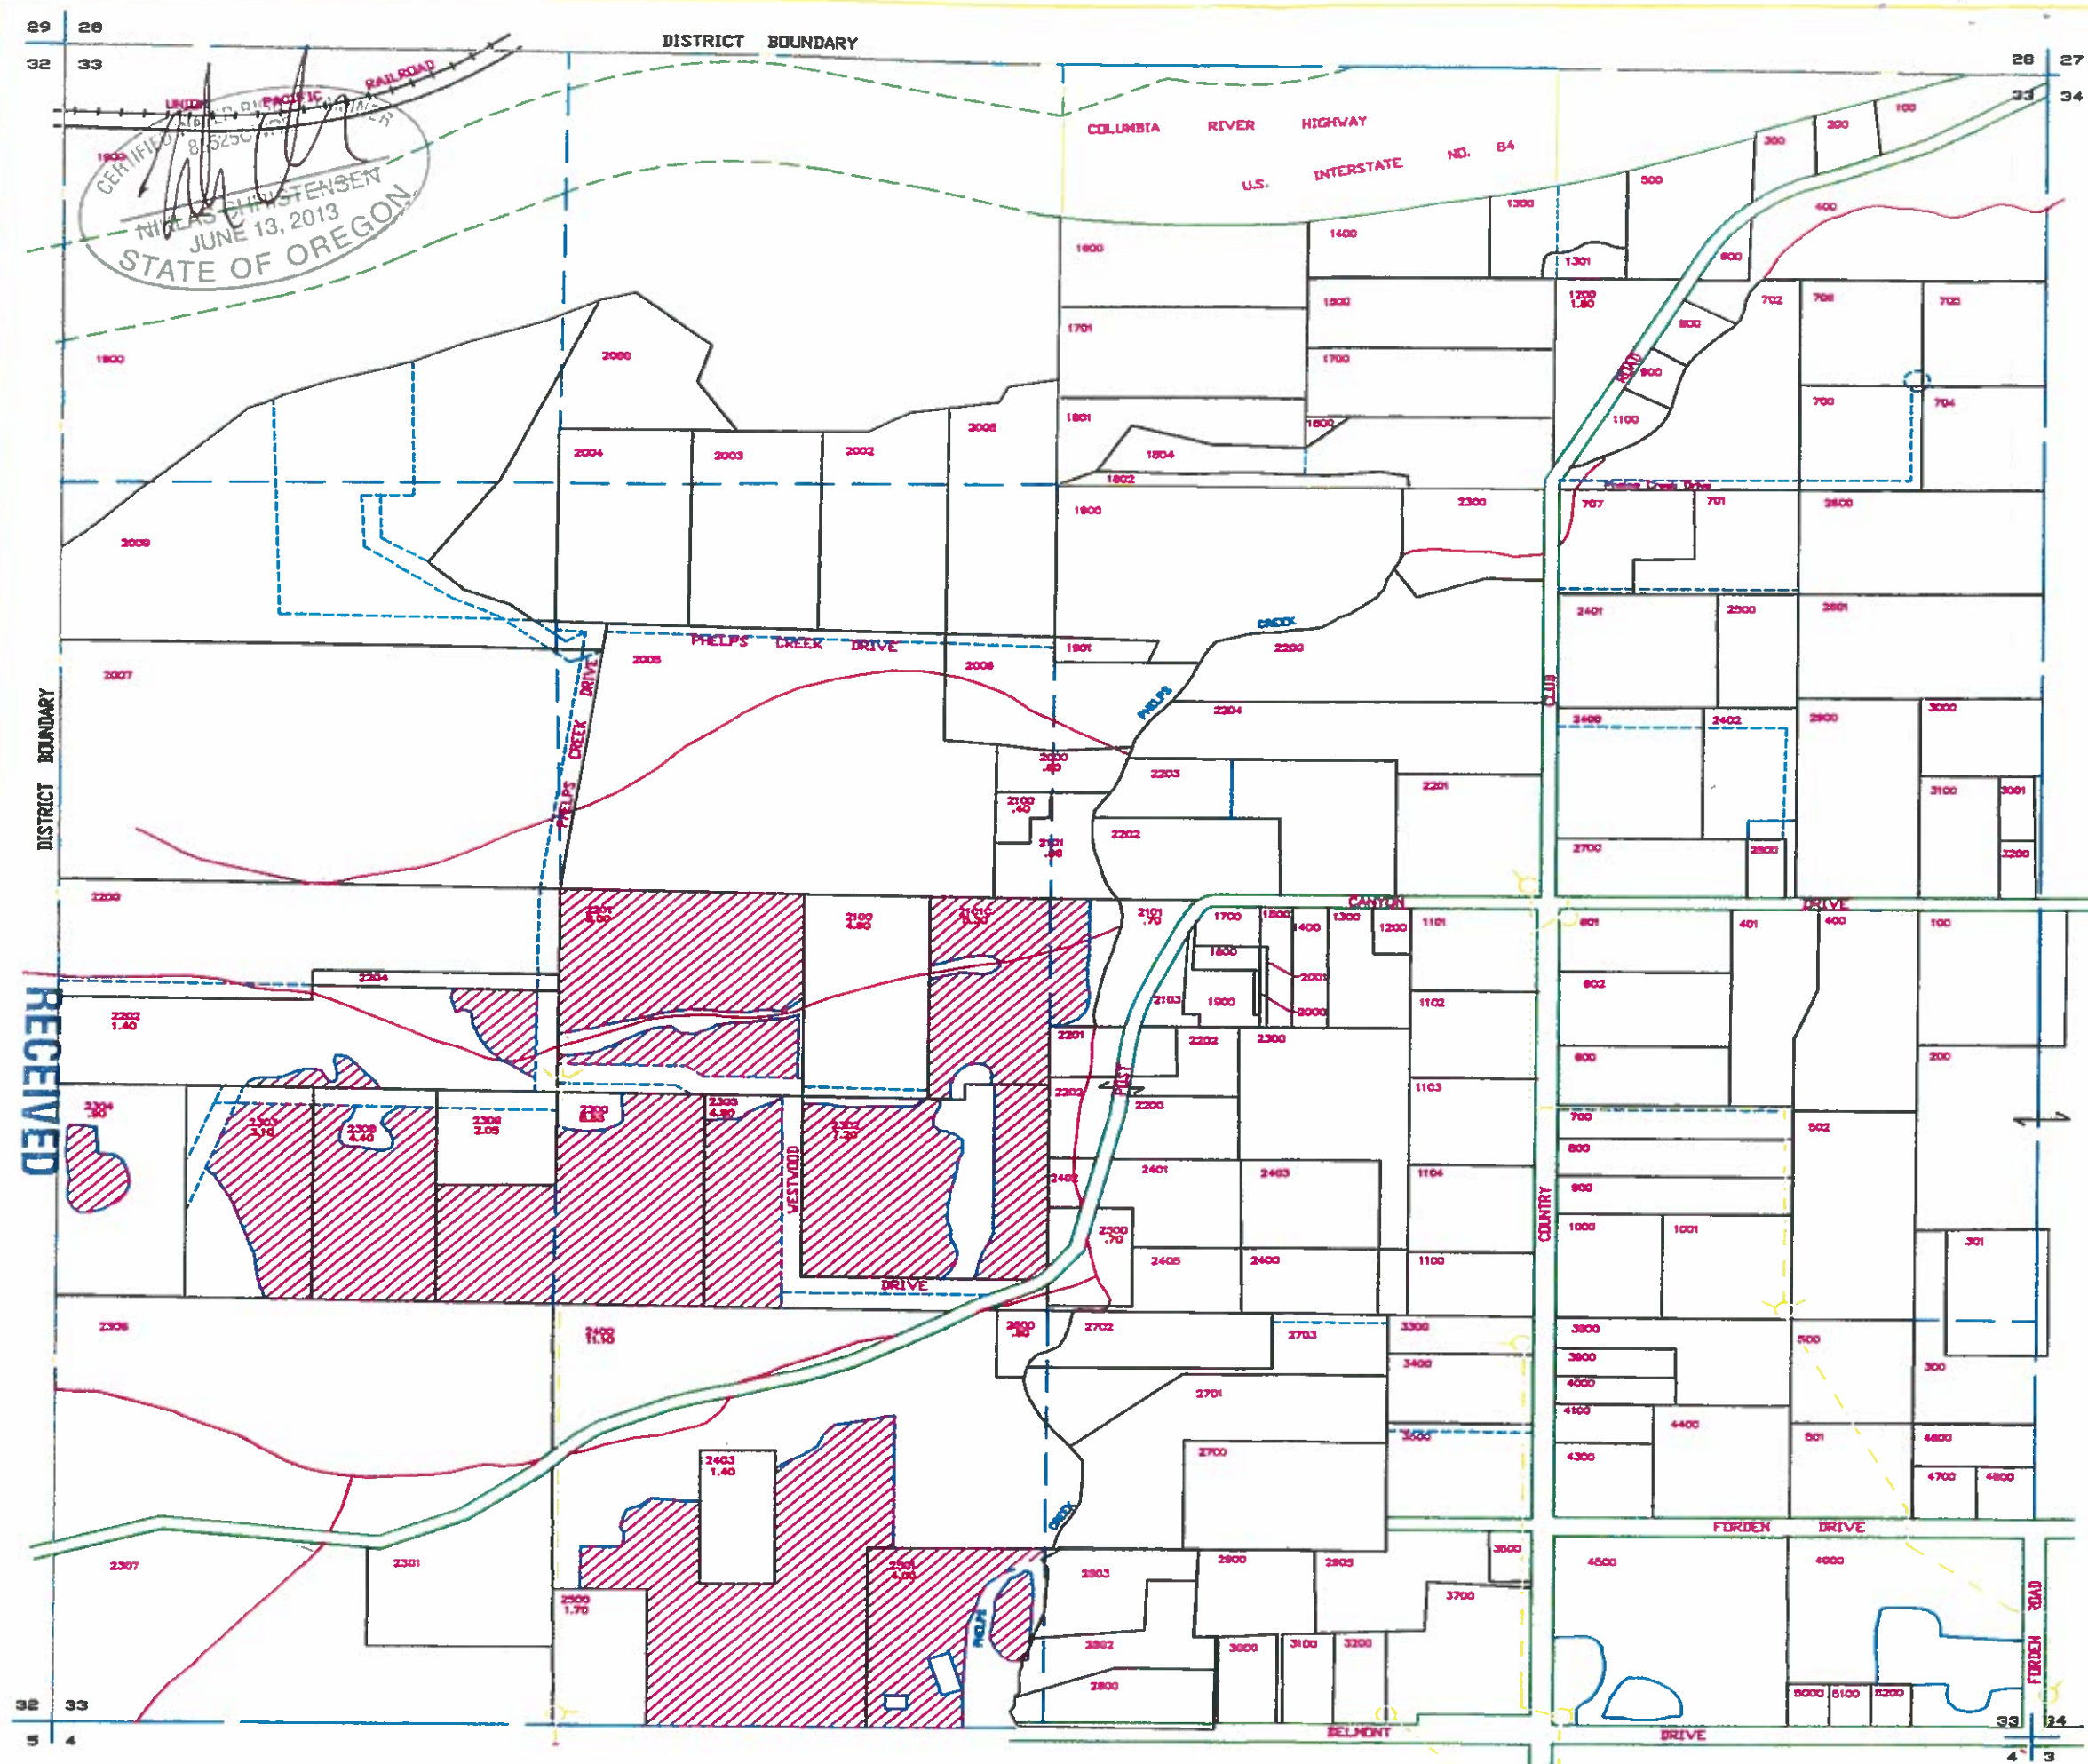

RECEIVED
APR 21 2016
OWRD

RECEIVED
MAY 23 2016
OWRD