


**Map for Joy and Silvia Lynn
NE 1/4 Sec.7 T.25S. R.4W. W.M.
Douglas County
Scale 1" = 400'**

RECEIVED
MAR 12 2019
OWRD

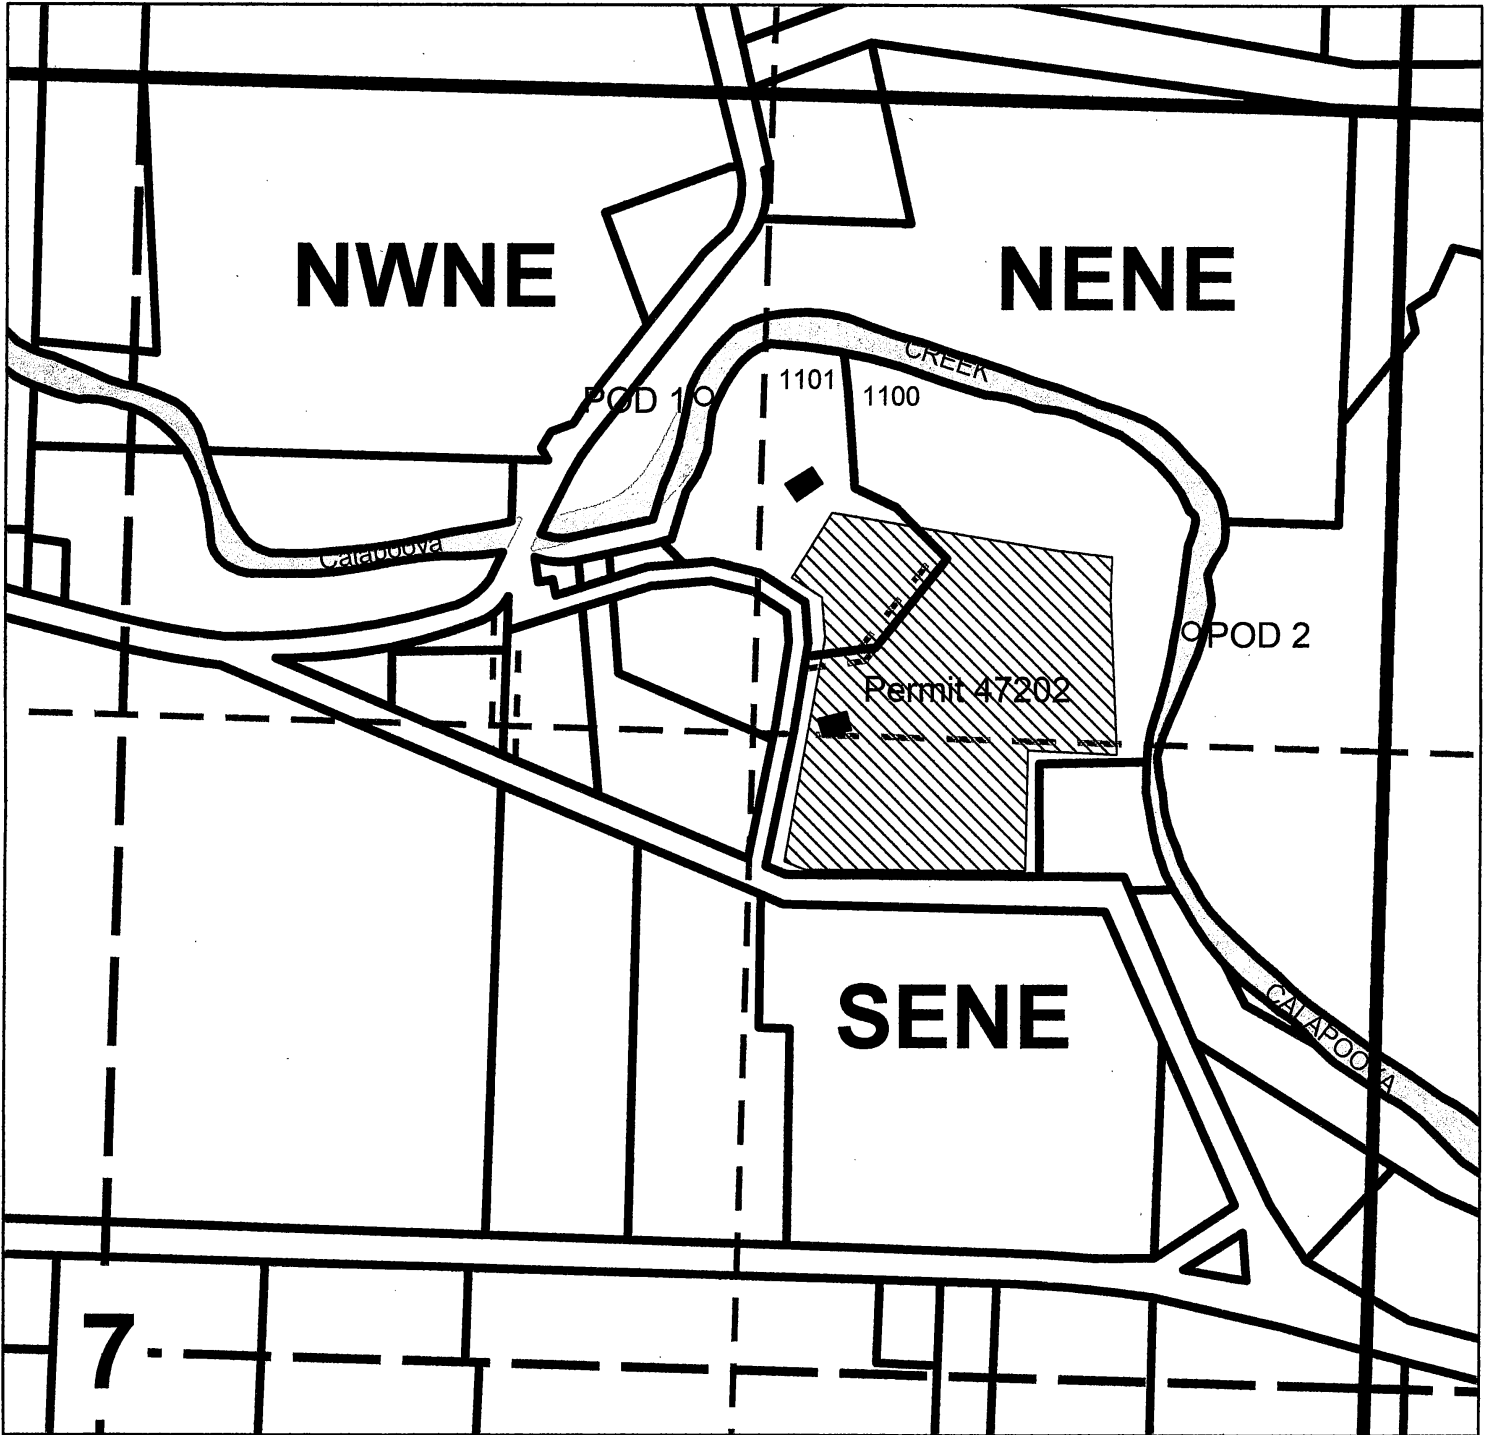

POD 1 is 645 ft. South and 1450 ft. West from the NE Corner of Section 7.
POD 2 is 1080 ft. South and 410 ft. West from the NE Corner of Section 7.