

# PERMIT AMENDMENT MAP

## APPLICATION S-72659 PERMIT S-51534 & APPLICATION S-86459 PERMIT S-54692

PREPARED FOR:  
LEFT COAST CELLARS  
4225 N PACIFIC HIGHWAY  
RICKREAL OR 97371

SECTION 31, T6S, R4W, WM TAX LOTS 102, 104, 110, 111 & 401  
SECTIONS 5 & 6 T7S R4W WM TAX LOTS 102, 103 & 200  
POLK COUNTY, OREGON

PREPARED FOR:  
LARUE FAMILY TRUST  
PO BOX 137  
RICKREAL OR 97371




Project: 316-075  
Map: WR Summary-C  
By: JEFFREY KEE  
Date: June 13, 2018

NEW PLACE OF USE PERMIT S-51534

T	R	Sec	QTR	QTR	TAX LOT	GLO	ACRES	POD	PRIORITY
6S	4W	31	NW	SW	401	GOVTLT	3.5	1,2	8-Sep-92
6S	4W	31	SW	SW	401	GOVTLT	34.8	1,2	8-Sep-92
6S	4W	31	SE	SW	110		5.3	1,2	8-Sep-92
6S	4W	31	NW	SE	111, 102		8.5	3	8-Sep-92
6S	4W	31	NE	SE	102		0.3	3	8-Sep-92
6S	4W	31	SW	SE	111		12.2	3	8-Sep-92
6S	4W	31	SE	SE	111		2.4	3	8-Sep-92
7S	4W	6	NW	NW	110	GOVTLT	4	1,2	8-Sep-92
7S	4W	6	NE	NW	110	GOVTLT	12.4	1,2	8-Sep-92
7S	4W	6	SW	NW	103	GOVTLT 2	4	1,2	8-Sep-92
7S	4W	6	SE	NW	103	Govt LT 1	15.4	1,2	8-Sep-92
7S	4W	6	NW	NE	110	GOVTLT	4.2	1,2	8-Sep-92
7S	4W	6	NE	NE	110	GOVTLT	1.6	1,2	8-Sep-92
7S	4W	6	SE	NE	102		6.4	2	8-Sep-92
7S	4W	6	NW	SE	102		1.8	2	8-Sep-92
7S	4W	6	NE	SE	102		1.8	2	8-Sep-92
7S	4W	6	SW	NE	102		8.4		8-Sep-92
									8-Sep-92

127

RECEIVED  
 JUN 29 2018  
 OWRD

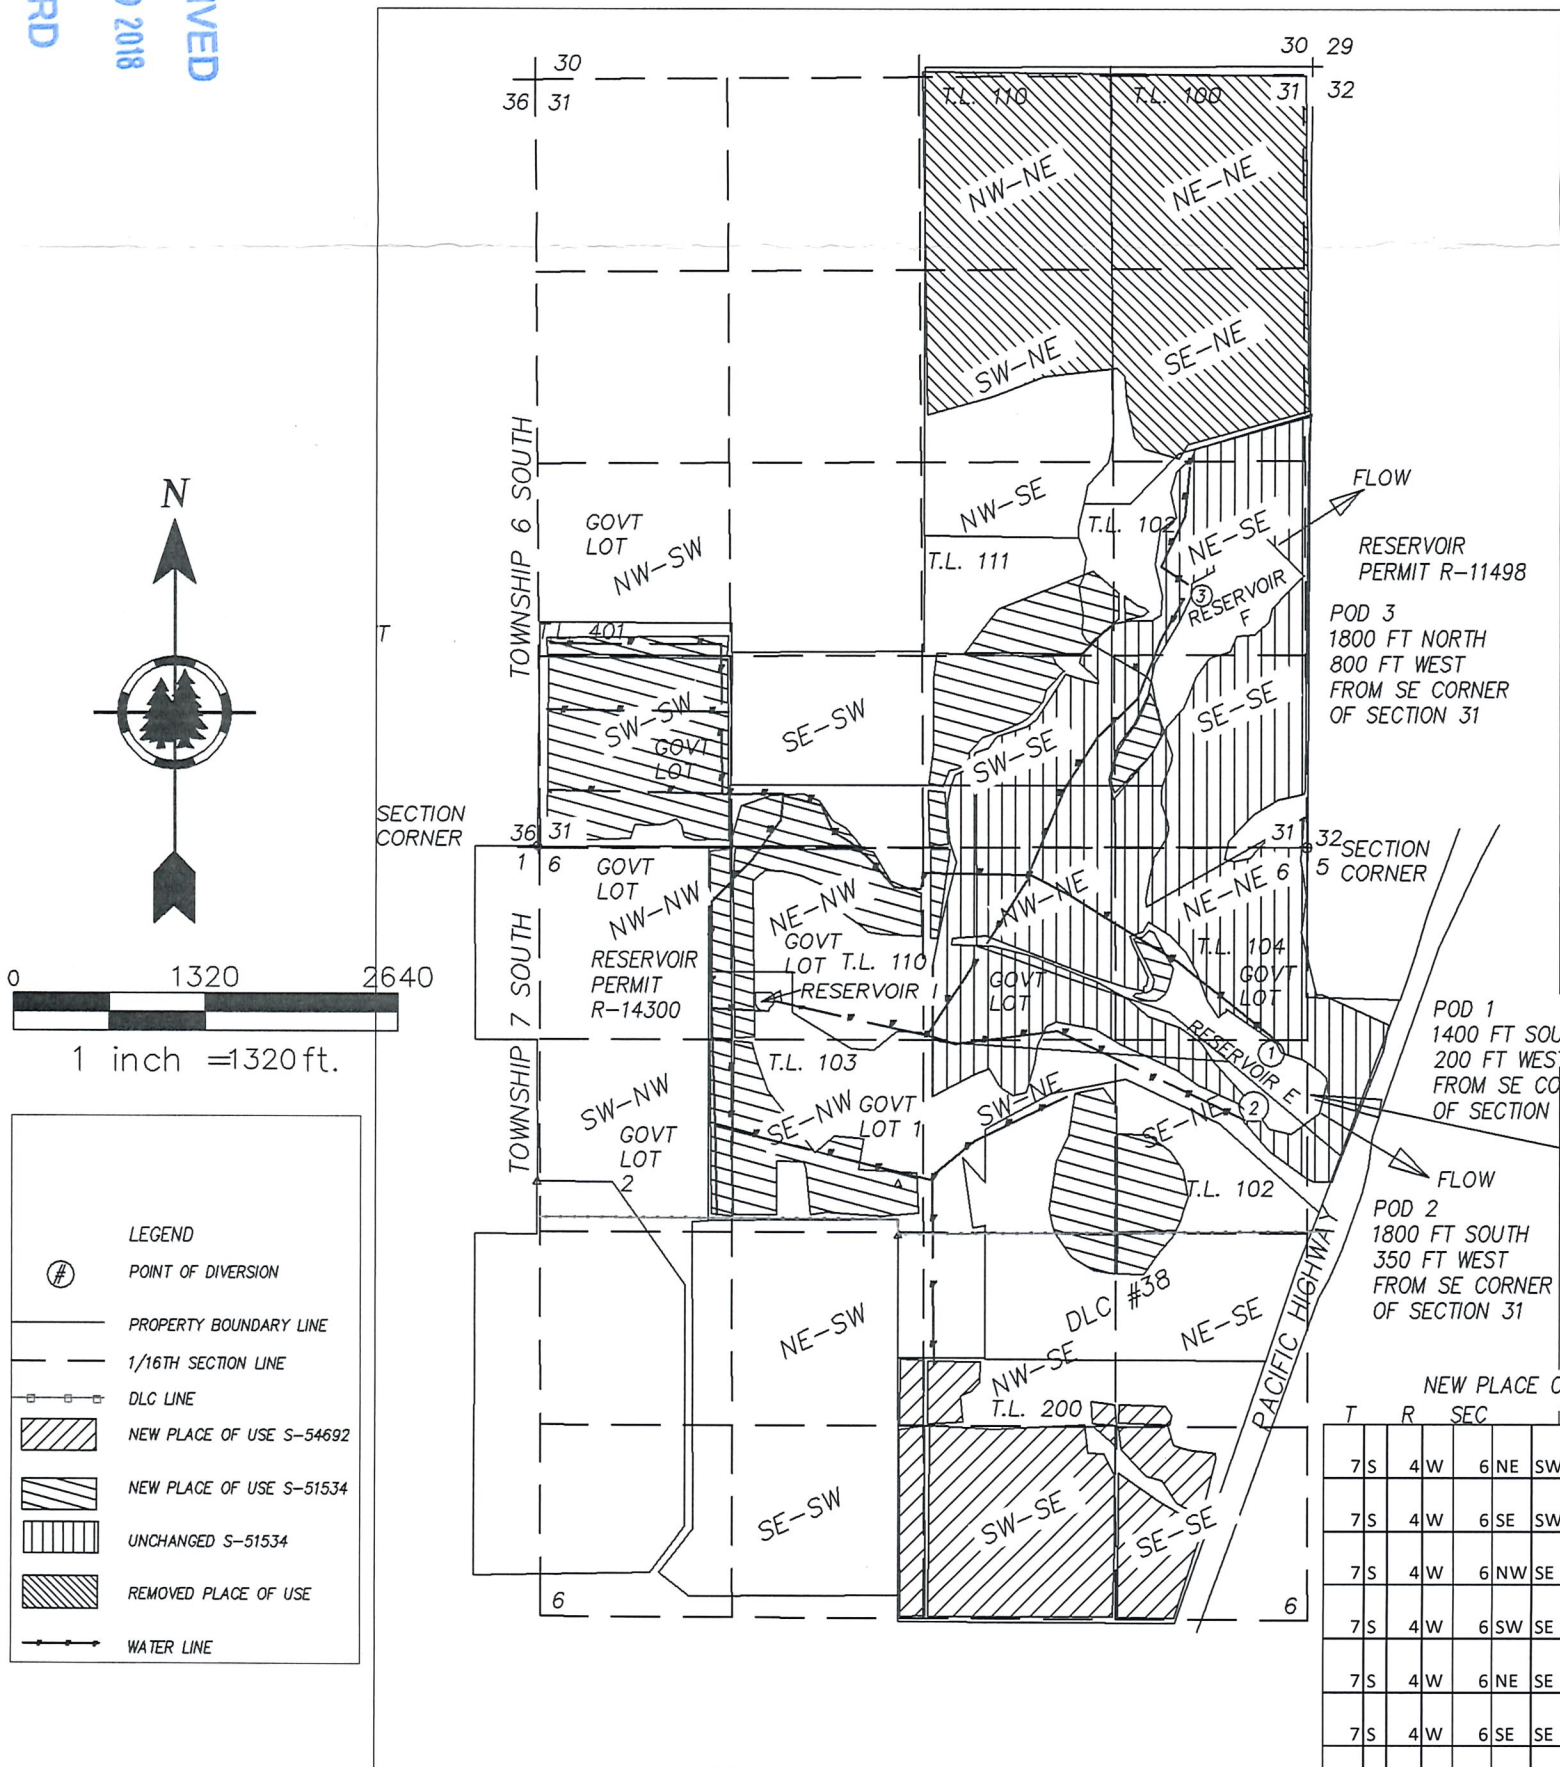

LEGEND

- POINT OF DIVERSION
- PROPERTY BOUNDARY LINE
- 1/16TH SECTION LINE
- DLC LINE
- NEW PLACE OF USE S-54692
- NEW PLACE OF USE S-51534
- UNCHANGED S-51534
- REMOVED PLACE OF USE
- WATER LINE

NEW PLACE OF USE PERMIT S-54692

T	R	SEC	TAX LT	DLC	ACRES	PRIORITY			
7S	4W	6	NE	SW	200	38	1.6	POD 1	Nov 8-2005
7S	4W	6	SE	SW	200	38	5.2	POD 1	Nov 8-2005
7S	4W	6	NW	SE	200	38	3.3	POD 1	Nov 8-2005
7S	4W	6	SW	SE	200	38	37.1	POD 1	Nov 8-2005
7S	4W	6	NE	SE	200	38	1.0	POD 1	Nov 8-2005
7S	4W	6	SE	SE	200	38	14.4	POD 1	Nov 8-2005
7S	4W	6	SW	NE	102	38	8.5	POD 2	Nov 8-2005

TOTAL 71.1 ACRES

# PERMIT AMENDMENT MAP

## APPLICATION S-72659 PERMIT S-51534 & APPLICATION S-86459 PERMIT S-54692

PREPARED FOR:  
LEFT COAST CELLARS  
4225 N PACIFIC HIGHWAY  
RICKREAL OR 97371

SECTION 31, T6S, R4W, WM TAX LOTS 102, 104, 110, 111 & 401  
SECTIONS 5 & 6 T7S R4W WM TAX LOTS 102, 103 & 200  
POLK COUNTY, OREGON

PREPARED FOR:  
LARUE FAMILY TRUST  
PO BOX 137  
RICKREAL OR 97371




Project: 316-075  
Map: WR Summary-C  
By: JEFFREY KEE  
Date: June 13, 2018

RECEIVED  
 JUN 29 2018  
 OVRD

NEW PLACE OF USE PERMIT S-51534

T	R	Sec	QTR	QTR	TAX LOT	GLO	ACRES	POD	PRIORITY
6S	4W	31	NW	SW	401	GOVTLT	3.5	1,2	8-Sep-92
6S	4W	31	SW	SW	401	GOVTLT	34.8	1,2	8-Sep-92
6S	4W	31	SE	SW	110		5.3	1,2	8-Sep-92
6S	4W	31	NW	SE	111, 102		8.5	3	8-Sep-92
6S	4W	31	NE	SE	102		0.3	3	8-Sep-92
6S	4W	31	SW	SE	111		12.2	3	8-Sep-92
6S	4W	31	SE	SE	111		2.4	3	8-Sep-92
7S	4W	6	NW	NW	110	GOVTLT	4	1,2	8-Sep-92
7S	4W	6	NE	NW	110	GOVTLT	12.4	1,2	8-Sep-92
7S	4W	6	SW	NW	103	GOVTLT 2	4	1,2	8-Sep-92
7S	4W	6	SE	NW	103	Govt LT 1	15.4	1,2	8-Sep-92
7S	4W	6	NW	NE	110	GOVTLT	4.2	1,2	8-Sep-92
7S	4W	6	NE	NE	110	GOVTLT	1.6	1,2	8-Sep-92
7S	4W	6	SE	NE	102		6.4	2	8-Sep-92
7S	4W	6	NW	SE	102		1.8	2	8-Sep-92
7S	4W	6	NE	SE	102		1.8	2	8-Sep-92
7S	4W	6	SW	NE	102		8.4		8-Sep-92
									8-Sep-92


127

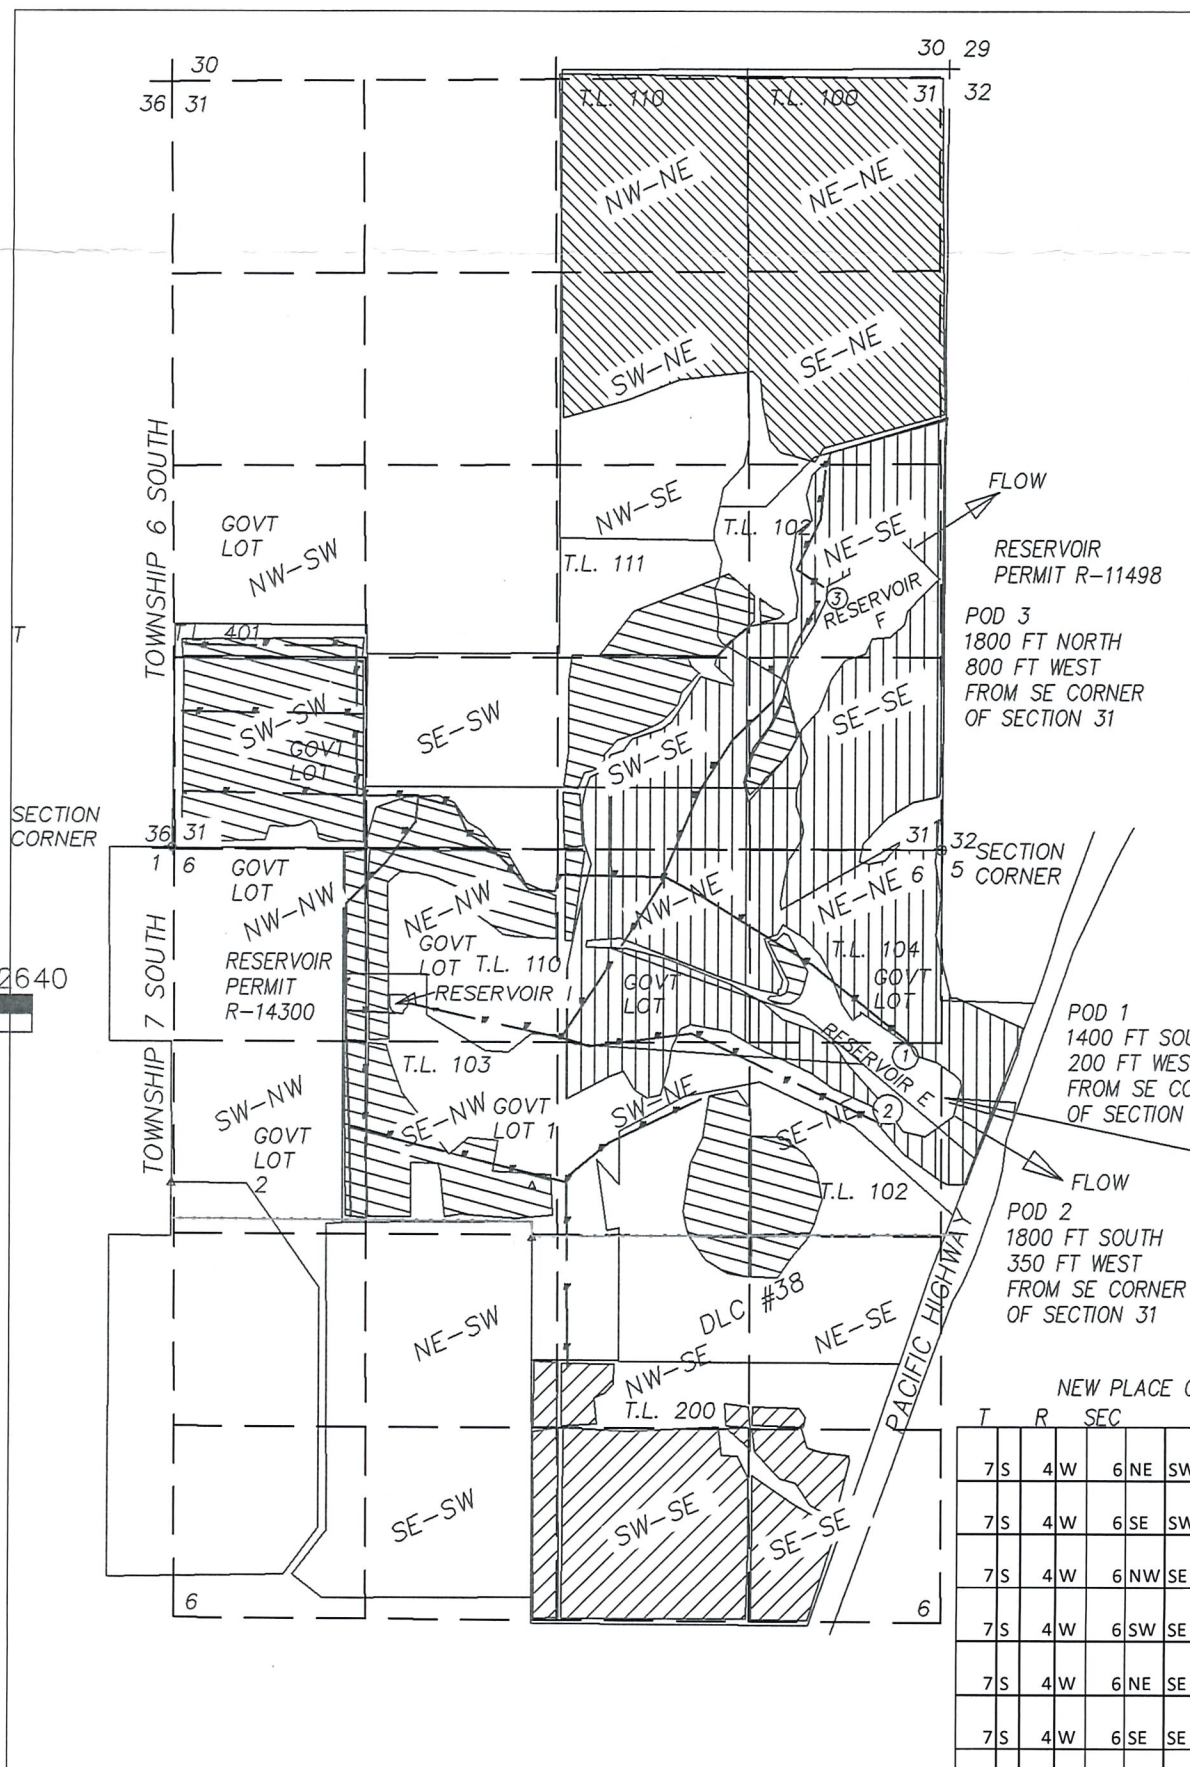

NEW PLACE OF USE PERMIT S-54692

T	R	SEC	TAX LT	DLC	ACRES	PRIORITY			
7S	4W	6	NE	SW	200	38	1.6	POD 1	Nov 8-2005
7S	4W	6	SE	SW	200	38	5.2	POD 1	Nov 8-2005
7S	4W	6	NW	SE	200	38	3.3	POD 1	Nov 8-2005
7S	4W	6	SW	SE	200	38	37.1	POD 1	Nov 8-2005
7S	4W	6	NE	SE	200	38	1.0	POD 1	Nov 8-2005
7S	4W	6	SE	SE	200	38	14.4	POD 1	Nov 8-2005
7S	4W	6	SW	NE	102	38	8.5	POD 2	Nov 8-2005

TOTAL 71.1 ACRES

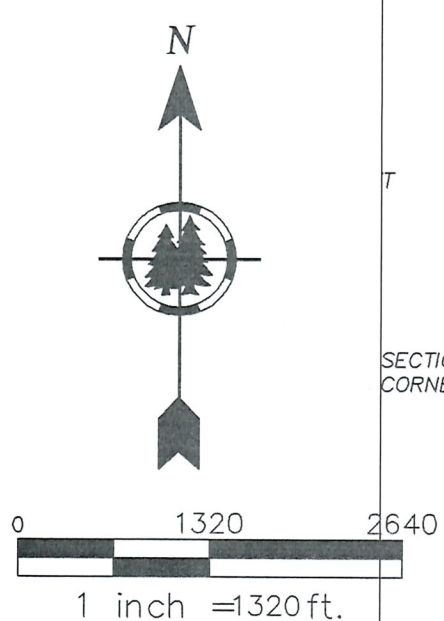

LEGEND

- POINT OF DIVERSION
- PROPERTY BOUNDARY LINE
- 1/16TH SECTION LINE
- DLC LINE
- NEW PLACE OF USE S-54692
- NEW PLACE OF USE S-51534
- UNCHANGED S-51534
- REMOVED PLACE OF USE
- WATER LINE