
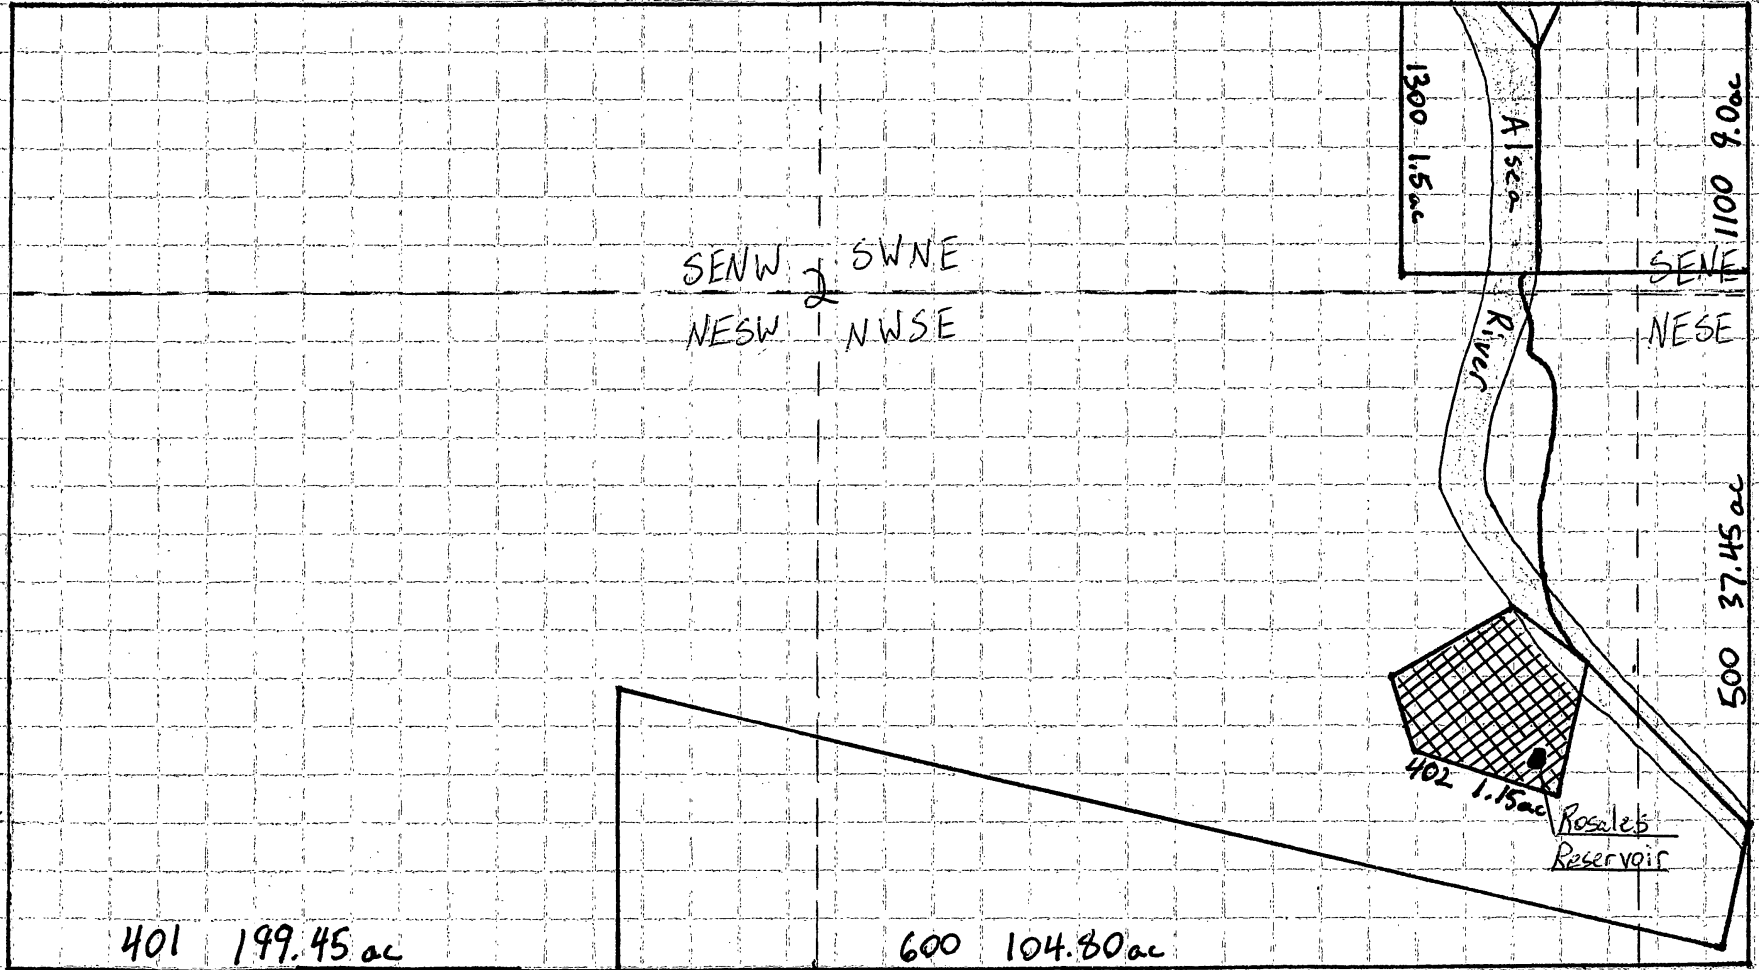


Twp 14 S, Rng 8 W, Sec 2, Q-Q NW SE

Taxlot #: 402

1" = 300'

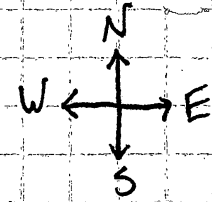

-Hatching indicating area of water use.

Surface water to be drawn from Rosales Reservoir (Permit R-15353).
 Rosales Reservoir located 826 feet South and 1,199 feet East from
 the center of Section 2.
 1 acre of land located on taxlot 402 in Quarter/Quarter NW SE
 of Section 2 will be utilizing the surface water for nursery
 operations.

5-88702

OWRD

JUN 05 2019

RECEIVED