


Human Consumption Place of Use Map

33S-2E-16-NW/NE Tax Lot 204

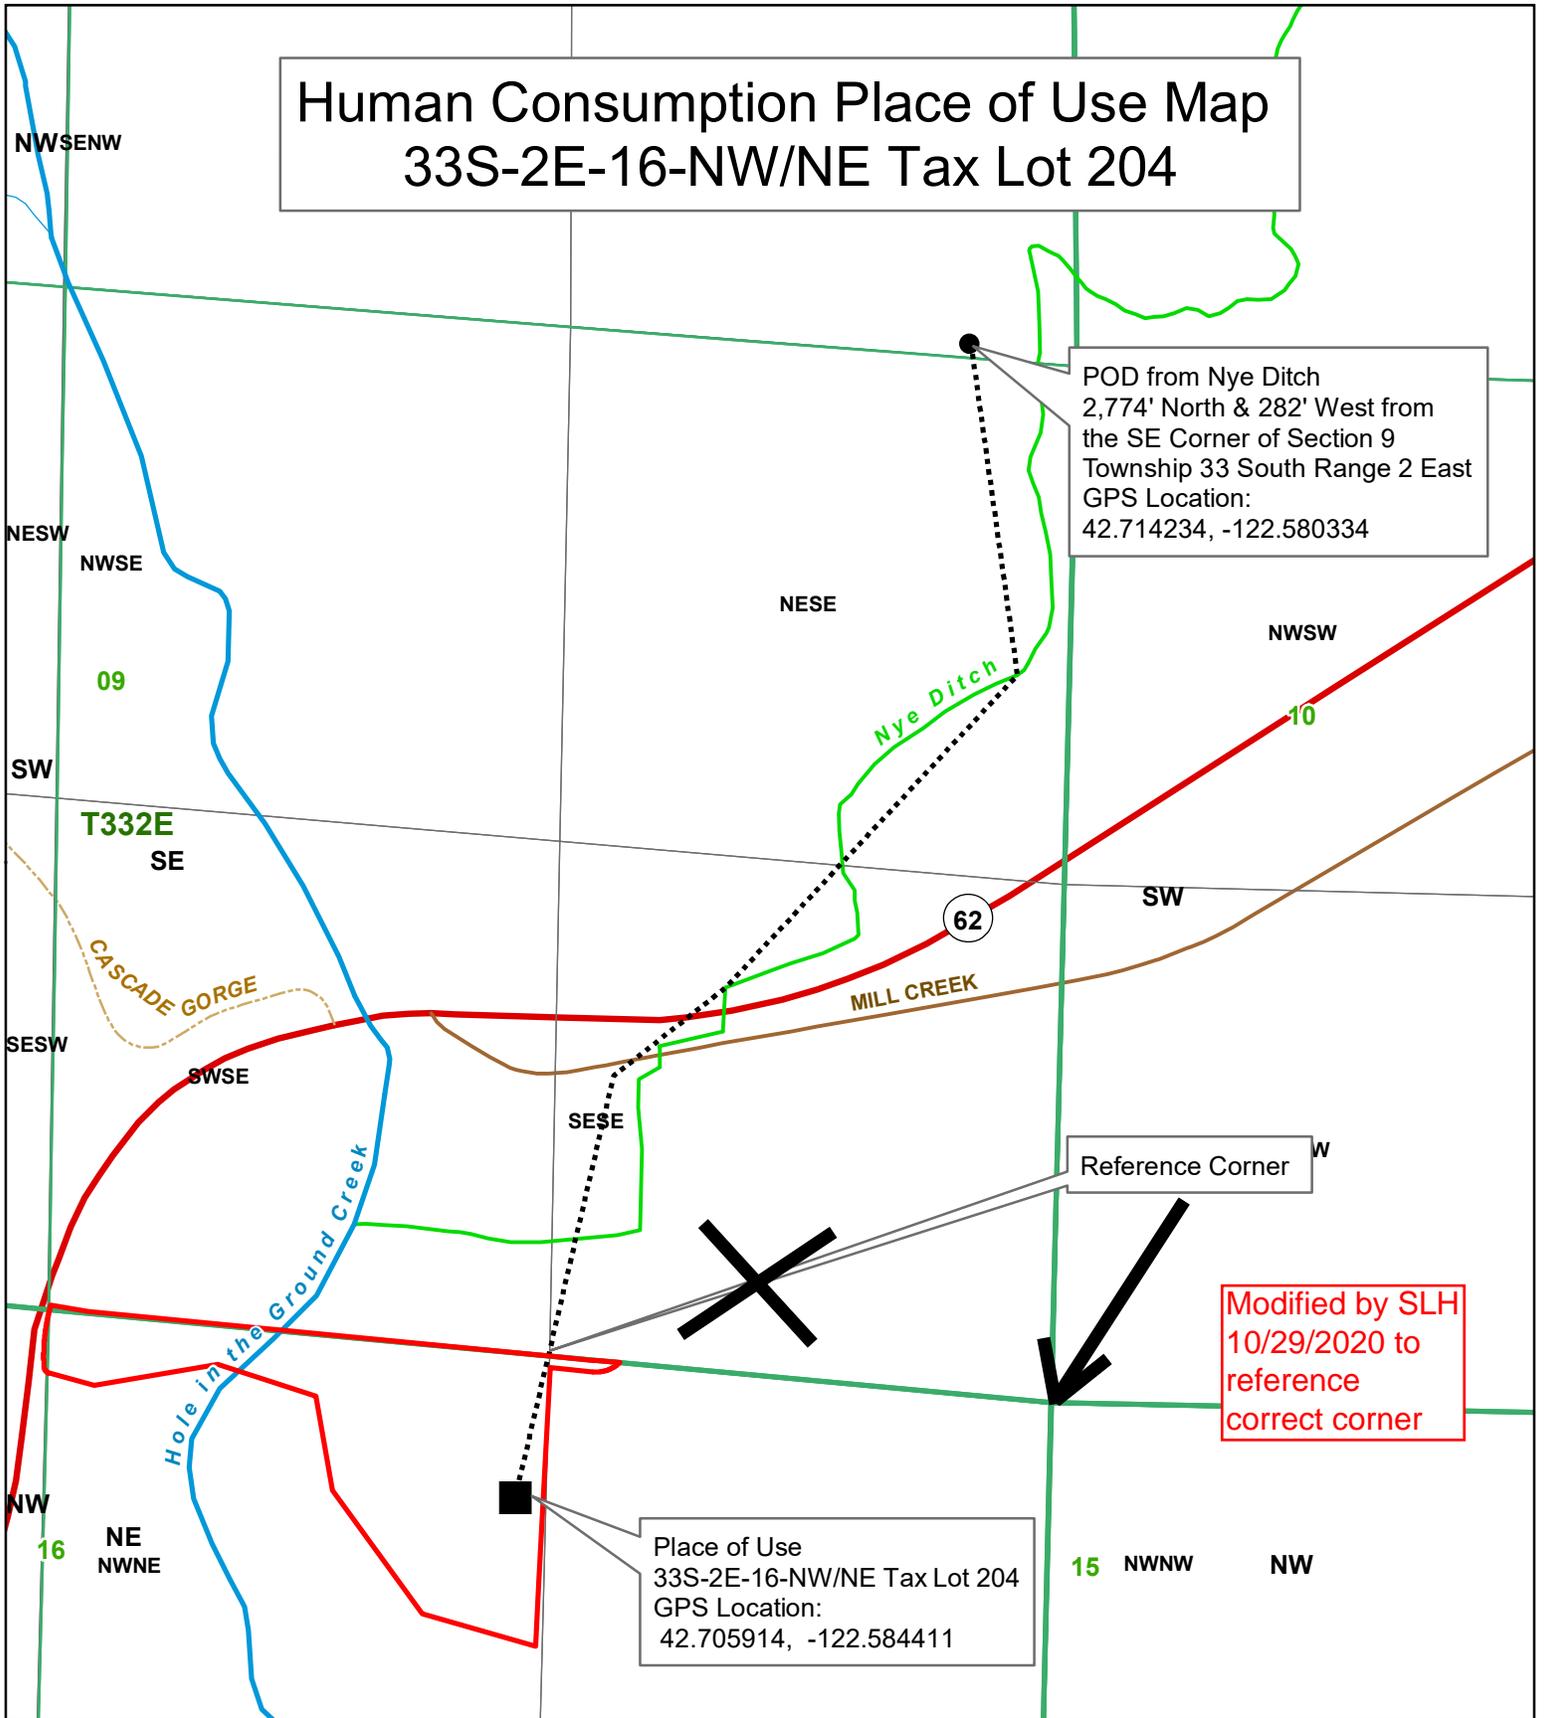

POD from Nye Ditch
 2,774' North & 282' West from
 the SE Corner of Section 9
 Township 33 South Range 2 East
 GPS Location:
 42.714234, -122.580334

Reference Corner


Modified by SLH
 10/29/2020 to
 reference
 correct corner

Place of Use
 33S-2E-16-NW/NE Tax Lot 204
 GPS Location:
 42.705914, -122.584411

Legend

- TL 204
- Quarter Sections
- Home Site
- Quarter Quarter Sections
- Townships
- POD from Nye Ditch
- 6" PVC Transport Pipe

1 inch = 500 feet

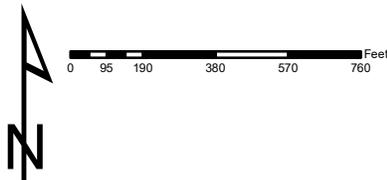

JACKSON COUNTY
WATERMASTER
 Staff

This map is based on a digital database compiled by Jackson County from a variety of sources. Jackson County cannot accept responsibility for errors, omissions, or positional accuracy. There are no warranties, expressed or implied.