

E-RECEIVED  
July 28, 2021  
OWRD

Supersede

Domestic Use

Rick Toothaker

Location: SW ¼ NW 1/4, Section 19, Township 36S, Range 03W, Tax lot 1900




Measured Distance: 1100 feet South and 75 feet East from North ¼ corner of Section 19

Scale- 1 inch=200 feet



Quarter Marker

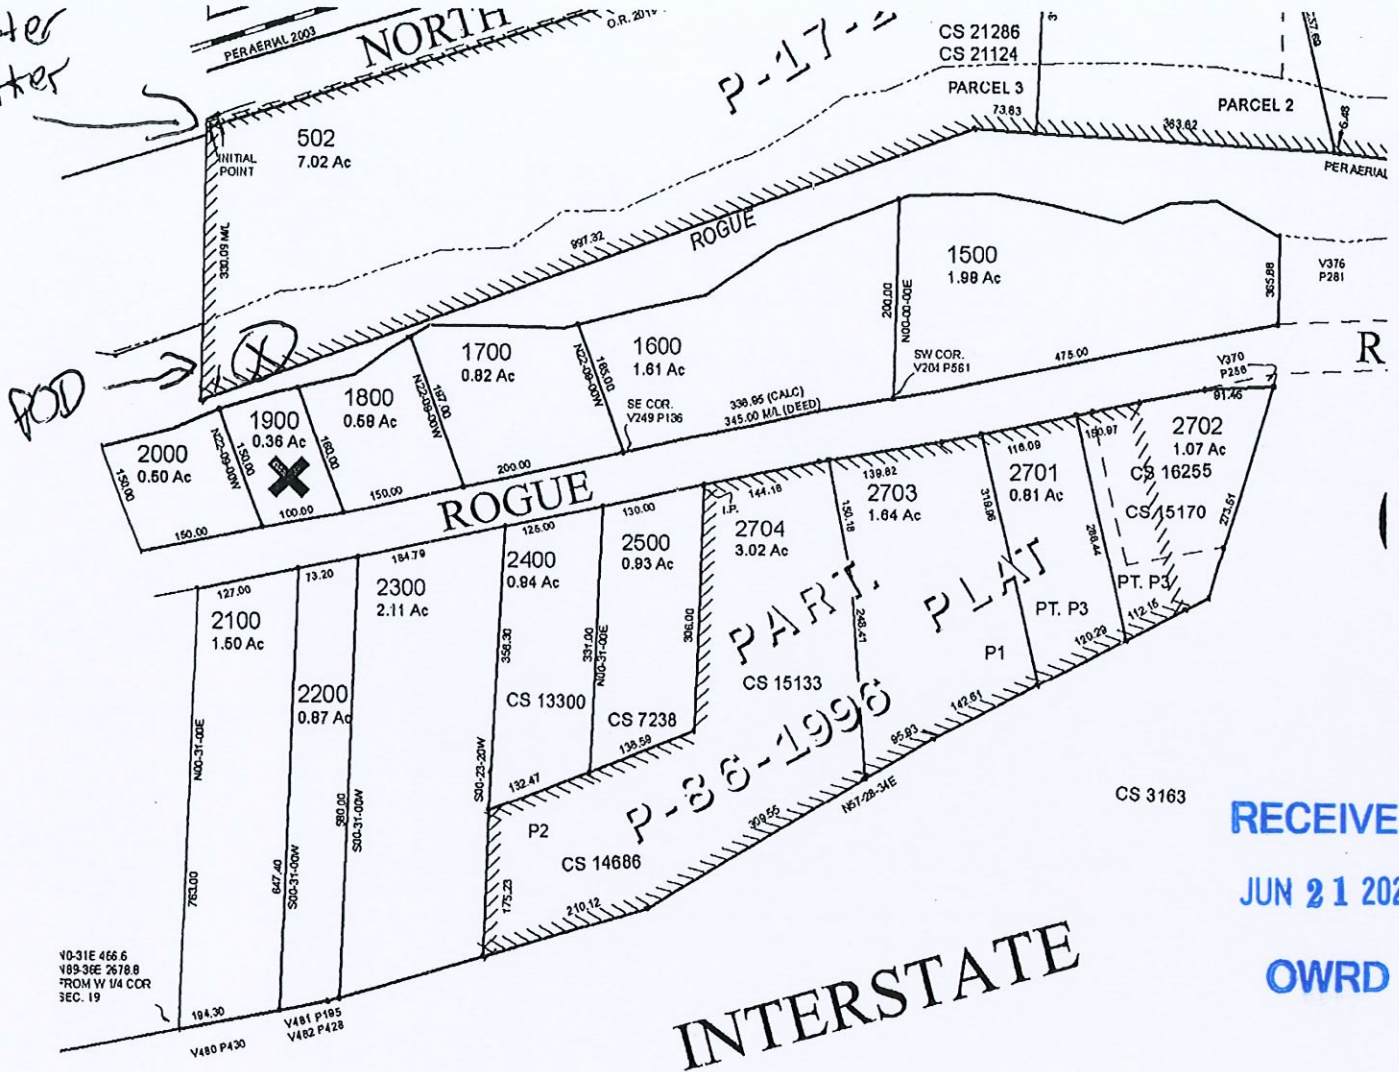


RECEIVED

JUN 21 2021

OWRD

V0-31E 466.6  
V89-36E 2678.8  
FROM W 1/4 COR  
SEC. 19

INTERSTATE

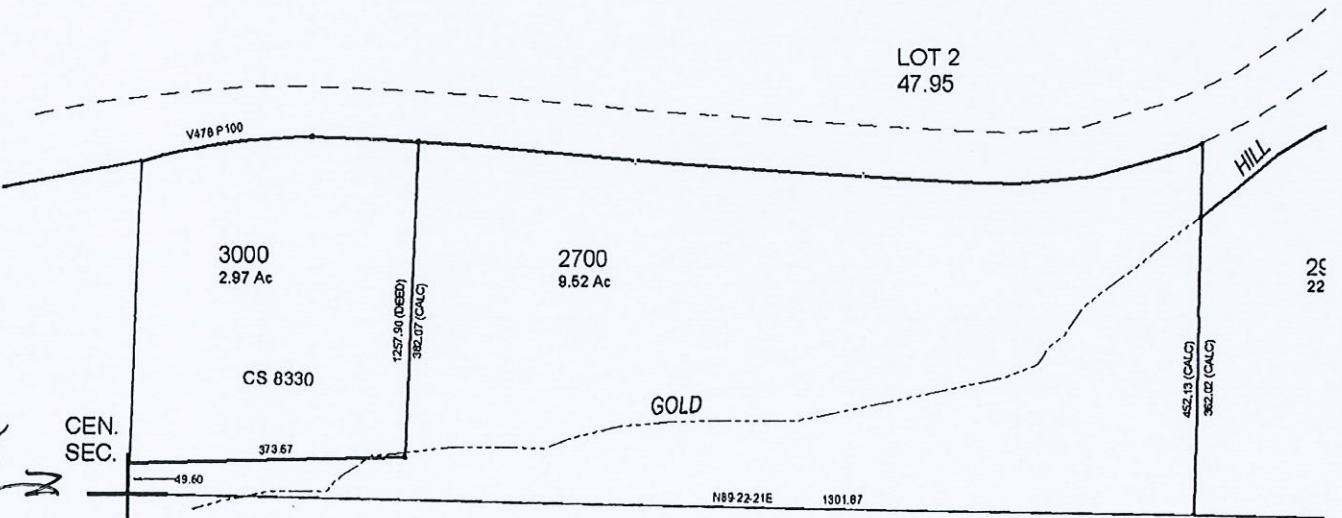

Quarter Marker

TOWNSHIP 36 RANGE 3W SECTION 19A

THIS MAP IS FOR LOCATION PURPOSES ONLY  
NO LIABILITY IS ASSUMED FOR VARIATIONS  
DISCLOSED BY SURVEY OR COUNTY RECORDS  
FIRST AMERICAN TITLE

↑

Lot is .36 acres

POD is approx ~~365~~ 365 ft North and  
75 ft east from SW  
Quarter marker.  
We are lot 1900 (marked).