


THIS MAP WAS PREPARED FOR ASSESSMENT PURPOSE ONLY

SECTION 8 T.24S. R.12W. W.M.
COOS COUNTY

24 12 8
CANCELLED

1" = 400'

SEE MAP 24 12 5

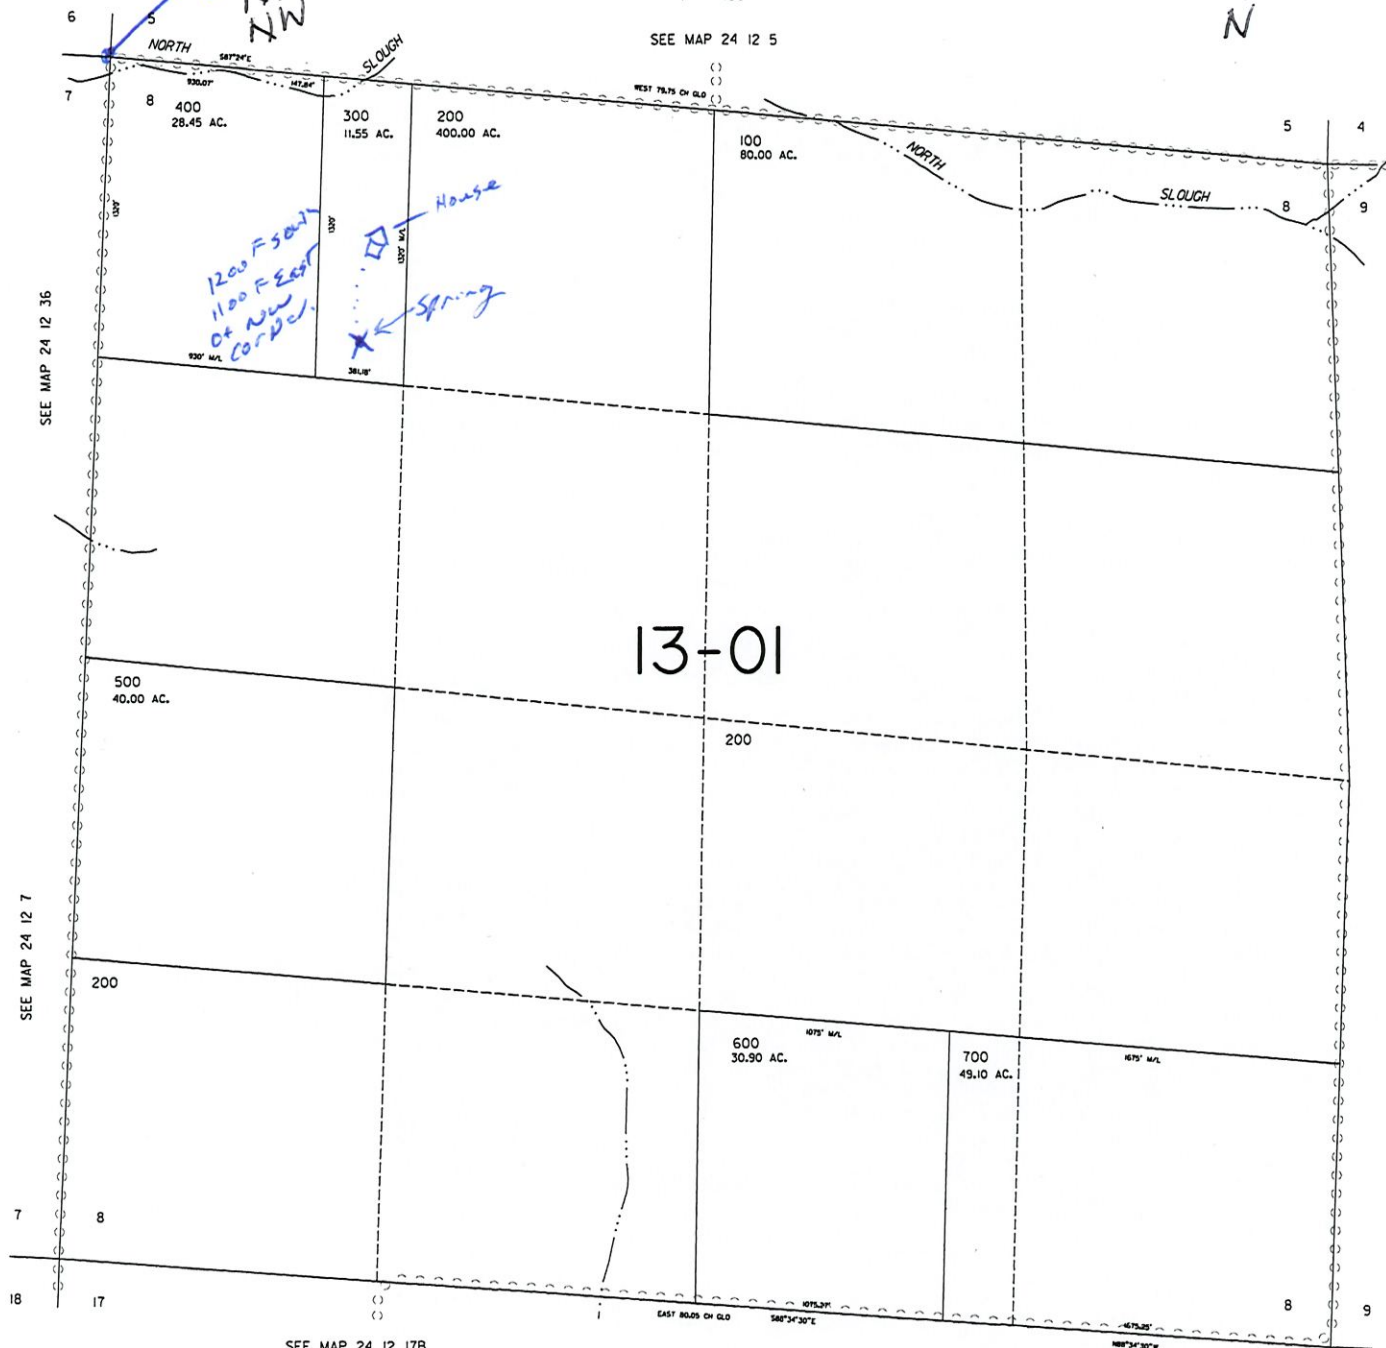

LEGEND
 X = UNNAMED SPRING
 = 1 INCH PIPE

RECEIVED
JUN 14 2021
OWRD

SEE MAP 24 12 17B

SEE MAP 24 12 17A

DATE

24 12 8