


THIS MAP IS FOR ASSESSMENT AND TAXATION PURPOSES ONLY

E-RECEIVED
August 8, 2022
OWRD

SEC. 10 T.7S. R.4W. W.M.
Polk County

1" = 400'

7.4.10

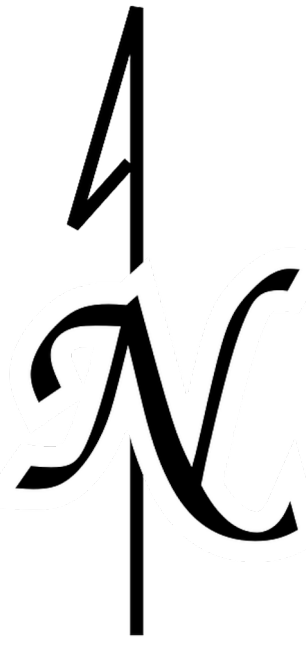

See Map 7.4.4

See Map 7.4.3

See Map 7.4.3

13-25

13-17

Canceled No.

200
1001

Legend

Place of Use

Pump POD Location: 1590' North and 210' West of SE Corner of Richard McMahan DLC 40

Pond #2 POD Location: 1450' North and 210' East of SE Corner of Richard McMahan DLC 40

Pond #3 POD Location: 1370' North and 460' East of SE Corner of Richard McMahan DLC 40

See Map 7.4.9

See Map 7.4.11

POD Location Reference Corner

N'LY N.W. CORNER CLAIM NO. 41

See Map 7.4.9

See Map 7.4.15

See Map 7.4.15

2/14/2019

7.4.10

