



ArcGIS Web Map

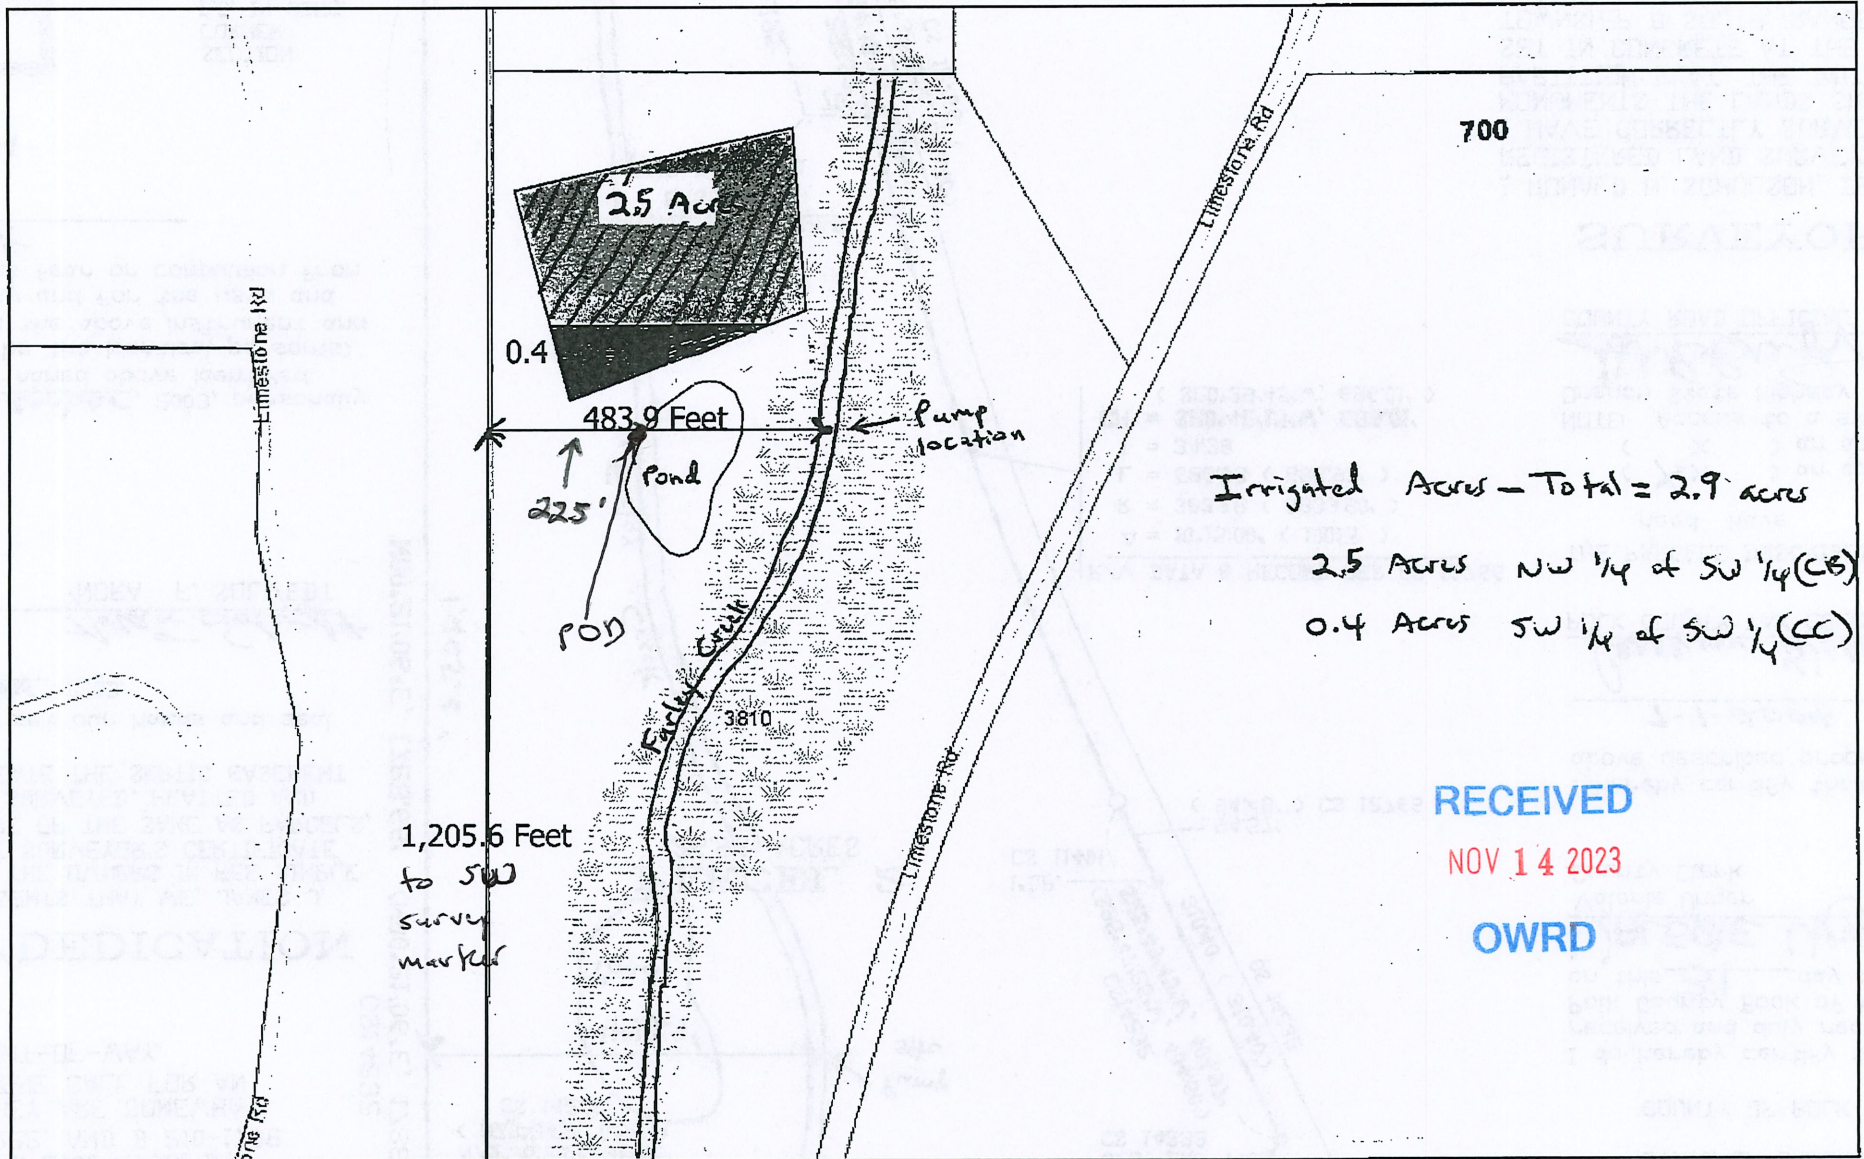

5/21/2021, 10:14:29 AM


- Taxlots
- Section
- Township / Range Anno
- Township / Range
- Dallas Addresses
- Salem Addresses

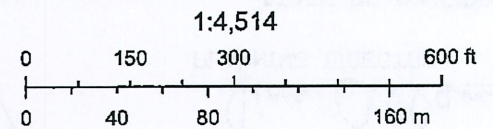

Bureau of Land Management, State of Oregon, State of Oregon DOT, State

Polk County GIS

ArcGIS Web Map

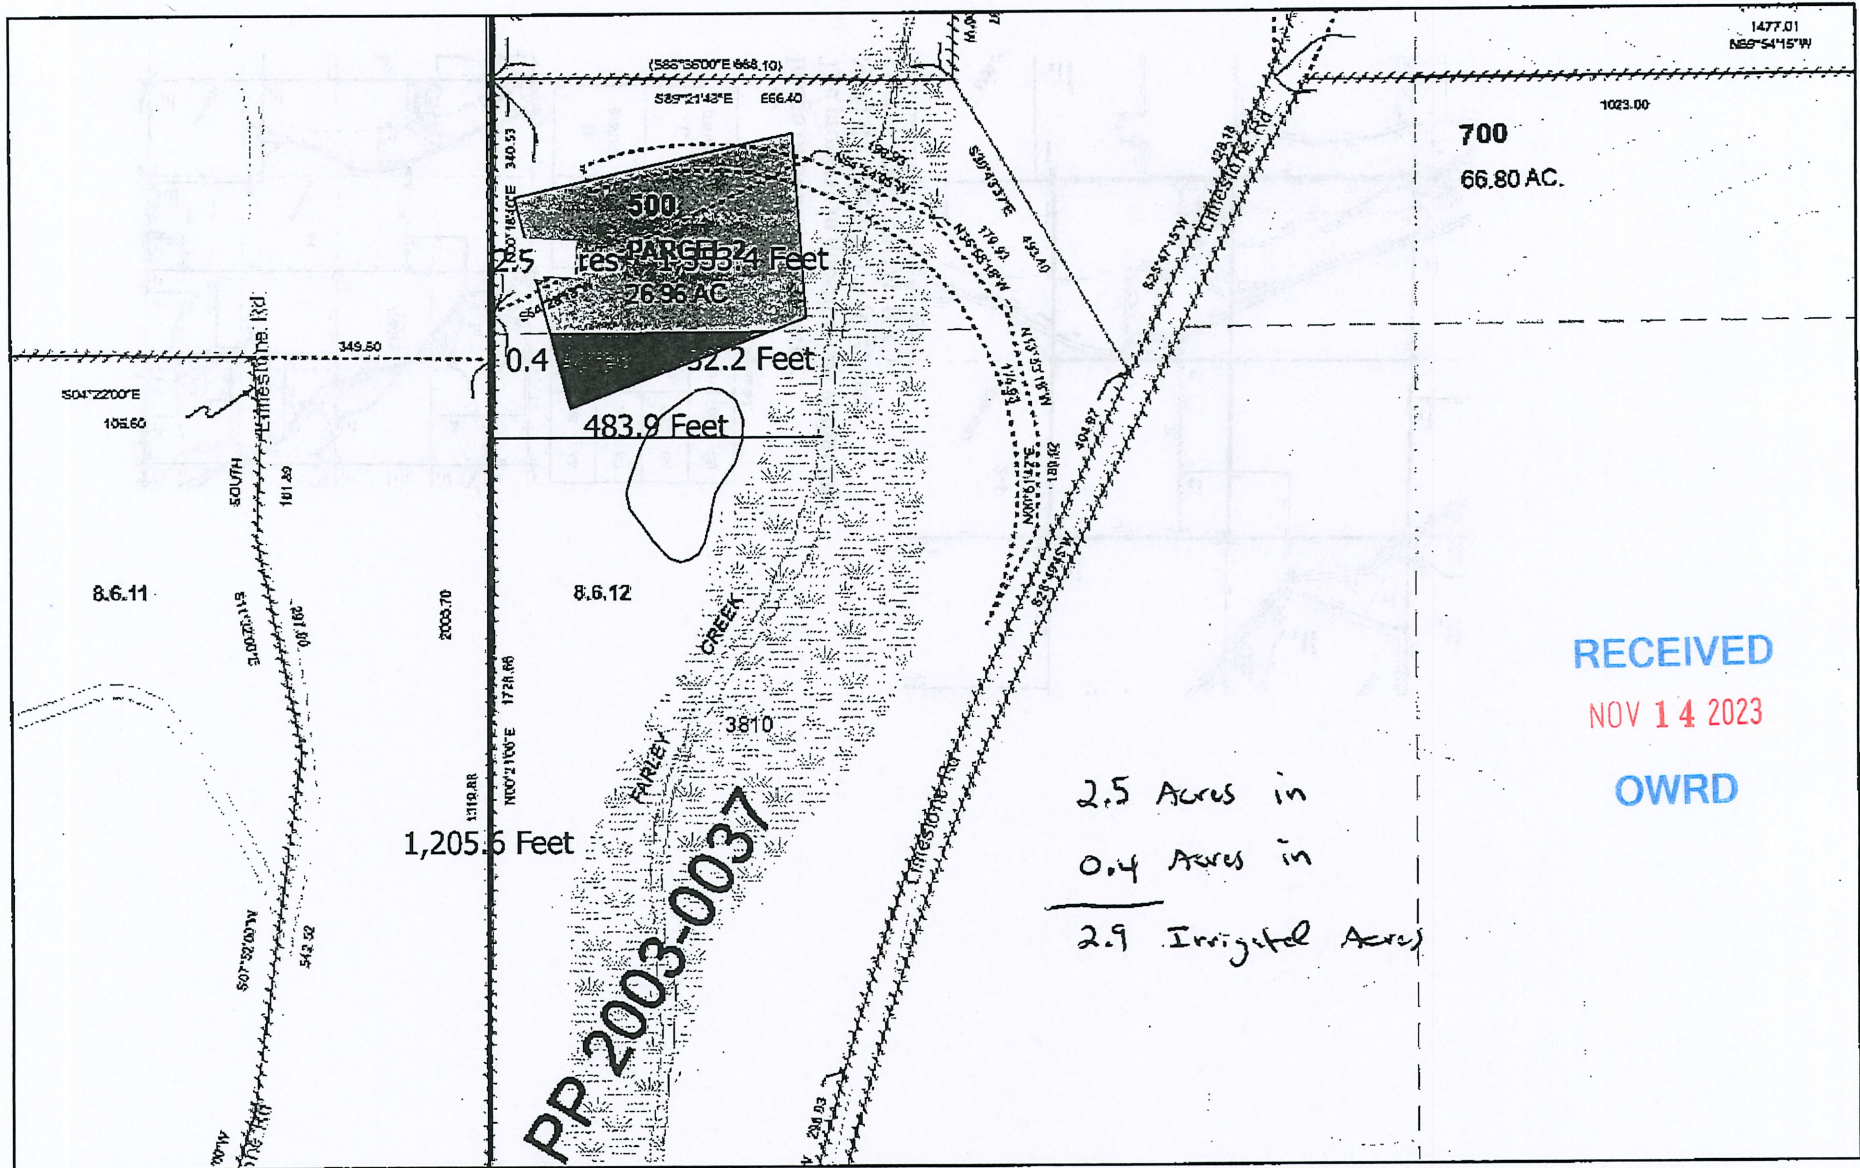


RECEIVED
 NOV 14 2023
 OWRD

2.5 Acres in
 0.4 Acres in

 2.9 Irrigated Acres


5/21/2021, 10:09:49 AM

- Taxlots
- PLSSLines
- + 22-Section Corner
- WaterLines
- Historical Boundary
- Cartographic lines
- Anno Arrow
- Bearing / Distance Hook
- ReferenceLines
- Historical Boundary
- Anno Arrow

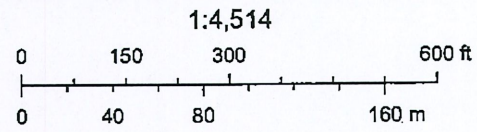


Bureau of Land Management, State of Oregon, State of Oregon DOT, State

ArcGIS Web Map

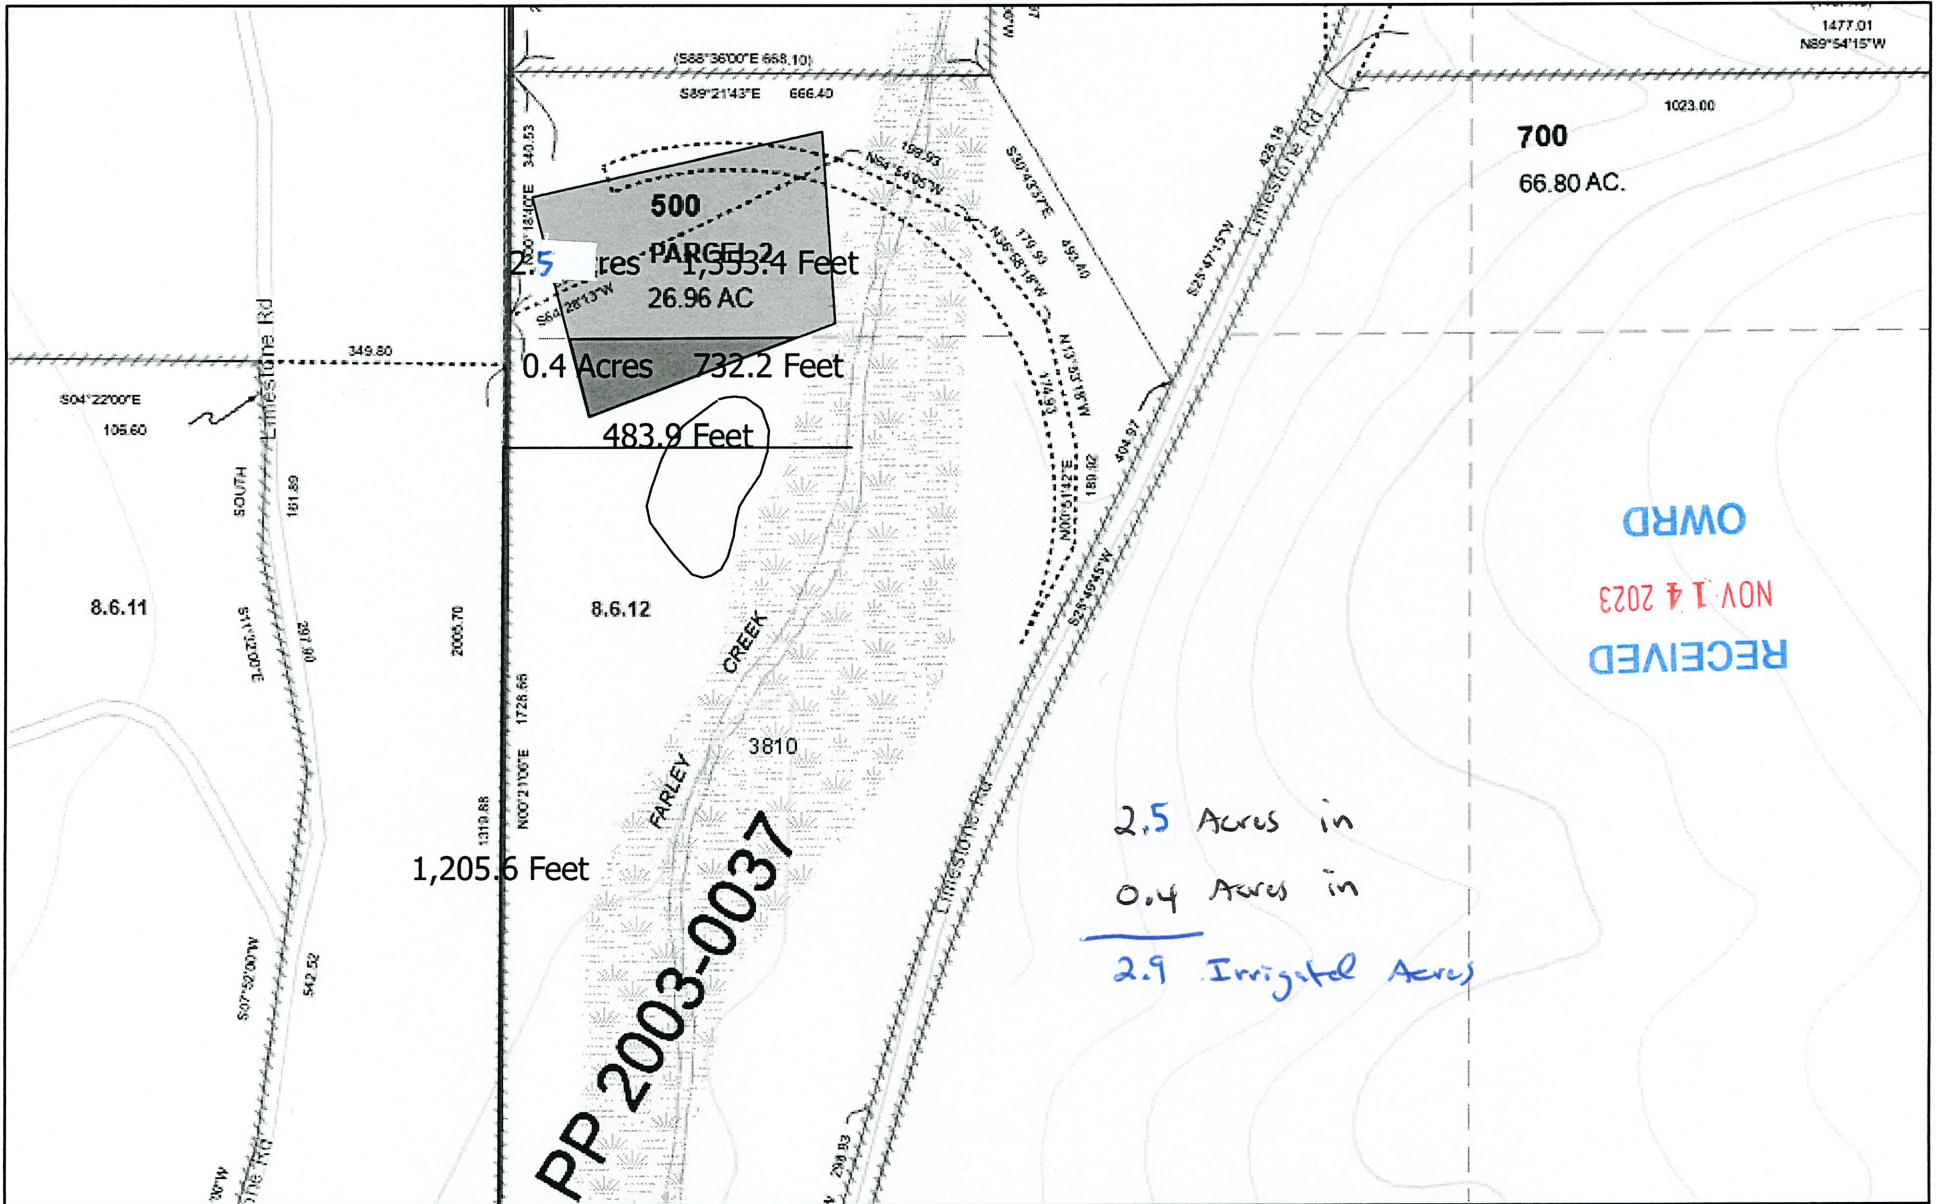

5/21/2021, 10:09:49 AM

- | | | | |
|-------------------|---------------------|-------------------------|---------------------|
| Taxlots | WaterLines | Cartographic lines | ReferenceLines |
| PLSSLines | Historical Boundary | Anno Arrow | Historical Boundary |
| 22-Section Corner | | Bearing / Distance Hook | Anno Arrow |

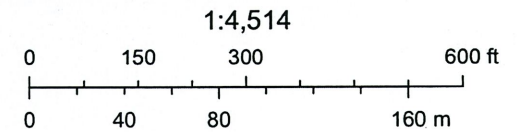

Bureau of Land Management, State of Oregon, State of Oregon DOT, State

THIS MAP IS FOR ASSESSMENT AND TAXATION PURPOSES ONLY

SEC. 12 T.8S. R.6W. W.M.
Polk County
1" = 400'

8.6.12

See Map 8.6.1

PT. 1992-0045

PT 1993-0022

2-4

Cancelled No.

- 104.
- 106.
- 111.
- 200.
- 201.
- 400T1
- 400.
- 403.
- 490.
- 600T1
- 600T2
- 600.
- 902.
- 903.
- 1300
- 1301
- 1302
- 1303

See Map 8.6.11

See Map 8.5.7

RECEIVED
NOV 14 2023
OWRD

2-6

1992-0021

PP 2003-0037

See Map 8.6.13

N.W. CORNER
JOHN BERGH
DLC NO. 37

8.6.12

10/30/2020

505'
from Survey
monument to
center of
Farley Creek
Pump site.

