
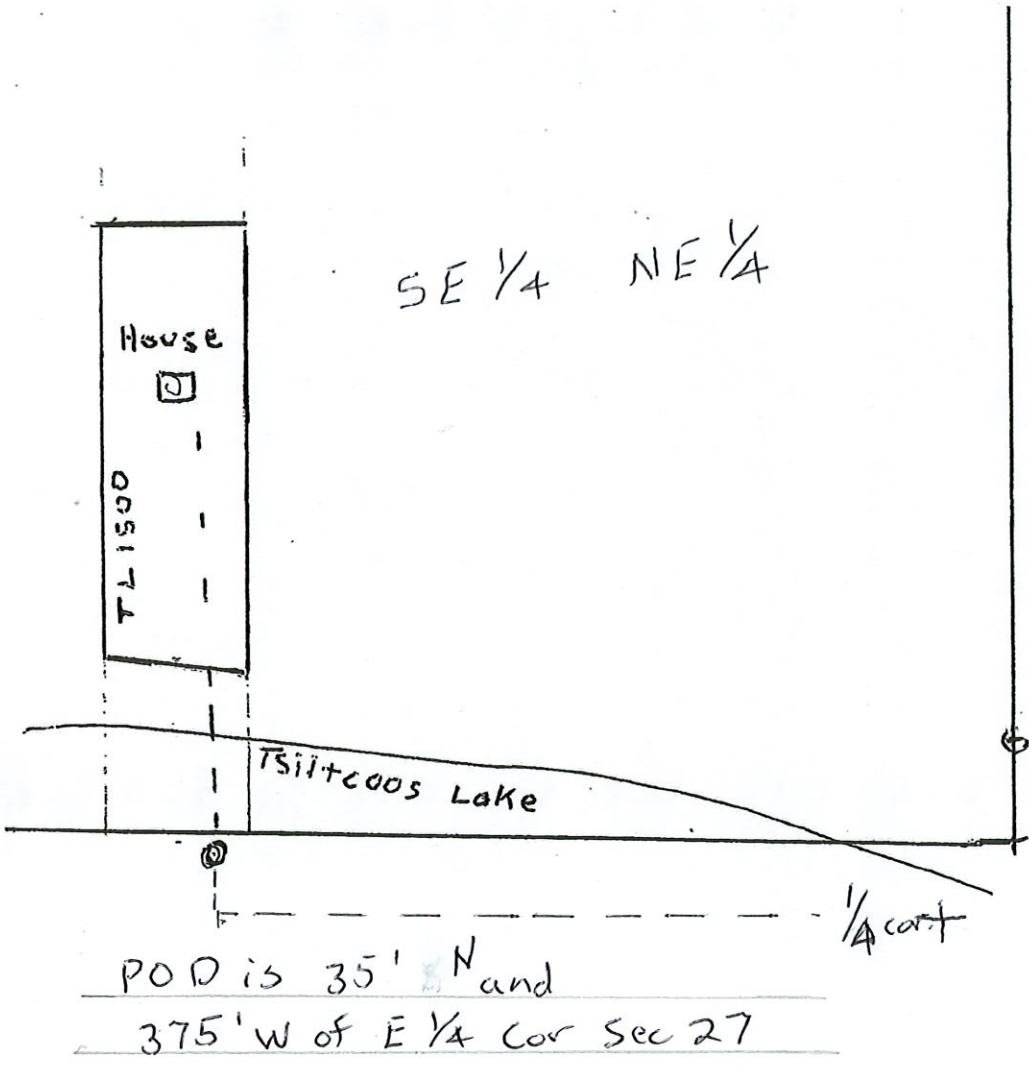


T 19 S, R 12 W Sec 27

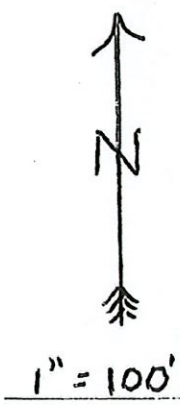

RECEIVED
JUL 03 2023
OWRD

Amended Map App 5-89327