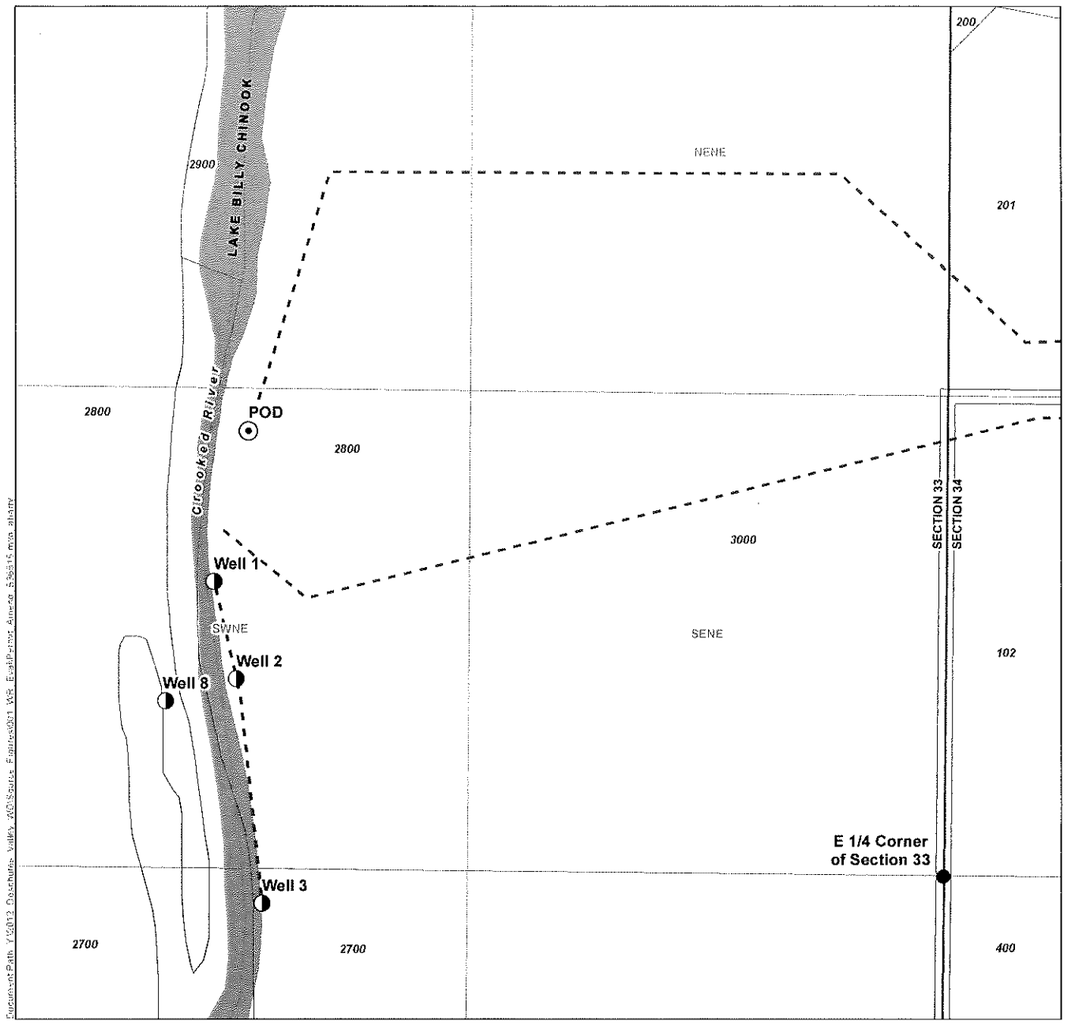

LEGEND

- Authorized Point of Diversion (POD)
- Proposed Point of Appropriation (POA)
- Pipeline
- Tax Lot
- Watercourse
- Waterbody

Permit Amendment Application
Deschutes Valley Water District
Authorized Point of Diversion and Proposed Points of Appropriation

Permit S-36515

Jefferson County
Township 12 South, Range 12 East (W.M.)

LOCATION DESCRIPTION

Authorized Point of Diversion
Located 1215 feet North and 1939 feet West from the E 1/4 corner of Section 33, Township 12 South, Range 12 East (W.M.)

Proposed Points of Appropriation

Well 1
Located 815 feet North and 2023 feet West from the E 1/4 corner of Section 33, Township 12 South, Range 12 East (W.M.)

Well 2
Located 545 feet North and 1960 feet West from the E 1/4 corner of Section 33, Township 12 South, Range 12 East (W.M.)

Well 3
Located 78 feet South and 1890 feet West from the E 1/4 corner of Section 33, Township 12 South, Range 12 East (W.M.)

Well 8
Located 475 feet North and 2169 feet West from the E 1/4 corner of Section 33, Township 12 South, Range 12 East (W.M.)

RECEIVED
MAR 08 2023
OWRD

DISCLAIMER
This map was prepared for the purpose of identifying the location of a water right only and it is not intended to provide legal dimensions or location of property ownership lines.

Date: January 31, 2023
Data Sources: BLM, ESRI, OWRD, USGS, Jefferson Co., Newton Consultants (2017)

N
0 200 400
1 inch = 400 feet

GSI Water Solutions, Inc.

14183

RECEIVED
MAR 01 2023
OWRD

R12E R13E

R13E R14E

T9S T10S

T10S T11S

T11S T12S

T12S T13S

Warm Springs

Gateway Tank

Plains Tank

Round Butte Tank

Madras

Lake Billy Chinook

Metolius

Metolius Tanks

Culver

KOA Tank

Haystack Reservior

Juniper Tank

Main Tanks

Opal Springs - POD

Certified Water Right Examiner
OREGON
DAVID J. NEWTON
JAN. 16, 1996
STATE OF OREGON

5,280' 0' 5,280' 10,560'

SCALE: 1" = 5,280'

Notes

1. This map was prepared for the purpose of identifying the location of water rights only and is not intended to provide legal dimensions or locations of property ownership lines.

Explanation

POD - Opal Springs, Permit S-36515
1,215.44 ft North and 1,939.8 ft West
from the East 1/4 Corner of Section 33
Being Within SW-NE of Section 33
Township 12.S, Range 12.E, W.M.

Areas With 1/4-1/4's Gridded Represent Place of Use Listed on Permit S-36515

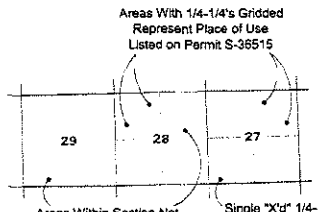

Areas Within Section Not Gridded Are Not Listed As Place of Use on Permit S-36515

Single "X'd" 1/4-1/4's Represent Single 1/4-1/4 Not Listed As Place of Use on Permit S-36515.

RECEIVED
SEP 20 2007
WATERRESOURCES DEPT
SALEM OREGON

NO.	DATE	BY	REVISIONS

PATH: G:\0400\450\108\Cad\Water\W450108_F1_CBU 14:27 09/14/2007 SS

NEWTON CONSULTANTS INC.
Earth, Water and Rock Specialists
Ph: 541 504-9960 Fax: 541 504-9981

NORTH

Claim of Beneficial Use - Permit S-36515
Service Area Boundary
Deschutes Valley Water District
Deschutes County, Oregon

PROJECT NO:	DATE:	FIGURE
450-108	May 2007	1
DESIGNED BY: M.Perle	DRAWN BY: S.Schenck	

14183