


MAP OF
W. E. ROBERTS PIPE LINE
In N.W. ¼, Sec. 35, T. 1 S., R. 1 E., W.M.

Aug. 1922

Scale 2" = 1 MILE

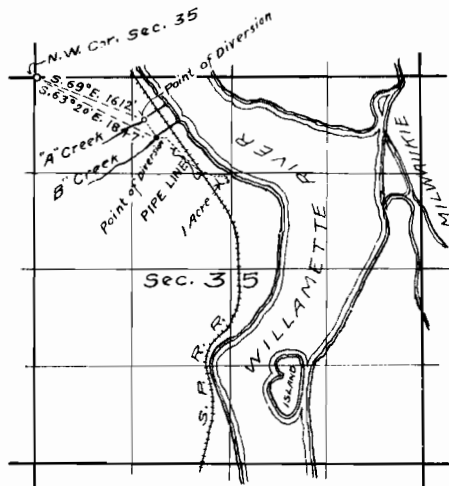

Approved:

86-85

Accepted:

5580