


2408

STATE ENGINEER
RECEIVED

T. 35 S. R. 12 W. R. 11 W.

SEP 18 1922 I hereby certify that this map was made from the notes of an actual survey made by me, and that it accurately shows the situation of the ditch, and land to be watered, also the location of streams and ditches in the immediate vicinity.

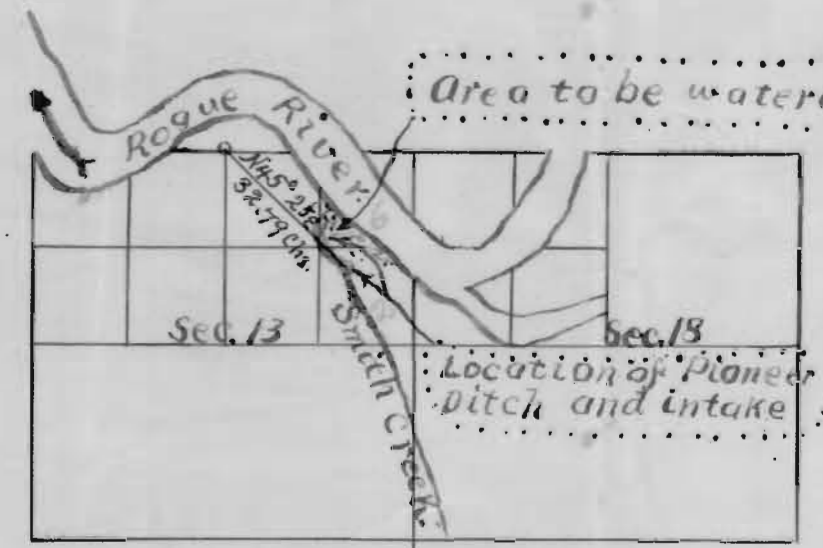

Application No. 8646
Permit No. 5627

Appl. 8646
Permit 5627

R. J. Canfield
Surveyor.

SP 77