


MAP

Accompanying final proof of Edmund Peile of Trail Oregon of Appl. No. 8746  
Permit No. 5723 to waters of Long Branch tributary to Rogue River  
Jackson County Oregon for Irrigation purposes

Dec 1930

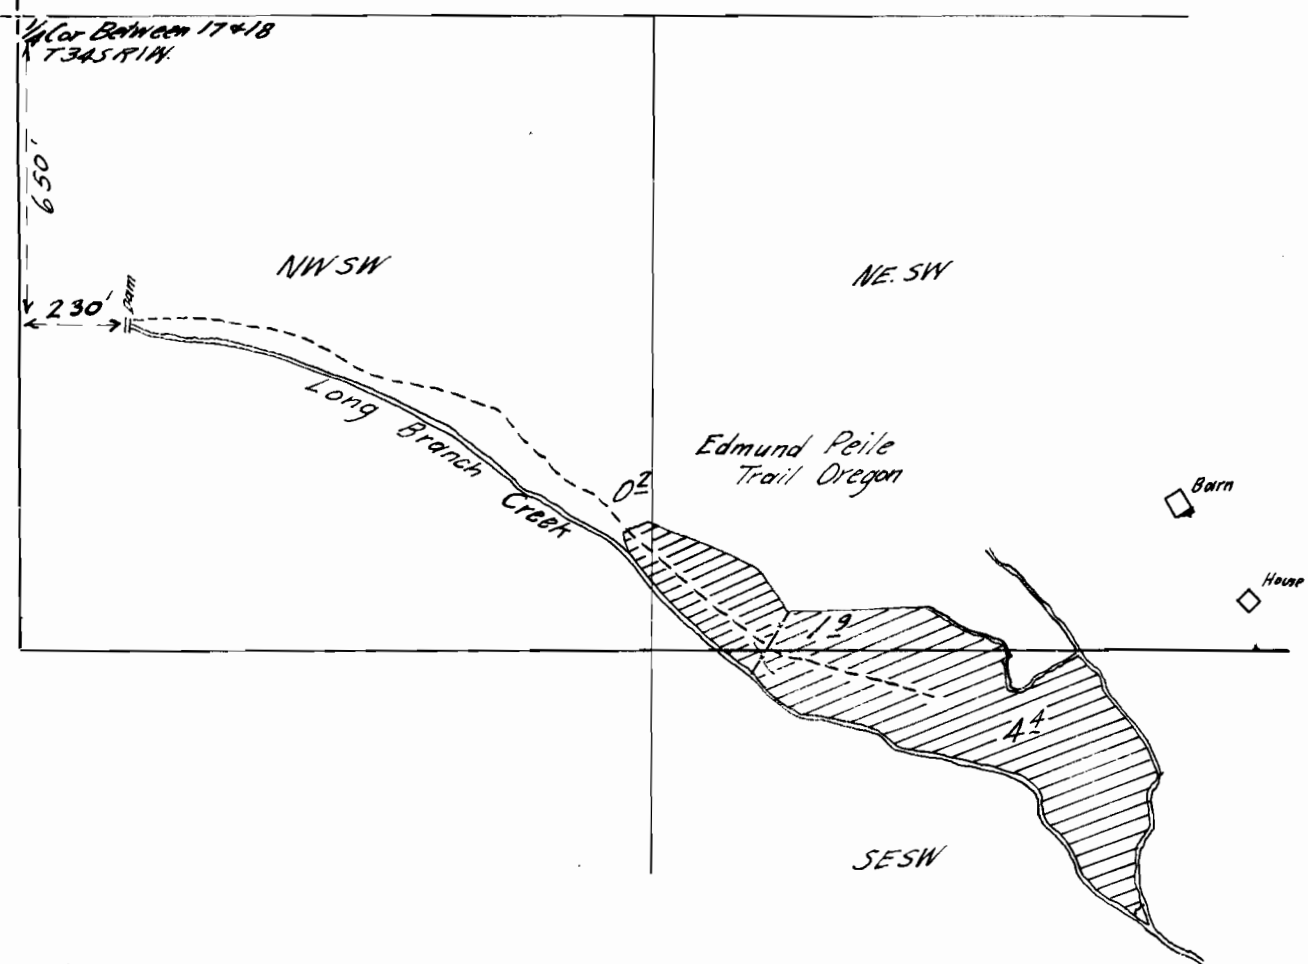

Map made from Plane Table Survey by Chester A. Cummings