


Map to accompany application of Henry Feldscher
to appropriate water for irrigation.

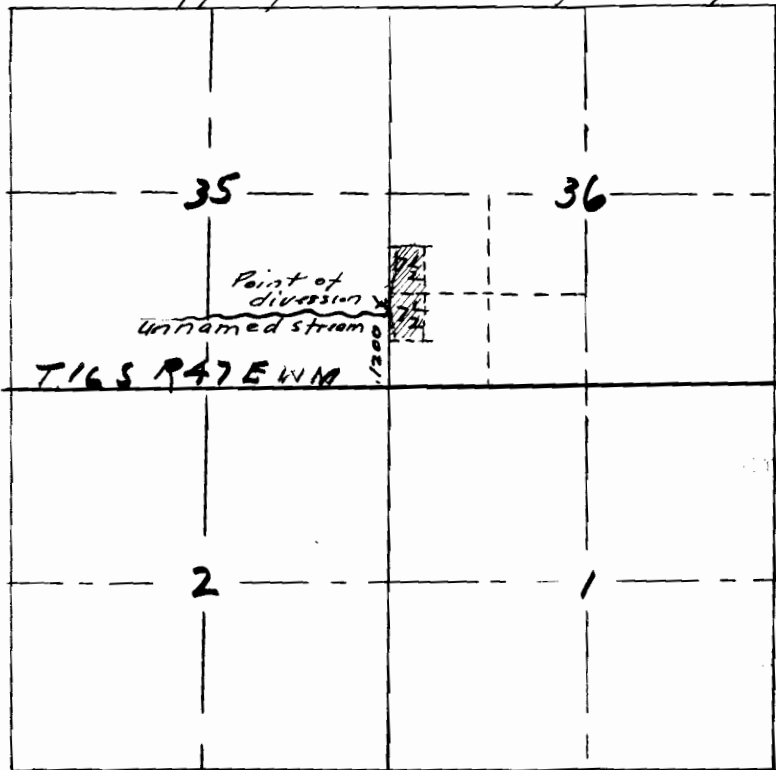

Scale 2 inches = 1 mile



8778

5739