


Township 4 S,

Range 2 E.

STATE ENGINEER  
RECEIVED  
JAN 13 1923  
SALEM, OREGON

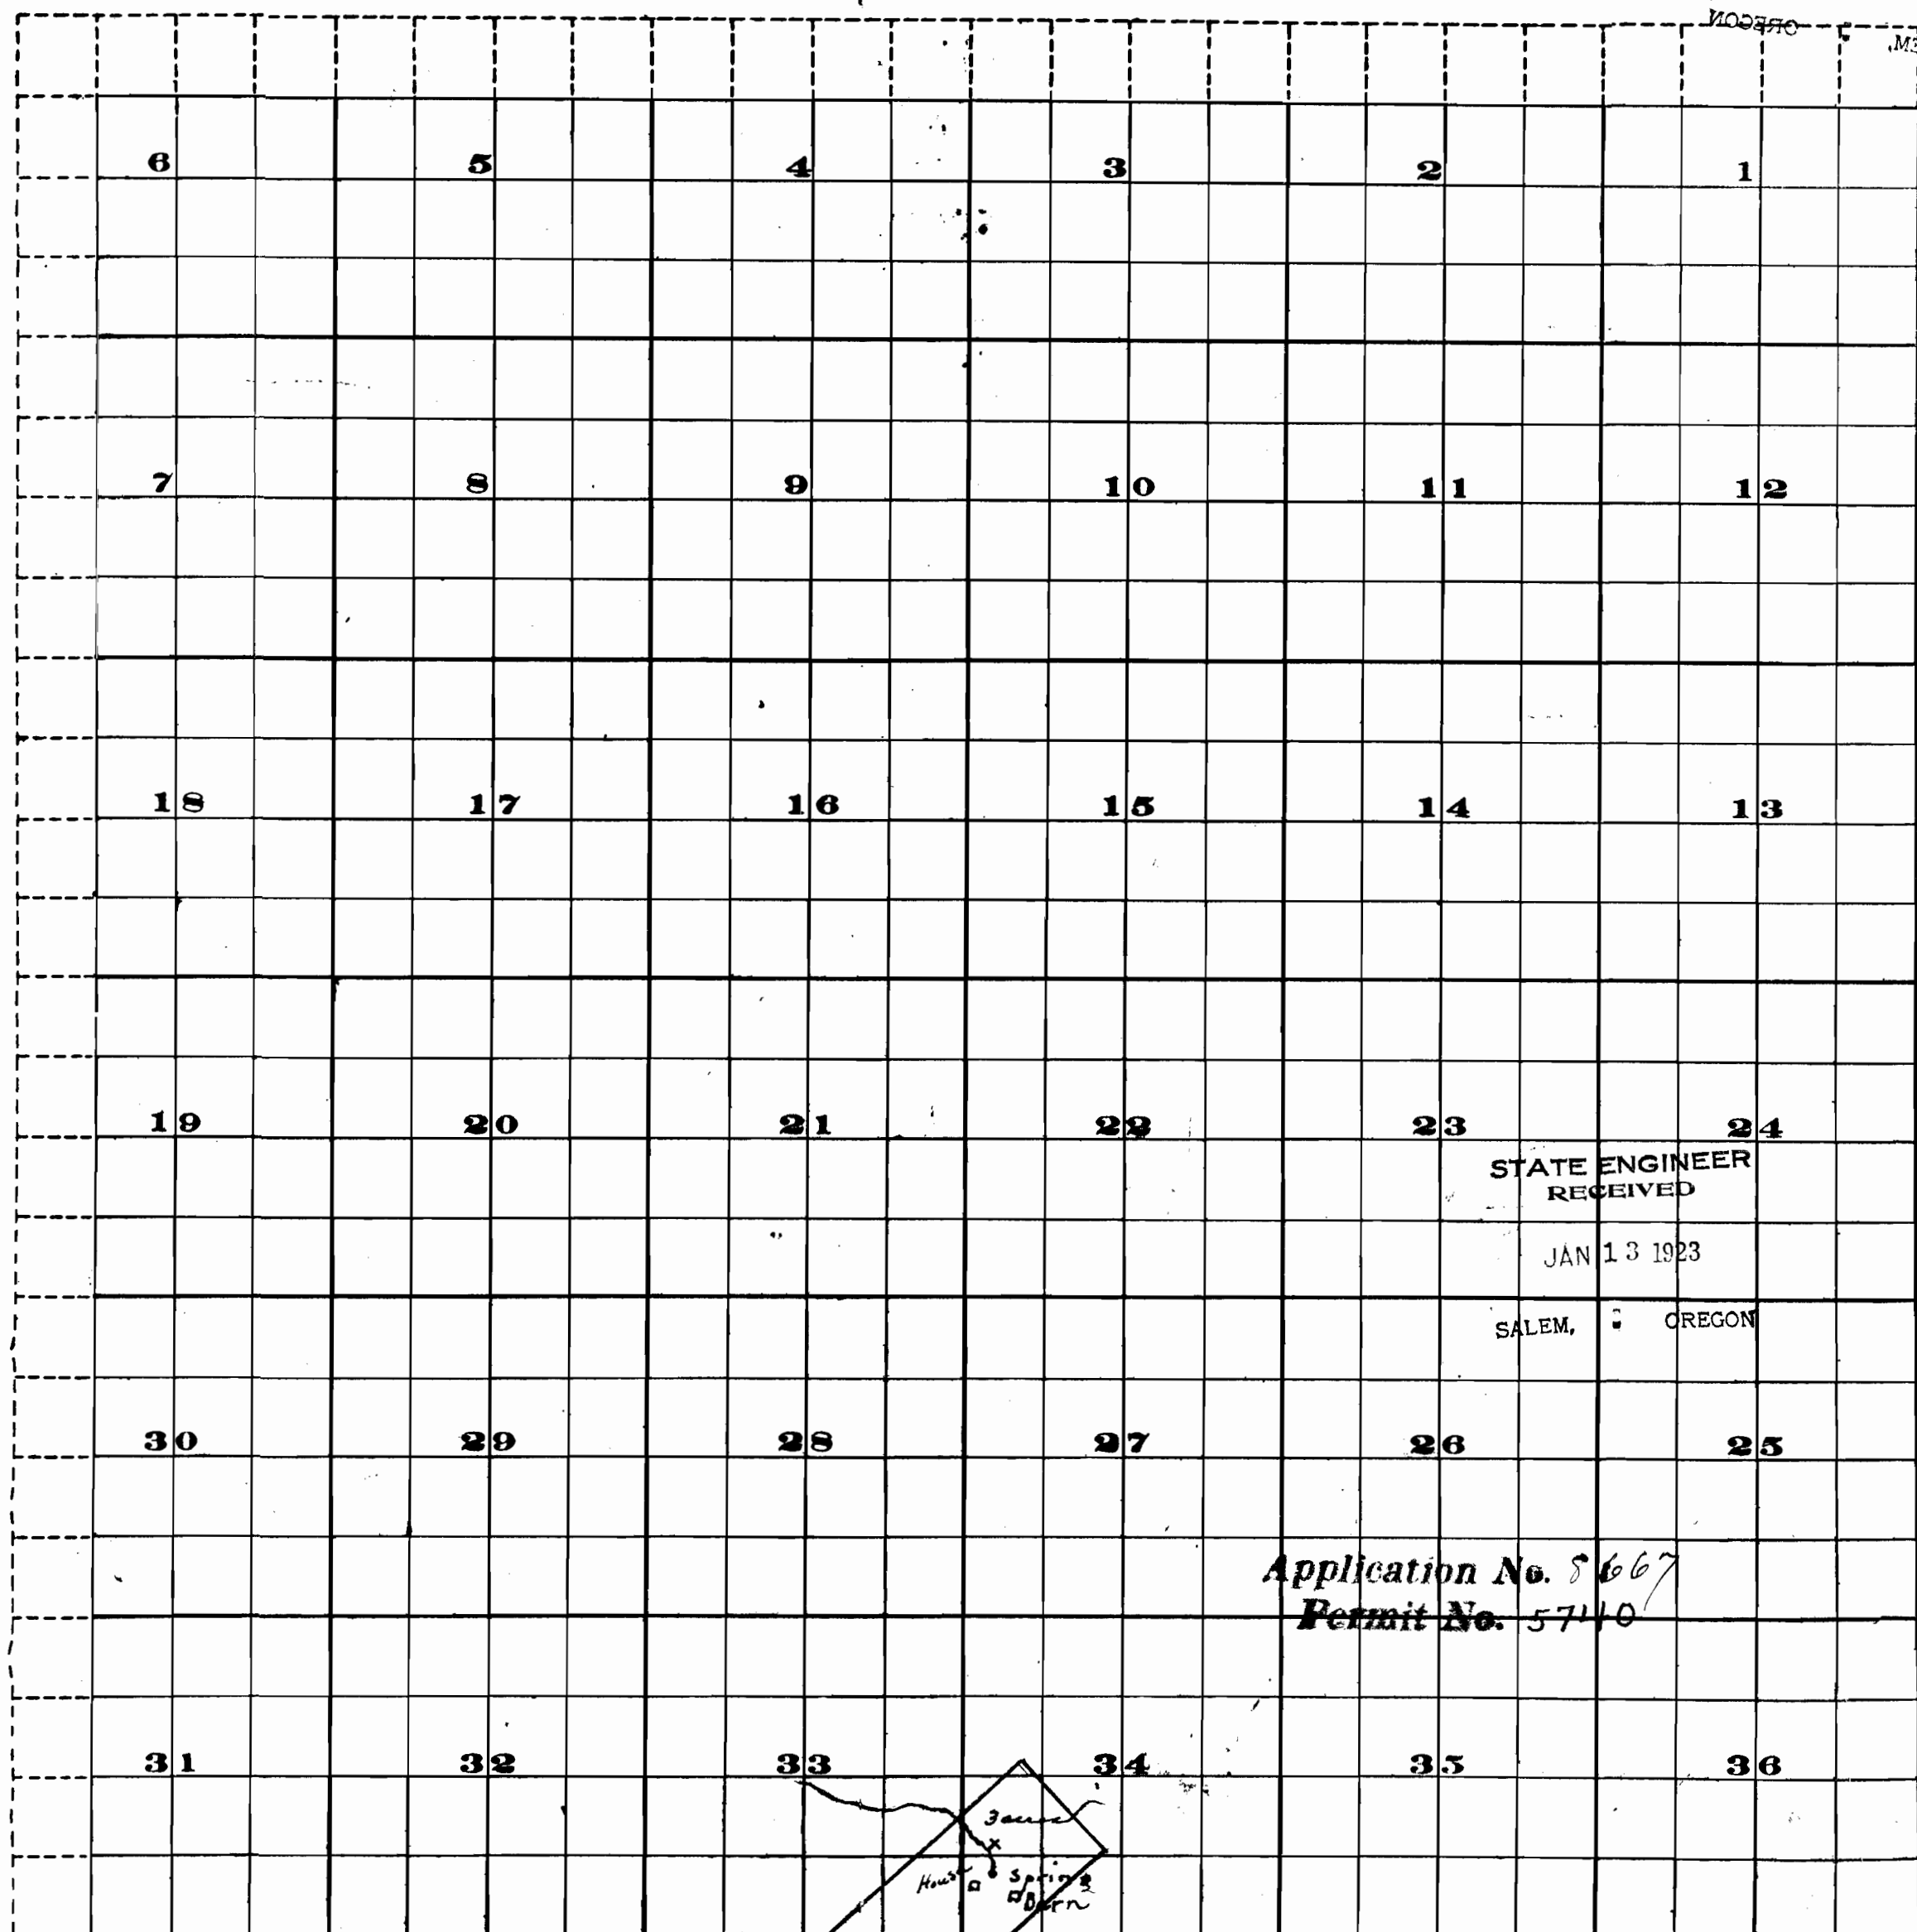

Scale of Feet.

FROM OFFICE OF THE STATE ENGINEER, SALEM, OREGON

STATE ENGINEER  
RECEIVED

JAN 13 1923

SALEM, OREGON

Application No. 8667  
Permit No. 5740

8907

8907