


Township 1 N, Range 10 W.

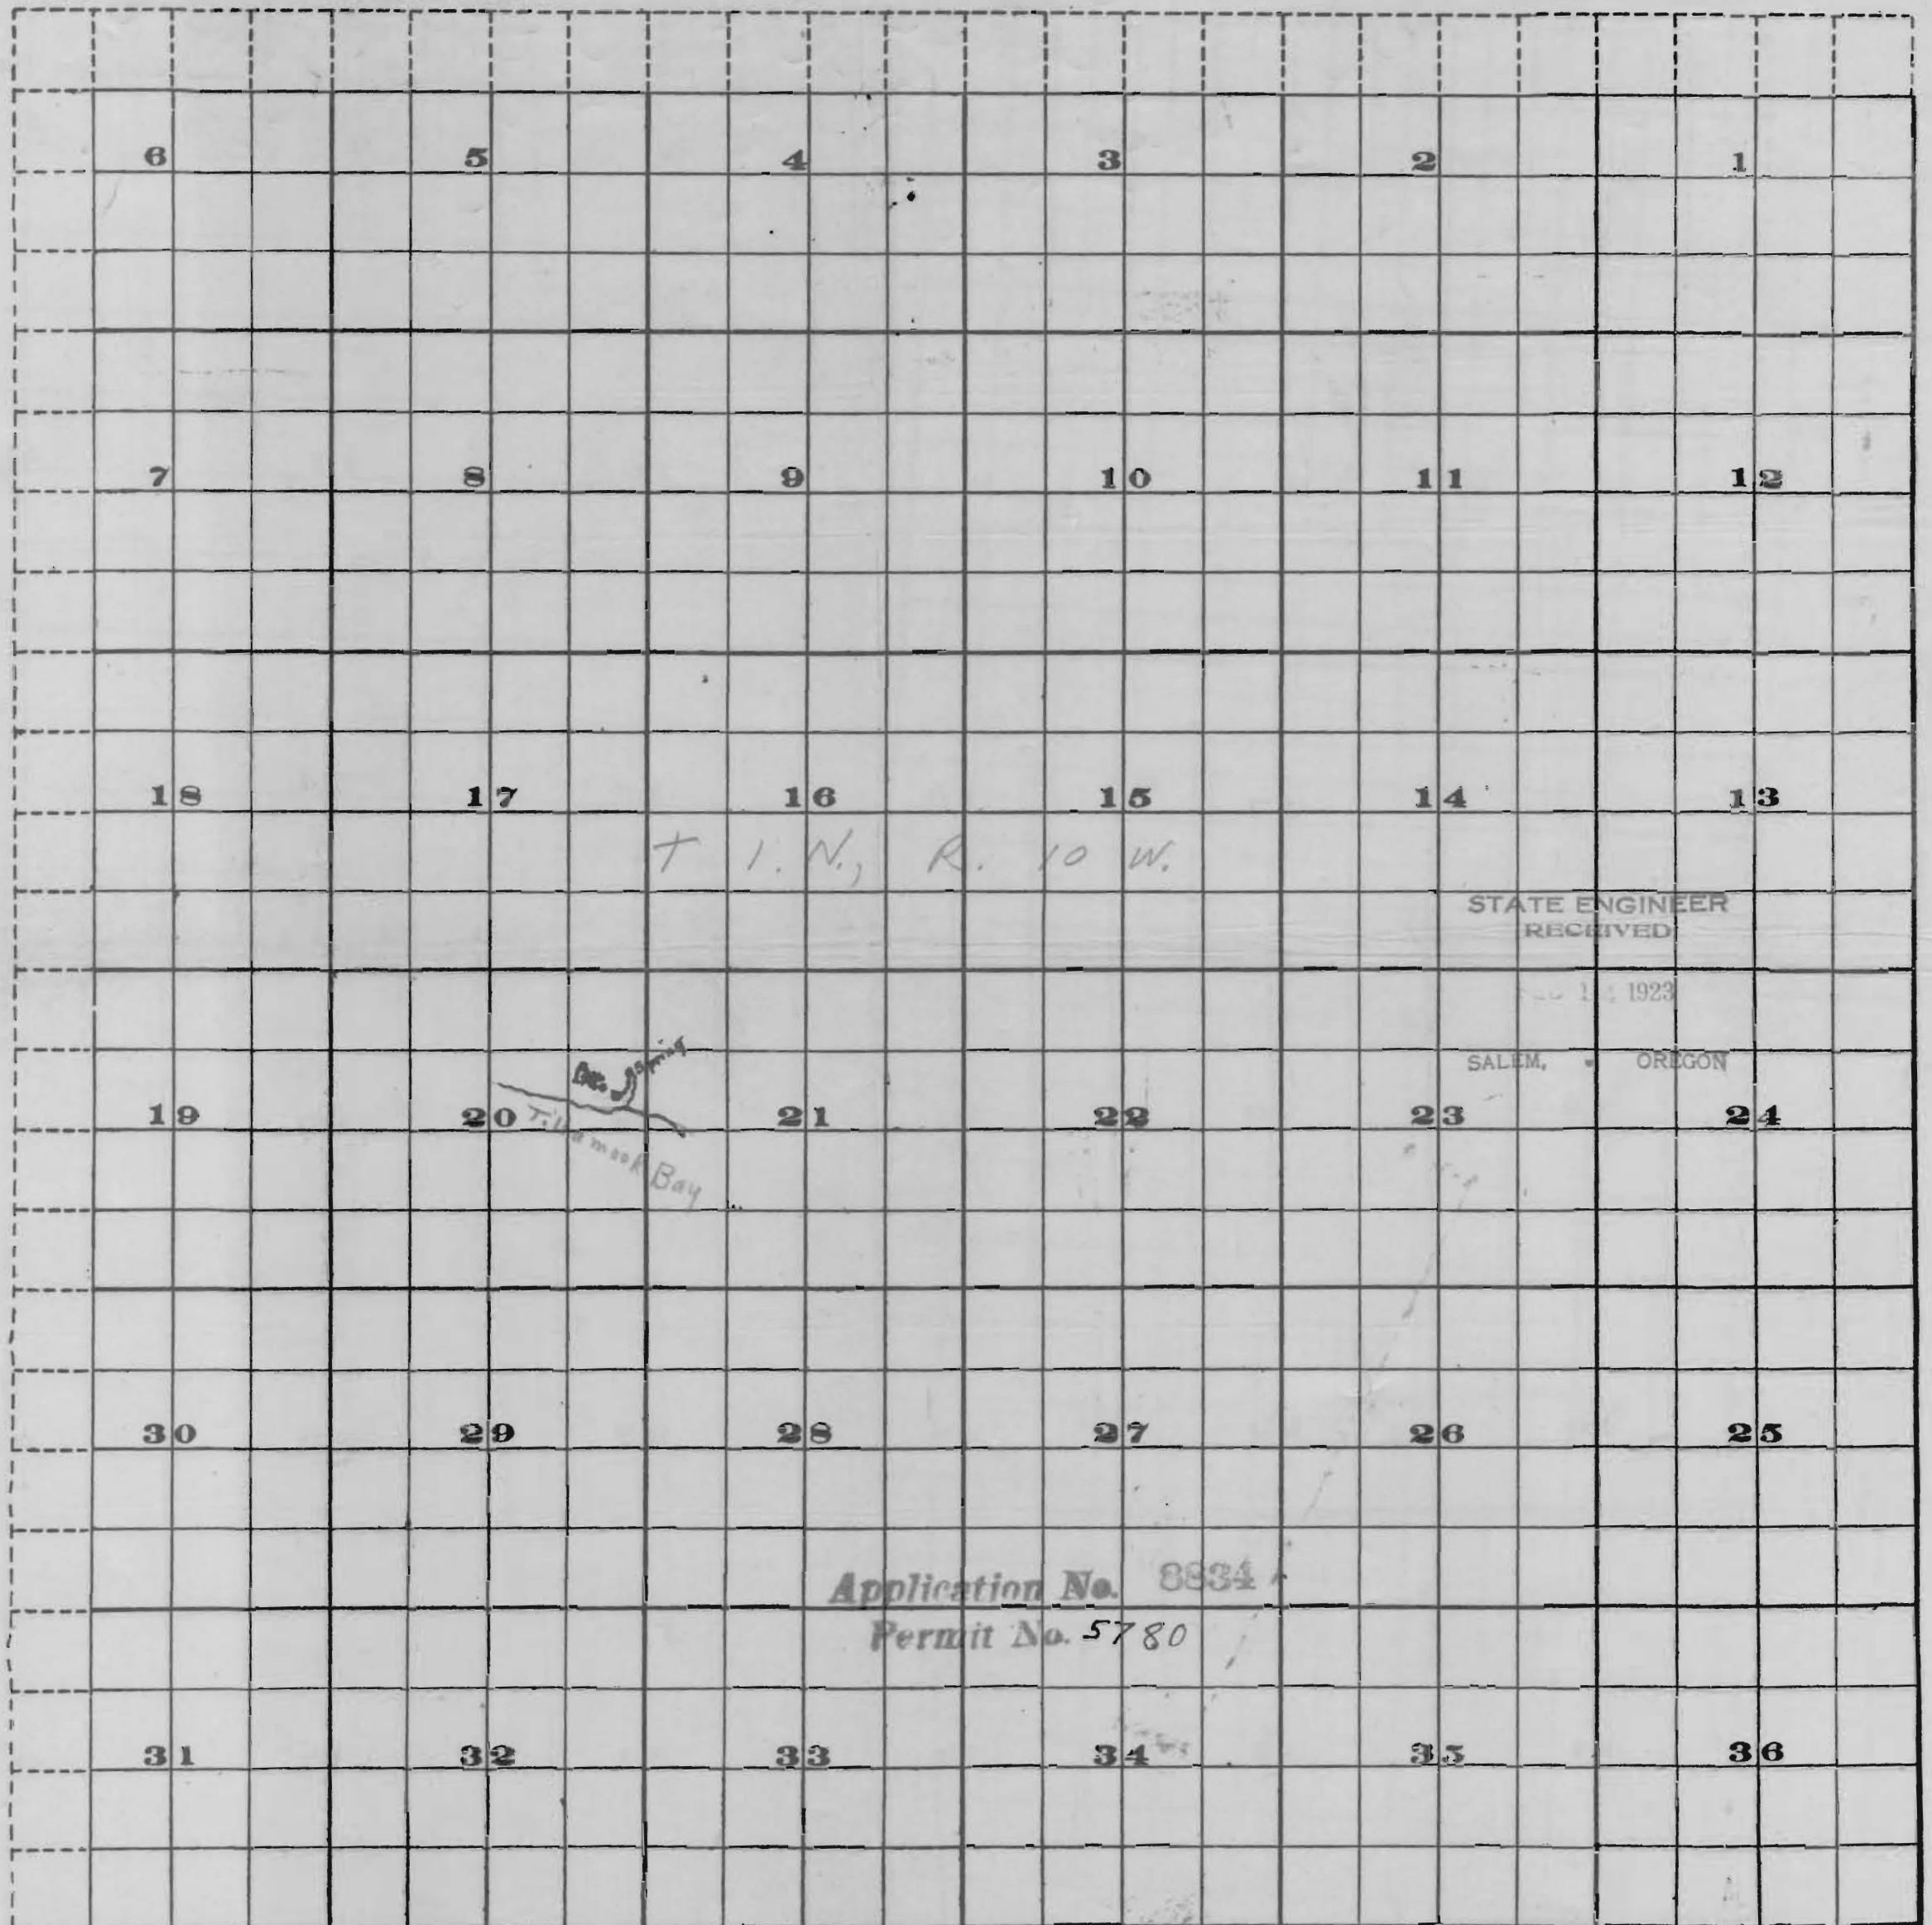

8834



