


SEC 11 TOWNSHIP 8S RANGE 11 W

Scale 1" = 1000 Ft

Andrew L. Porter

Reg No 455 Dec 31 1919

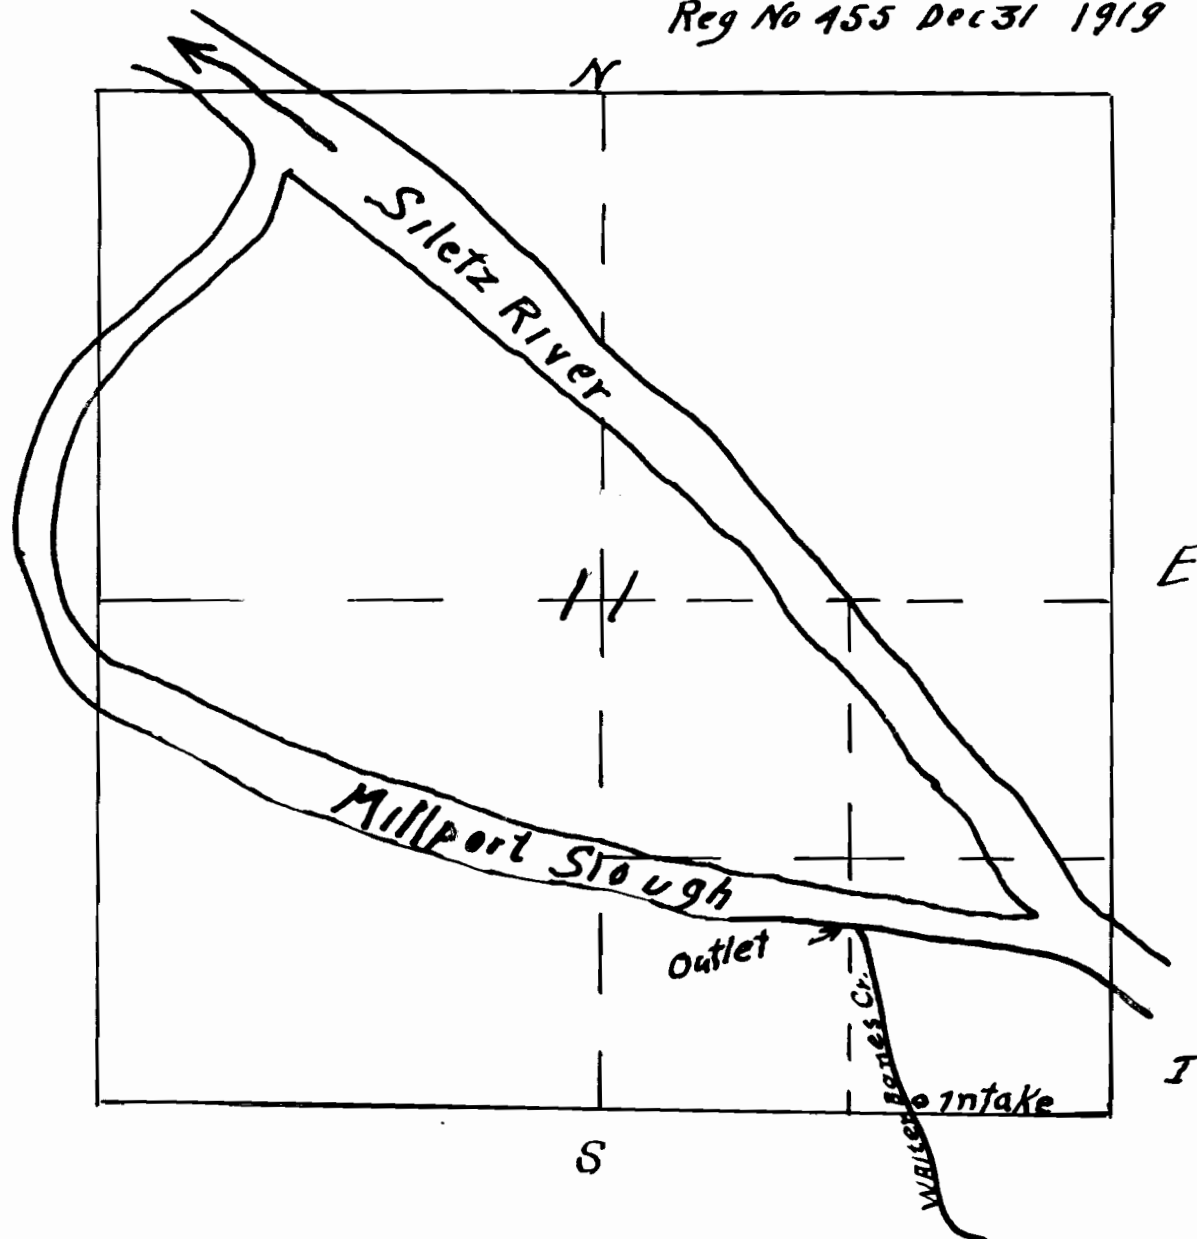

Appl. No. 8896
Permit No. 5828

Intake 1000' F W
100 FC N of SE Cor.
Sec 11 T8S R11W.