


Township 2 S,

Range 2 E.

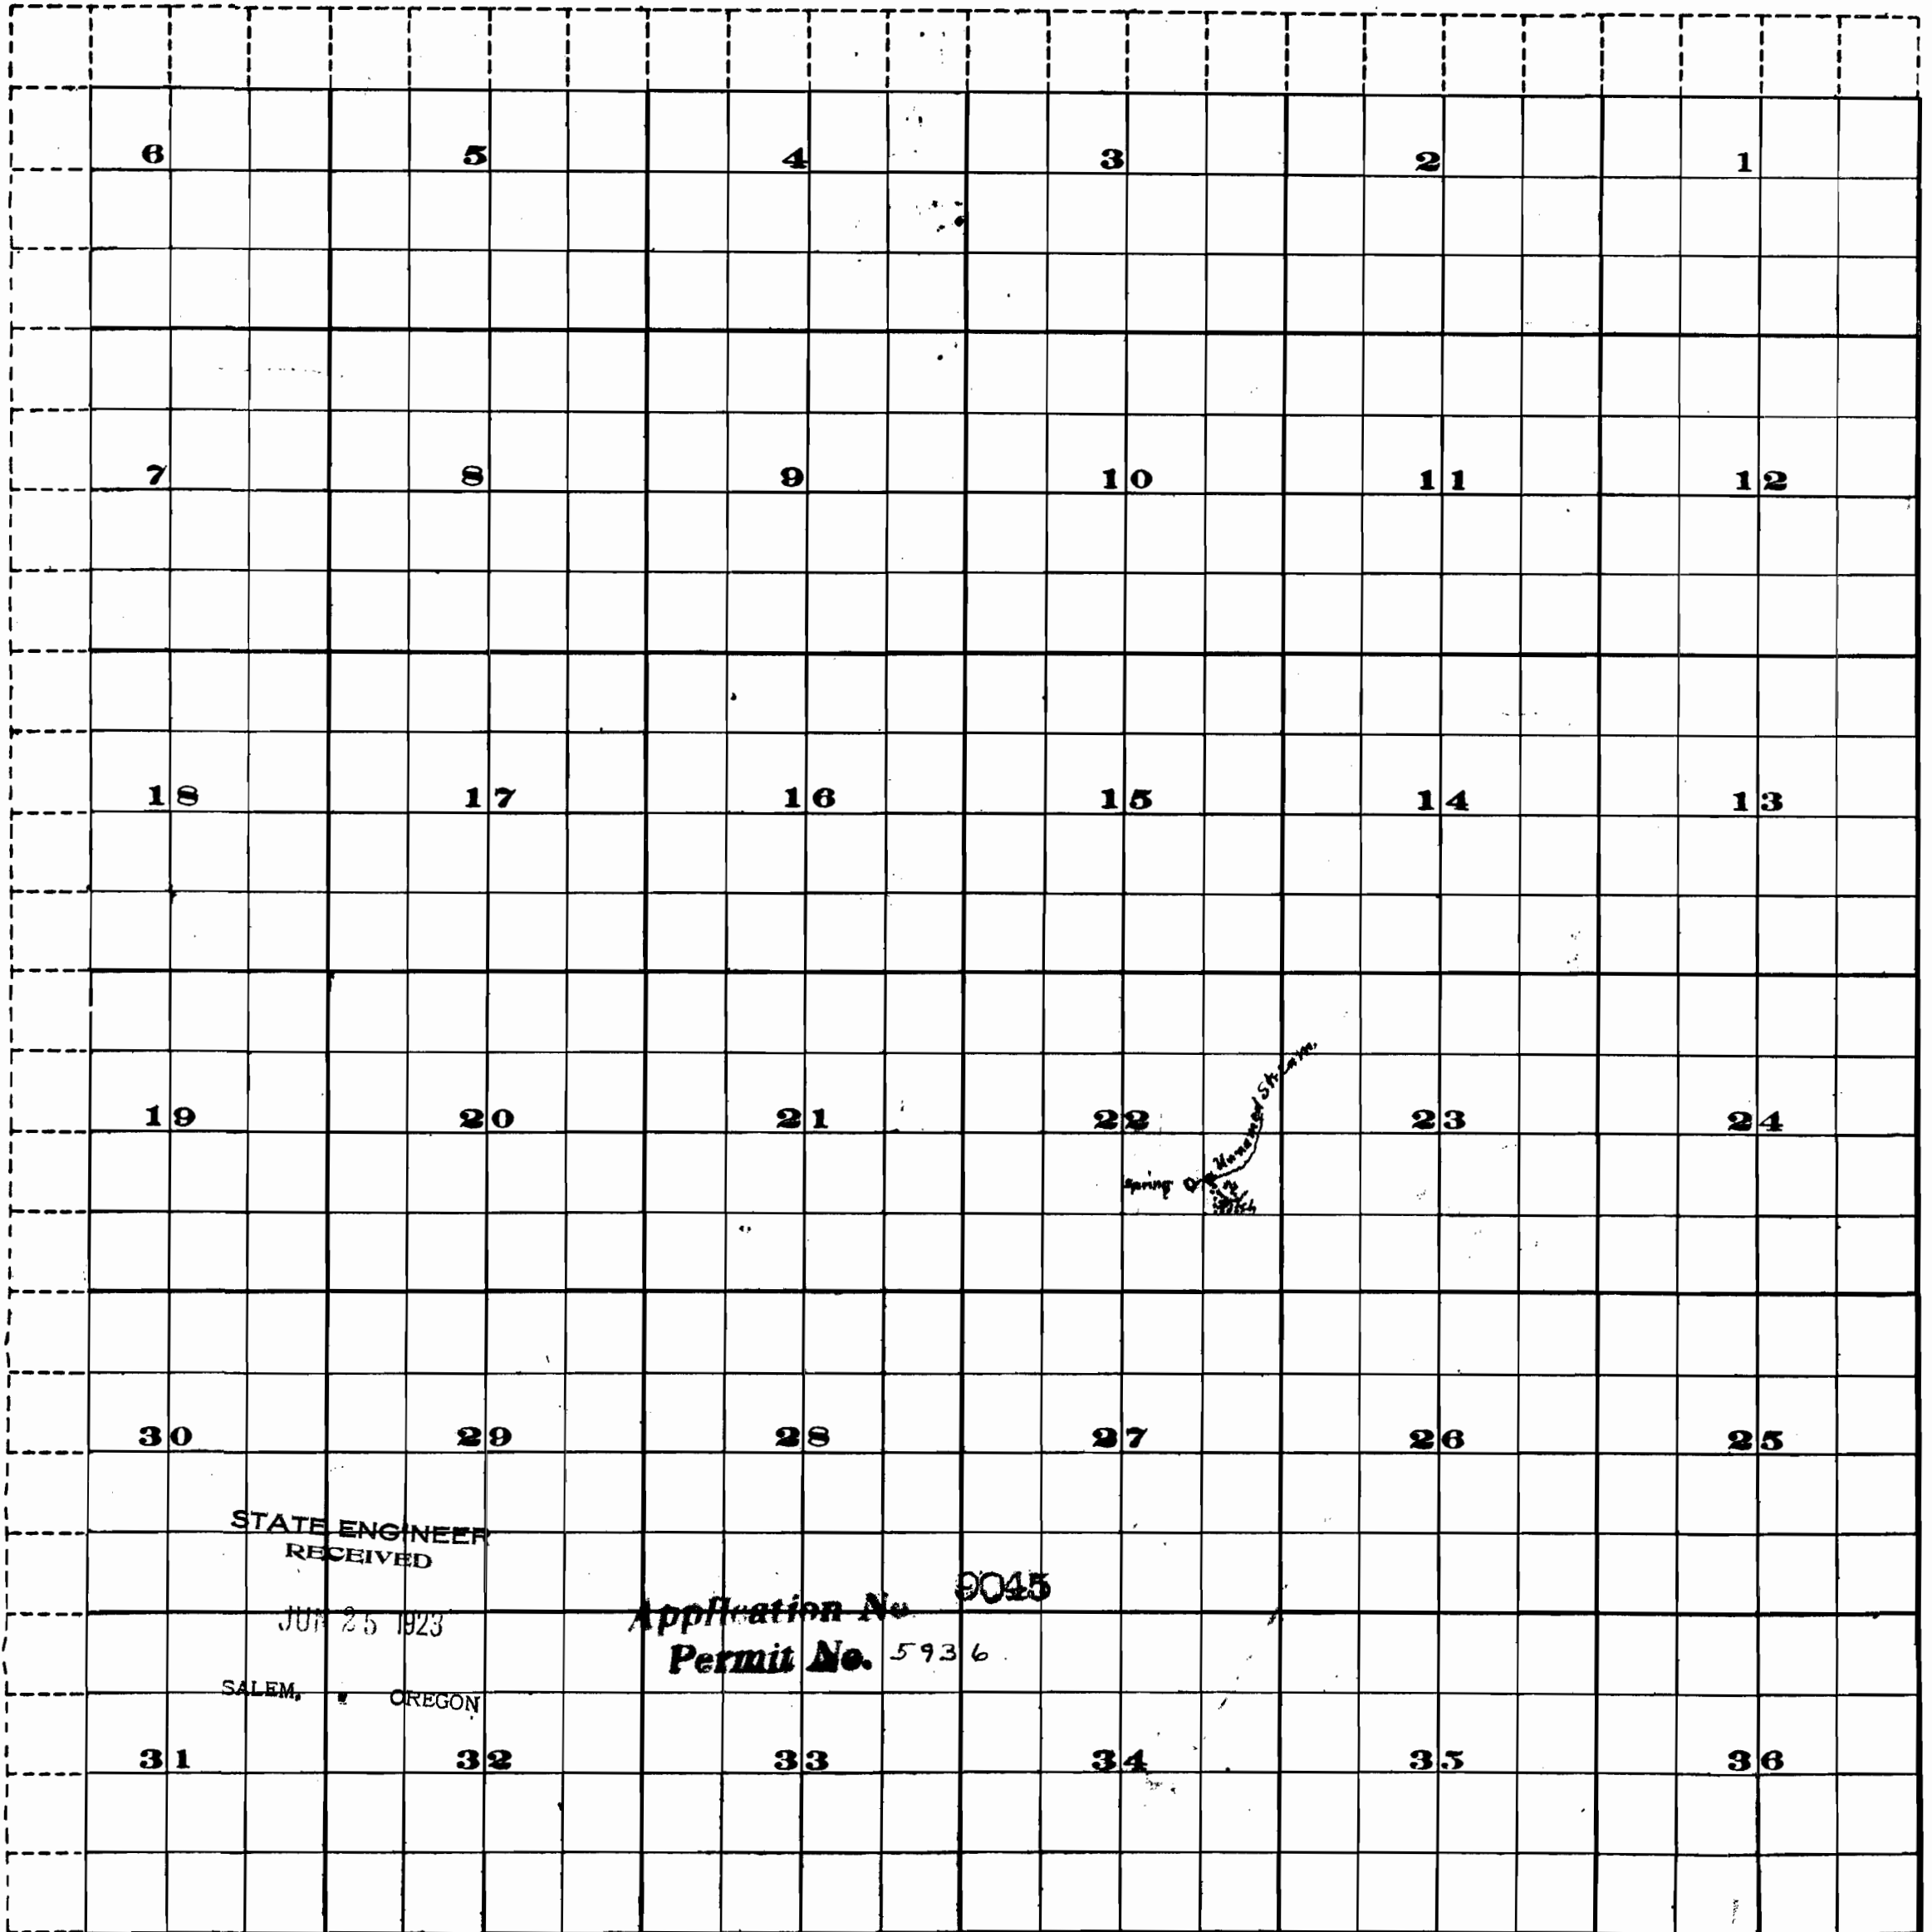


STATE ENGINEER
RECEIVED

JUL 25 1923

SALEM, OREGON

Application No. 9045
Permit No. 5936

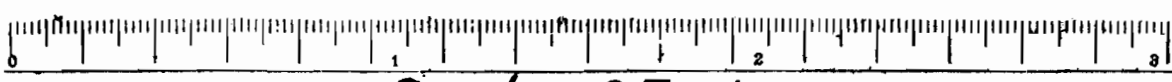

Scale of Feet.