



SURVEYORS CERTIFICATE

I H. S. Coates of Tillamook Oregon, do hereby certify that this map was made from notes taken during an actual survey made under my direct supervision Aug. 1923 and that it correctly represents the works herein described.

H. S. Coates
#967

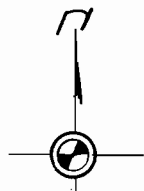

pipe Line.

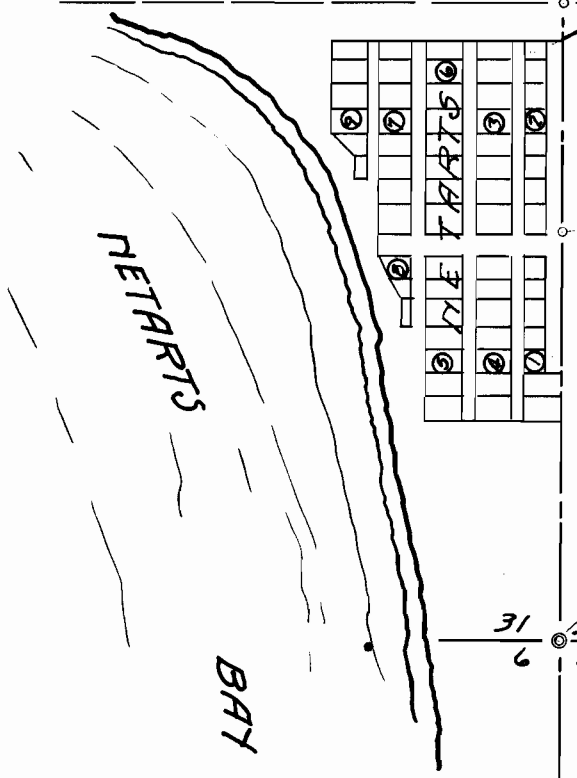

SURVEY OF WATER RIGHT.
FOR
Netarts Corporation
SEC'S 31 & 32 T. 15. R. 10. N.
Scale 1" = 400' Aug 1923

Application No. 9141
Permit No. 6047