


RECEIVED STATE ENGINEER
SEP 28 1923

Township 12 S,

Range 4 W.

203

SEP 28 1923
SALEM, OREGON

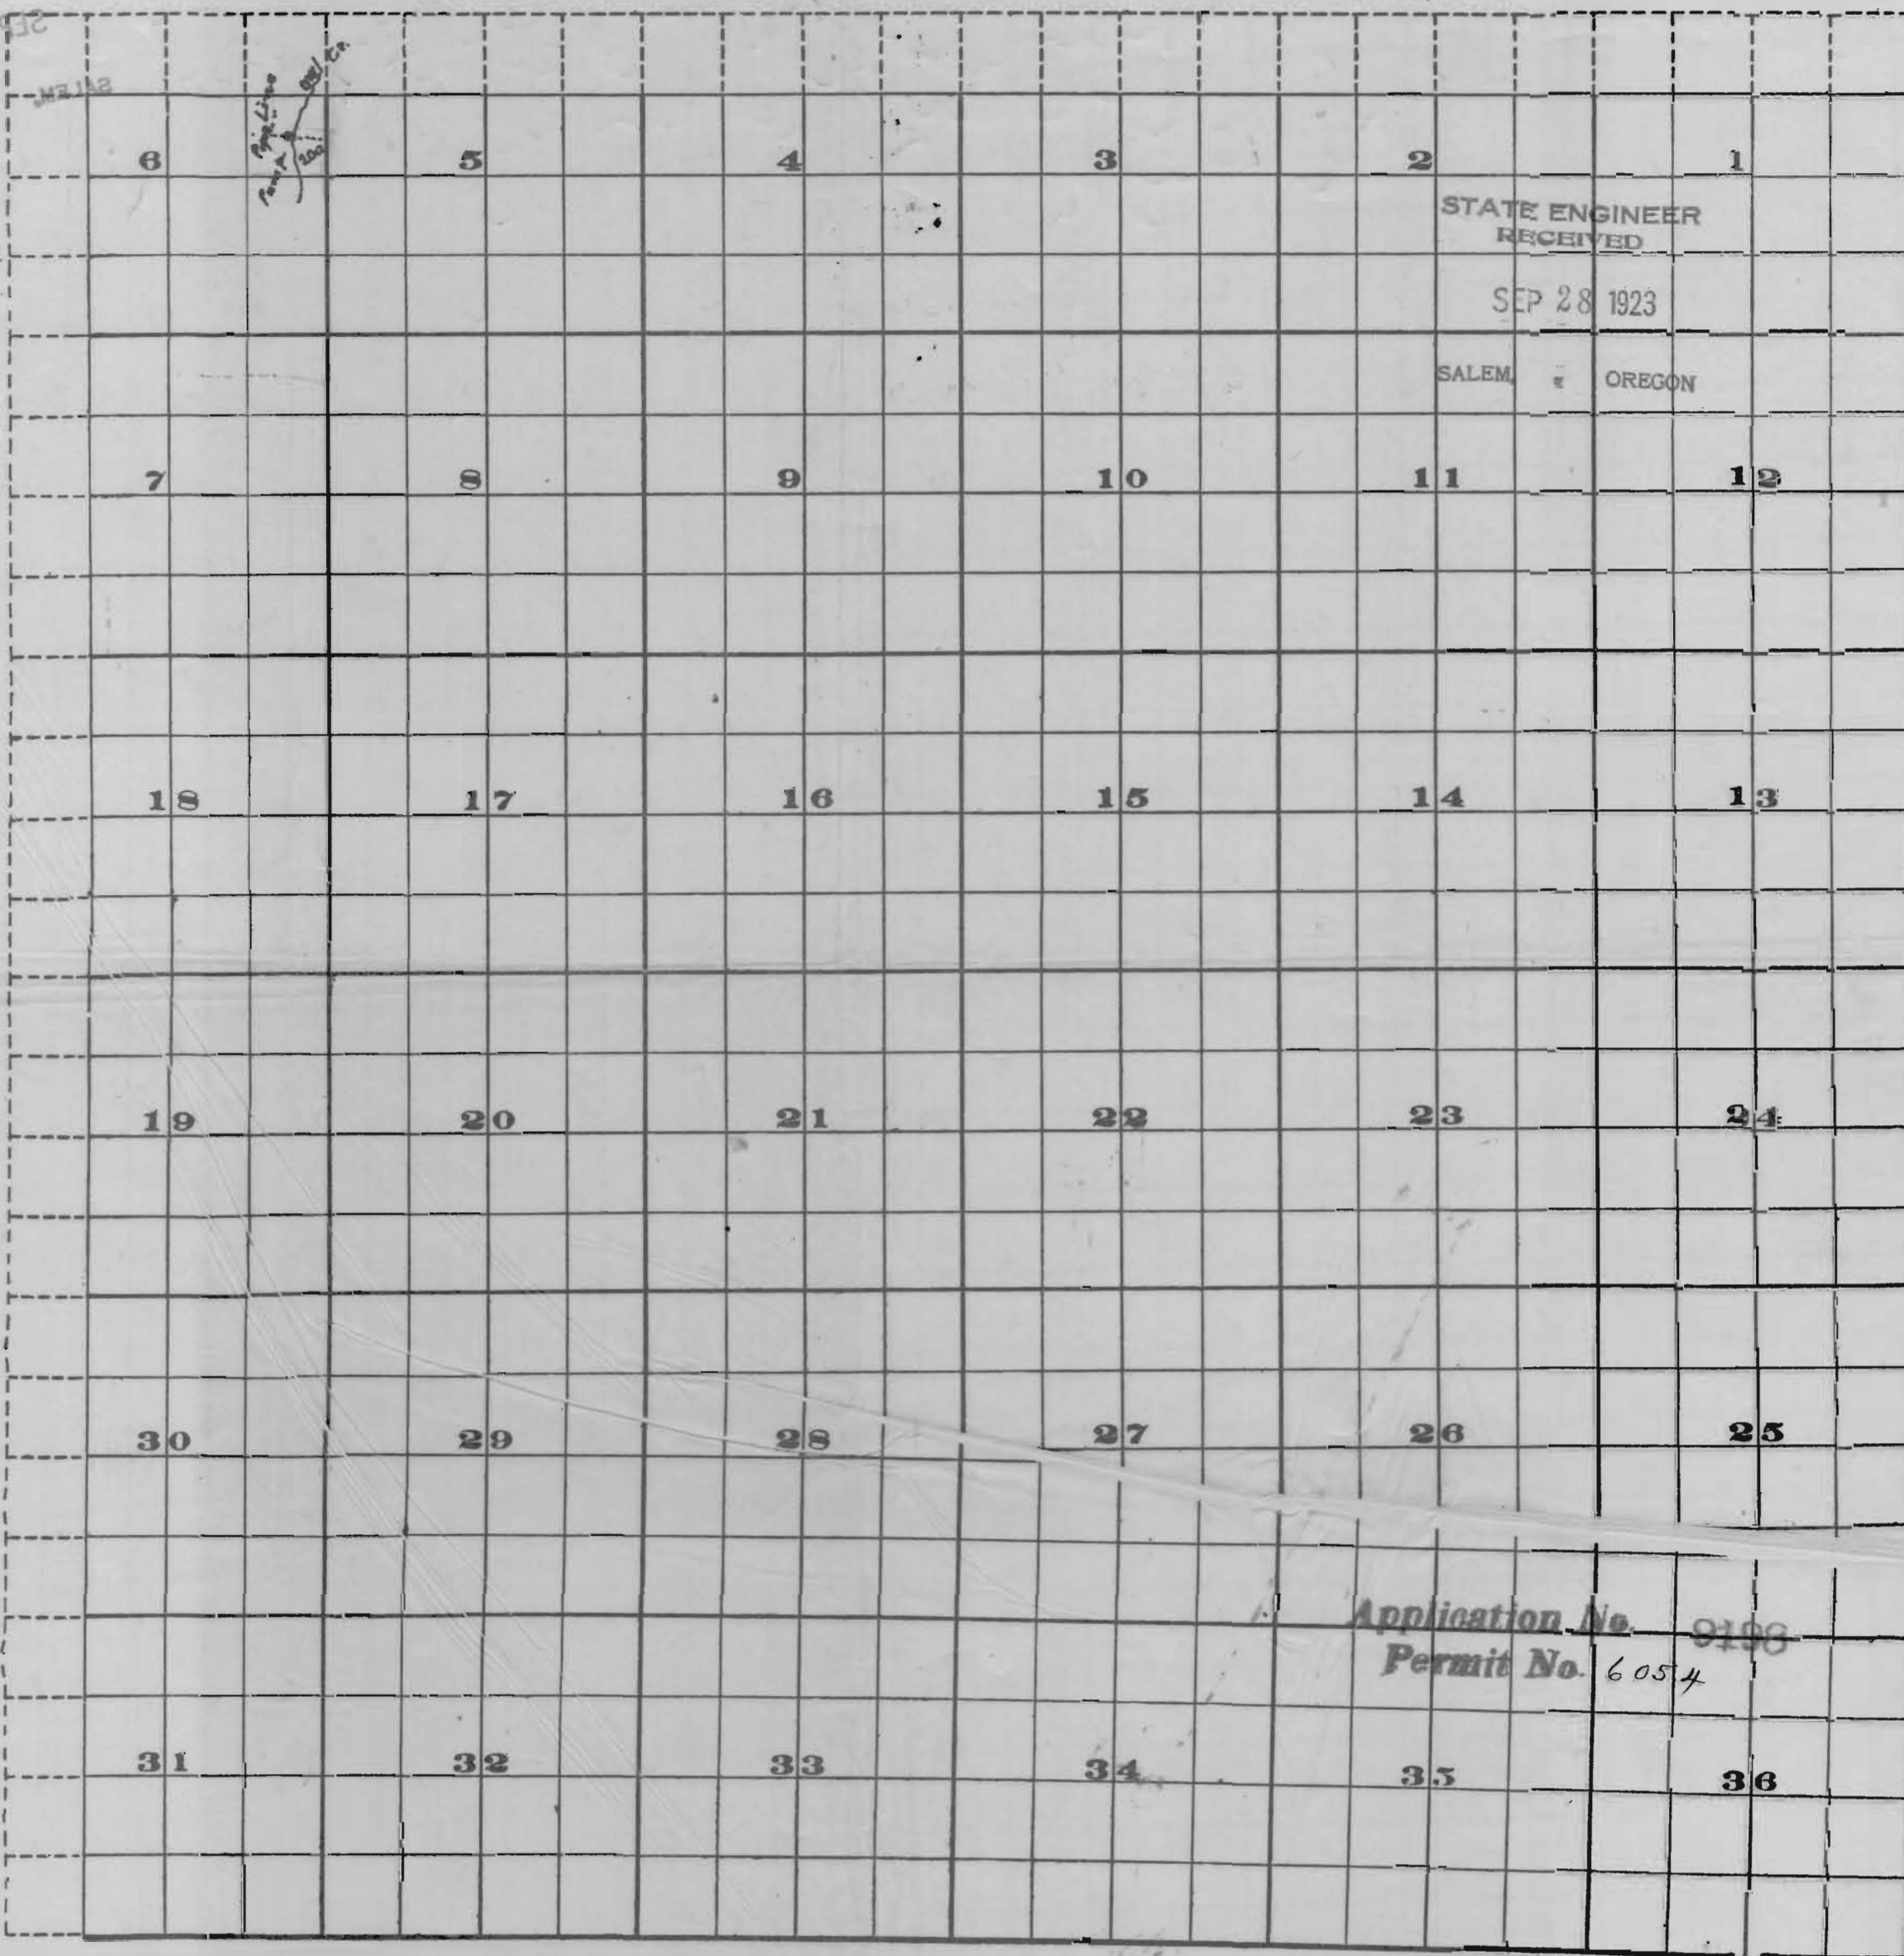

201A

201B