

Sec. 15

North

Sec 14

SE SE

SW SW

Sec. 14

15

22


23

Tp. 1 N

R. 4 W

Scale:

One inch = 20 rods

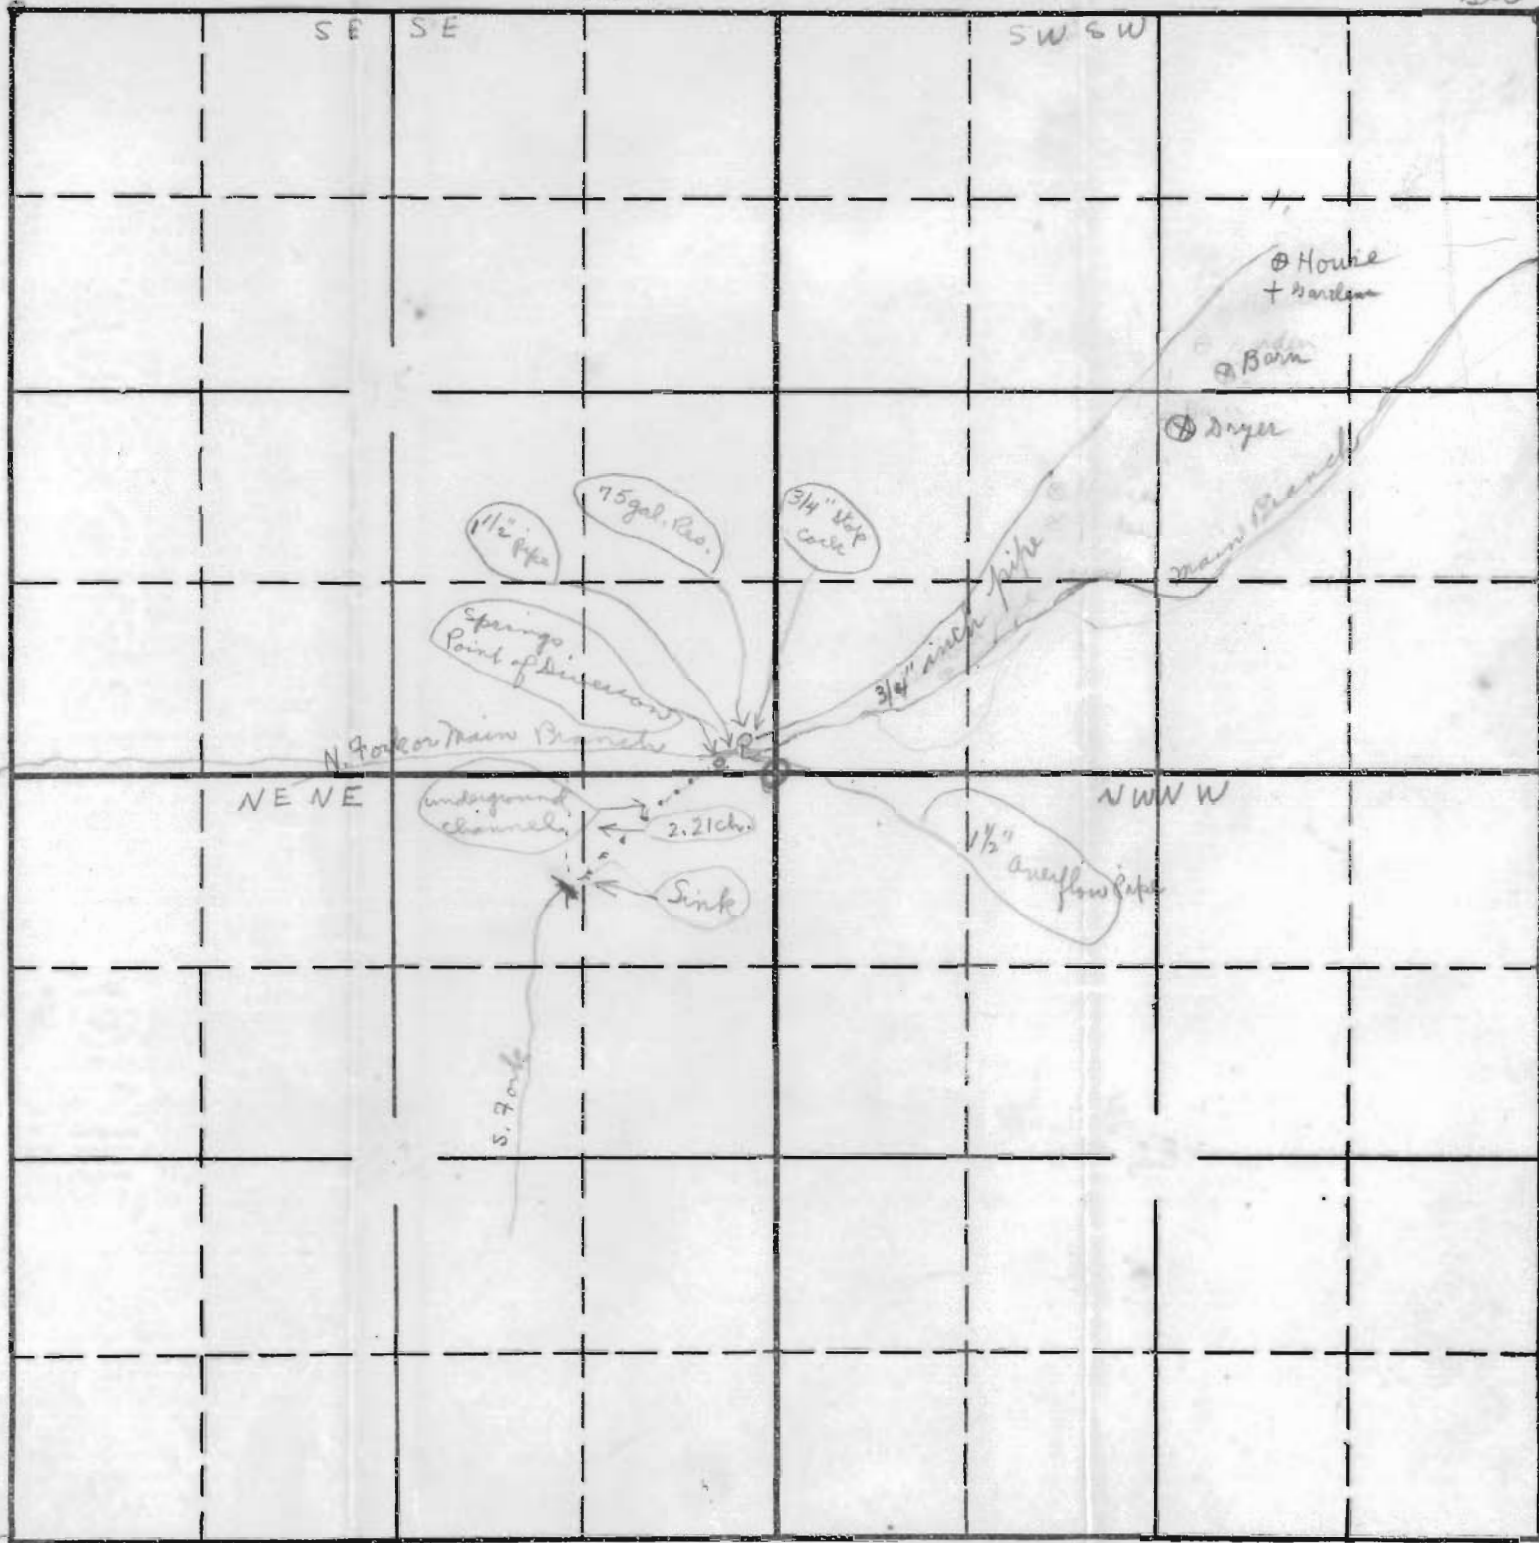

West

NE NE

NW W

East

Sec 22

South

Application 9288

Sec 23