


*John H. Polander's  
Map*

Application No. 1303  
~~Reservoir~~ Permit No. 627

Township No. 39 S Range No. 36 E. W.M.

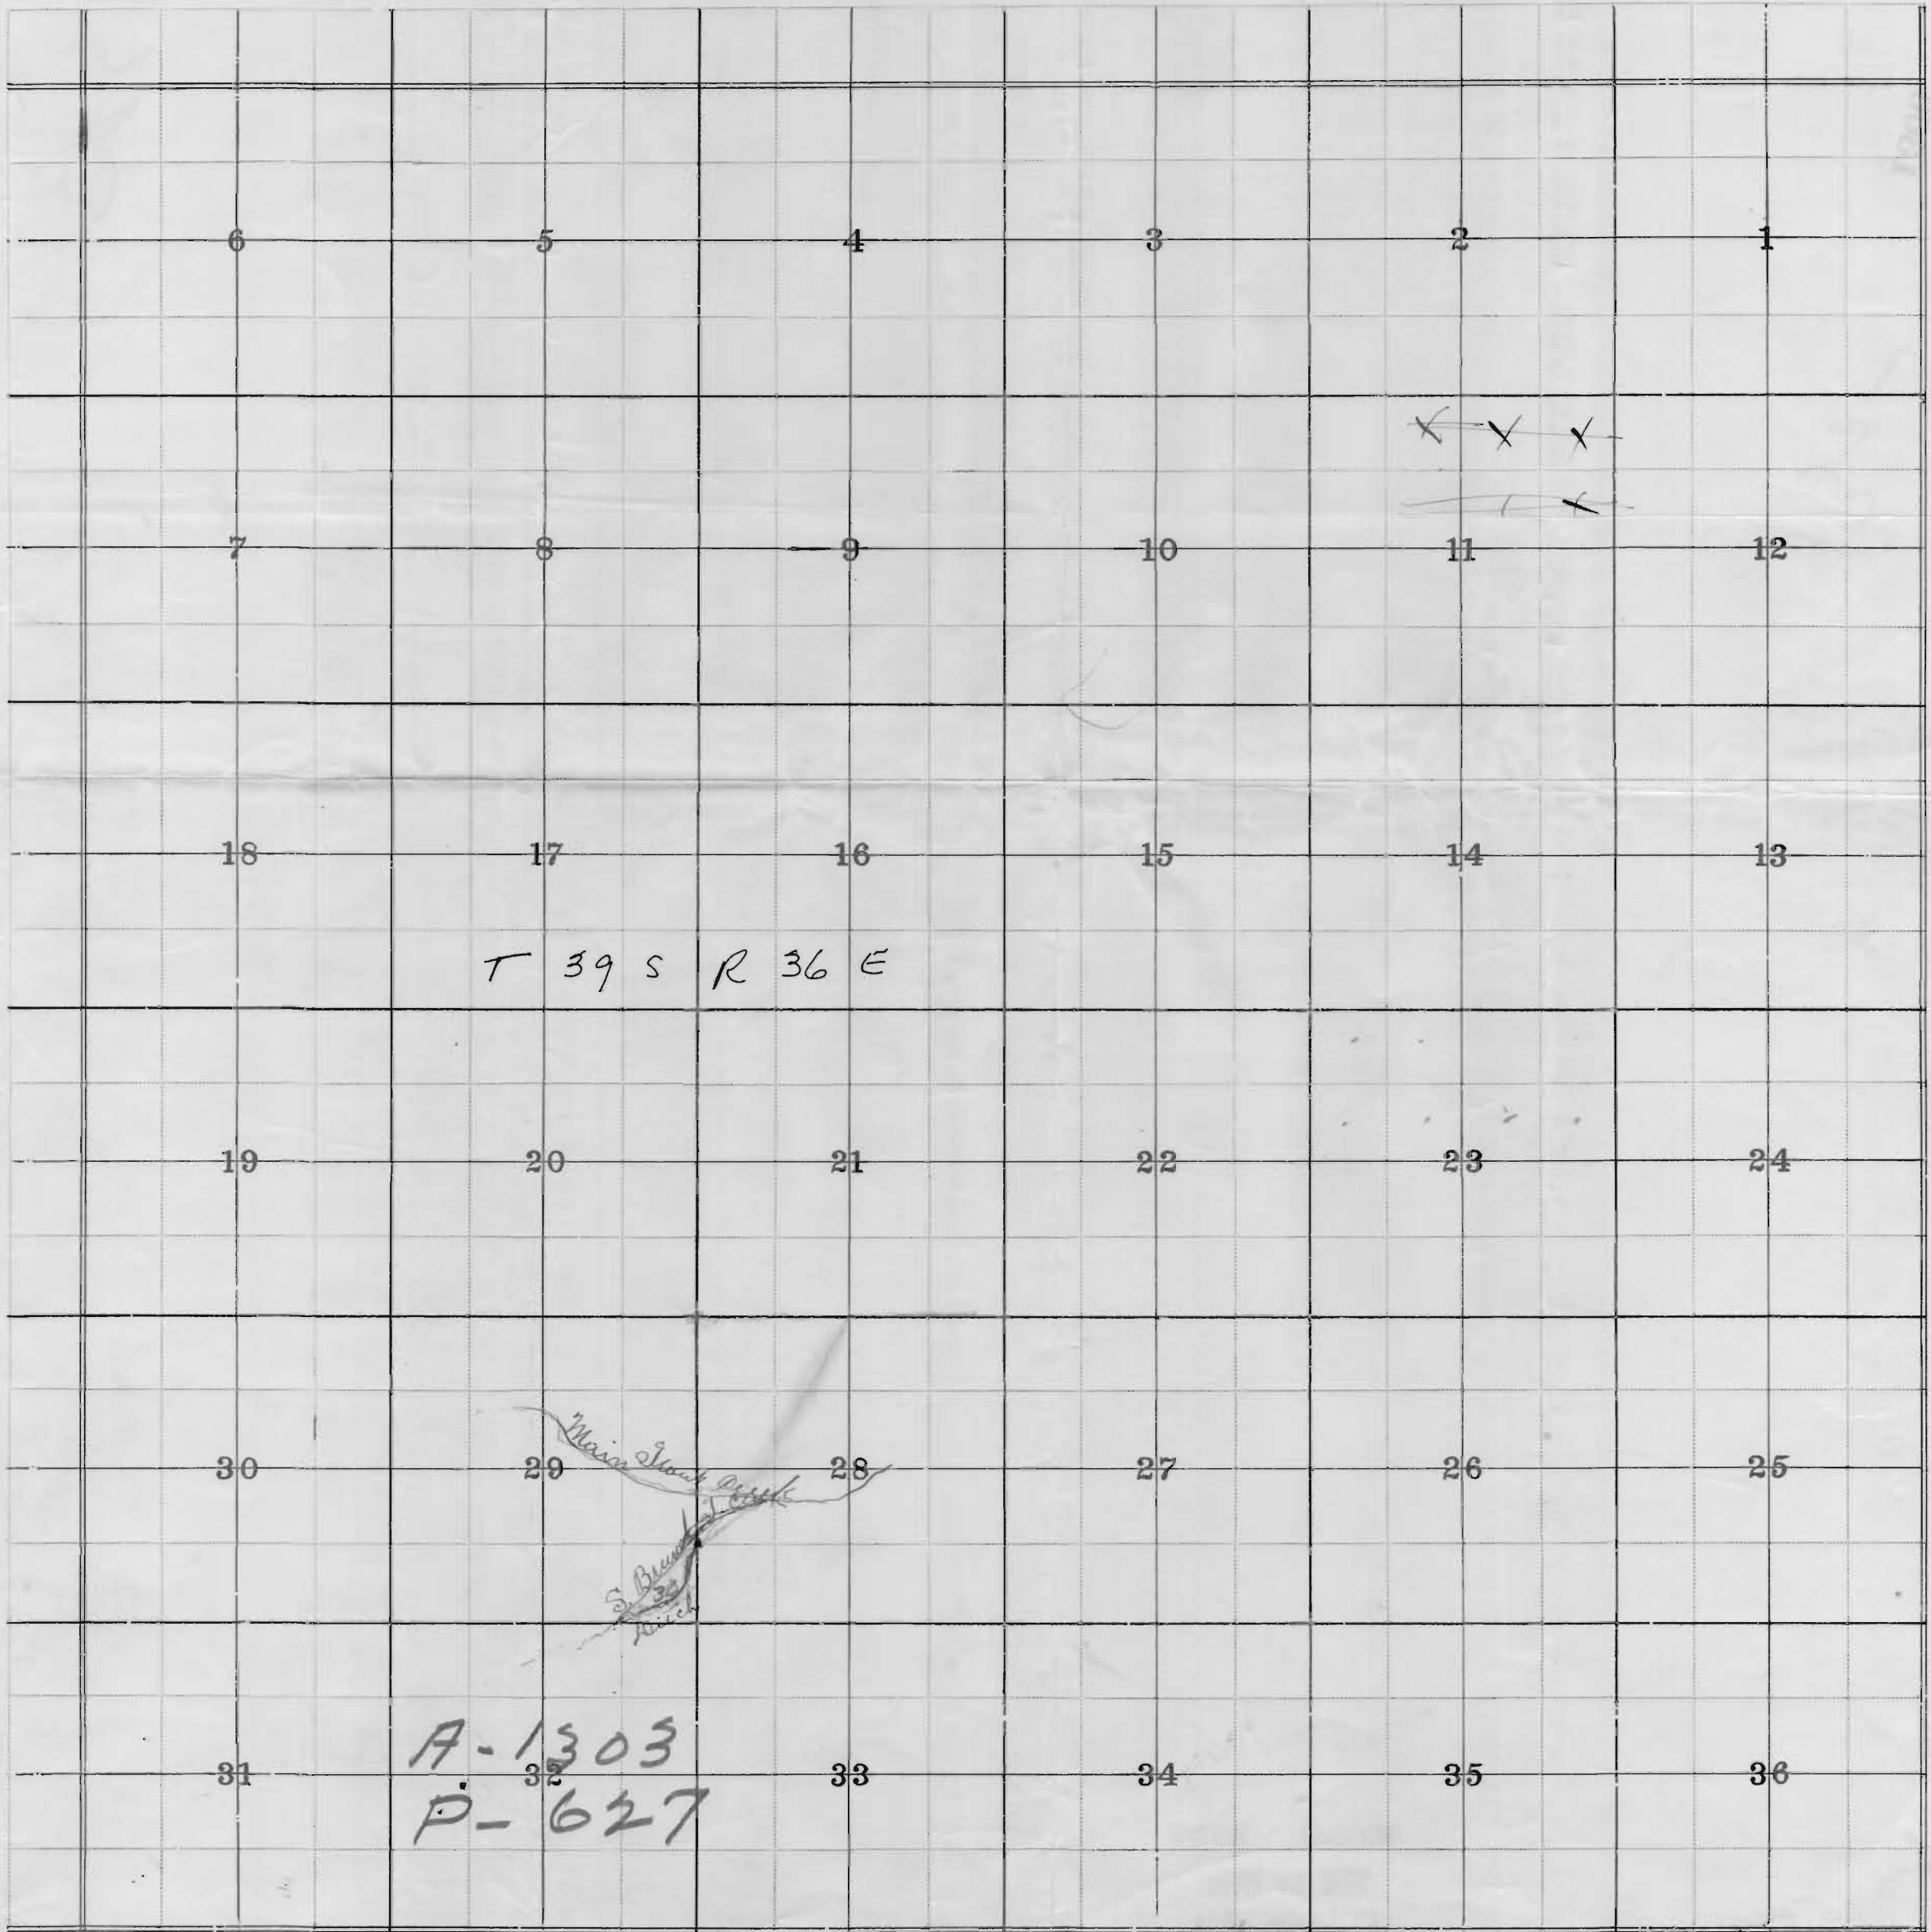

39 S, -36 E

*Polander's map*