
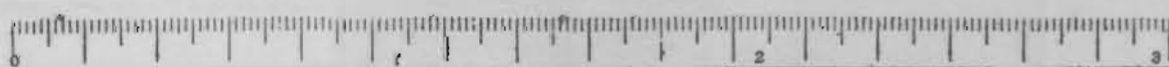


Township 20 S.,

Range 3 W.

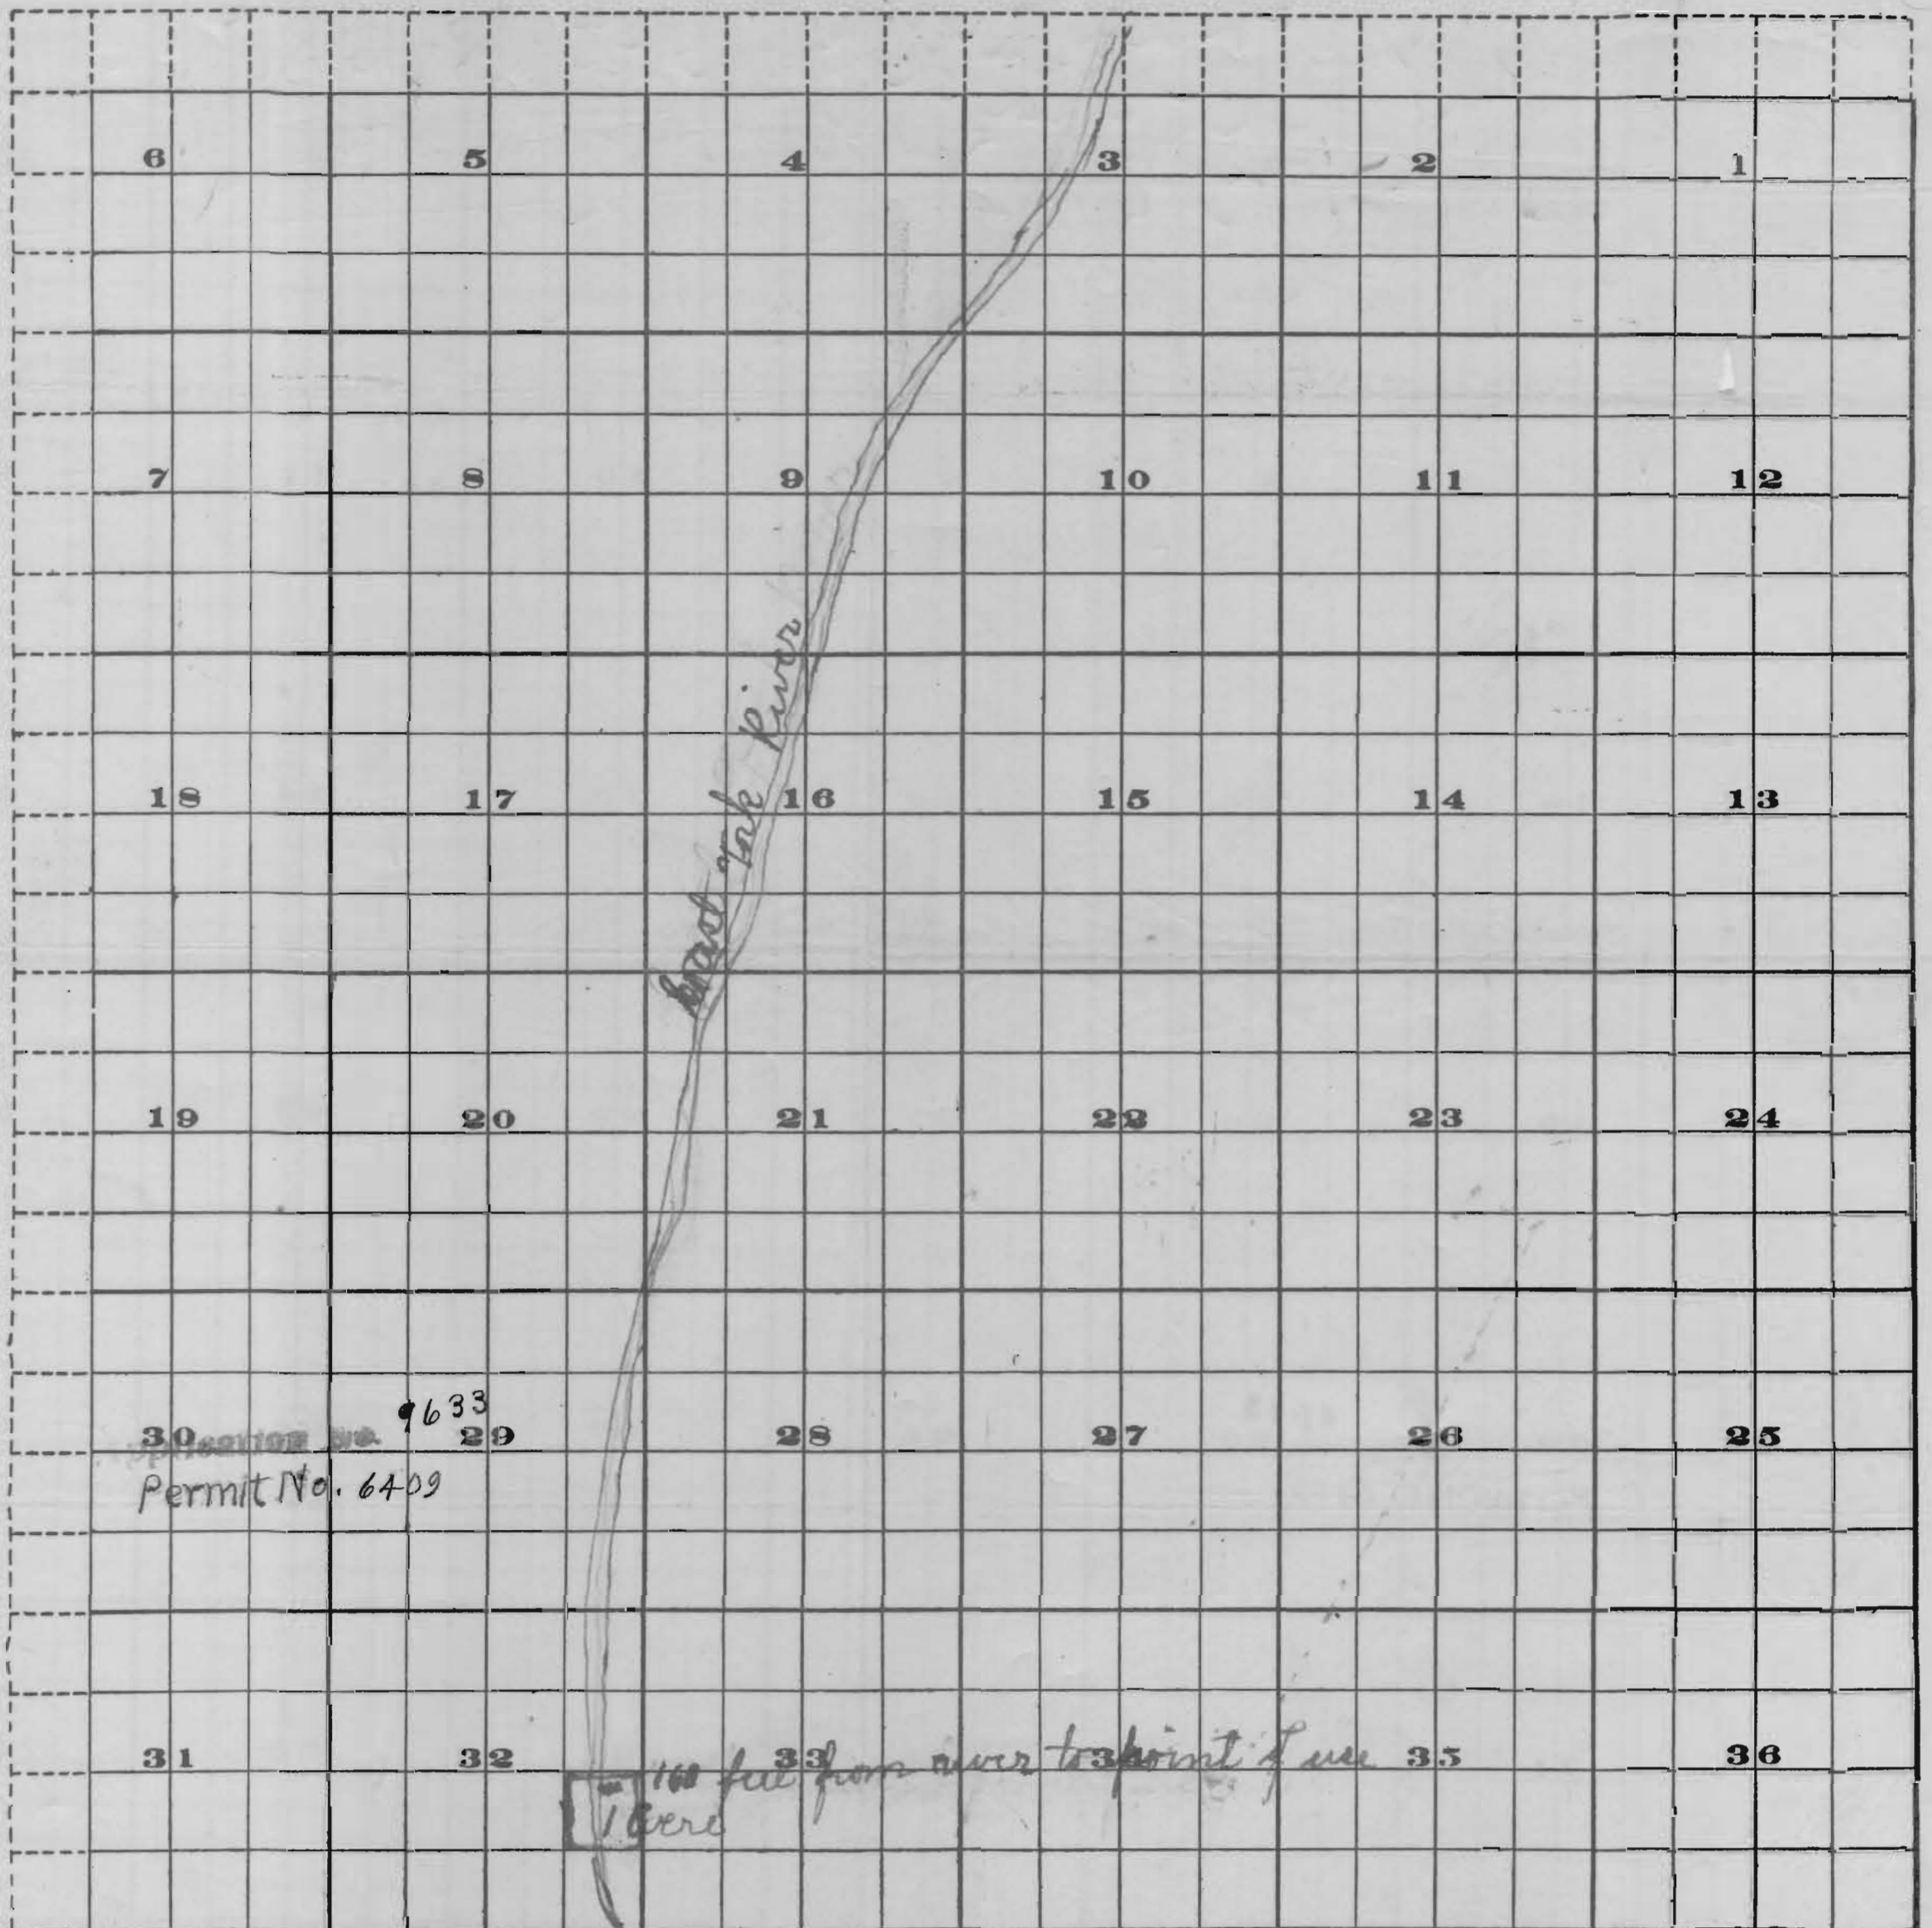

Scale of Feet.