


Township 21 South,

Range Range 3 East

18710

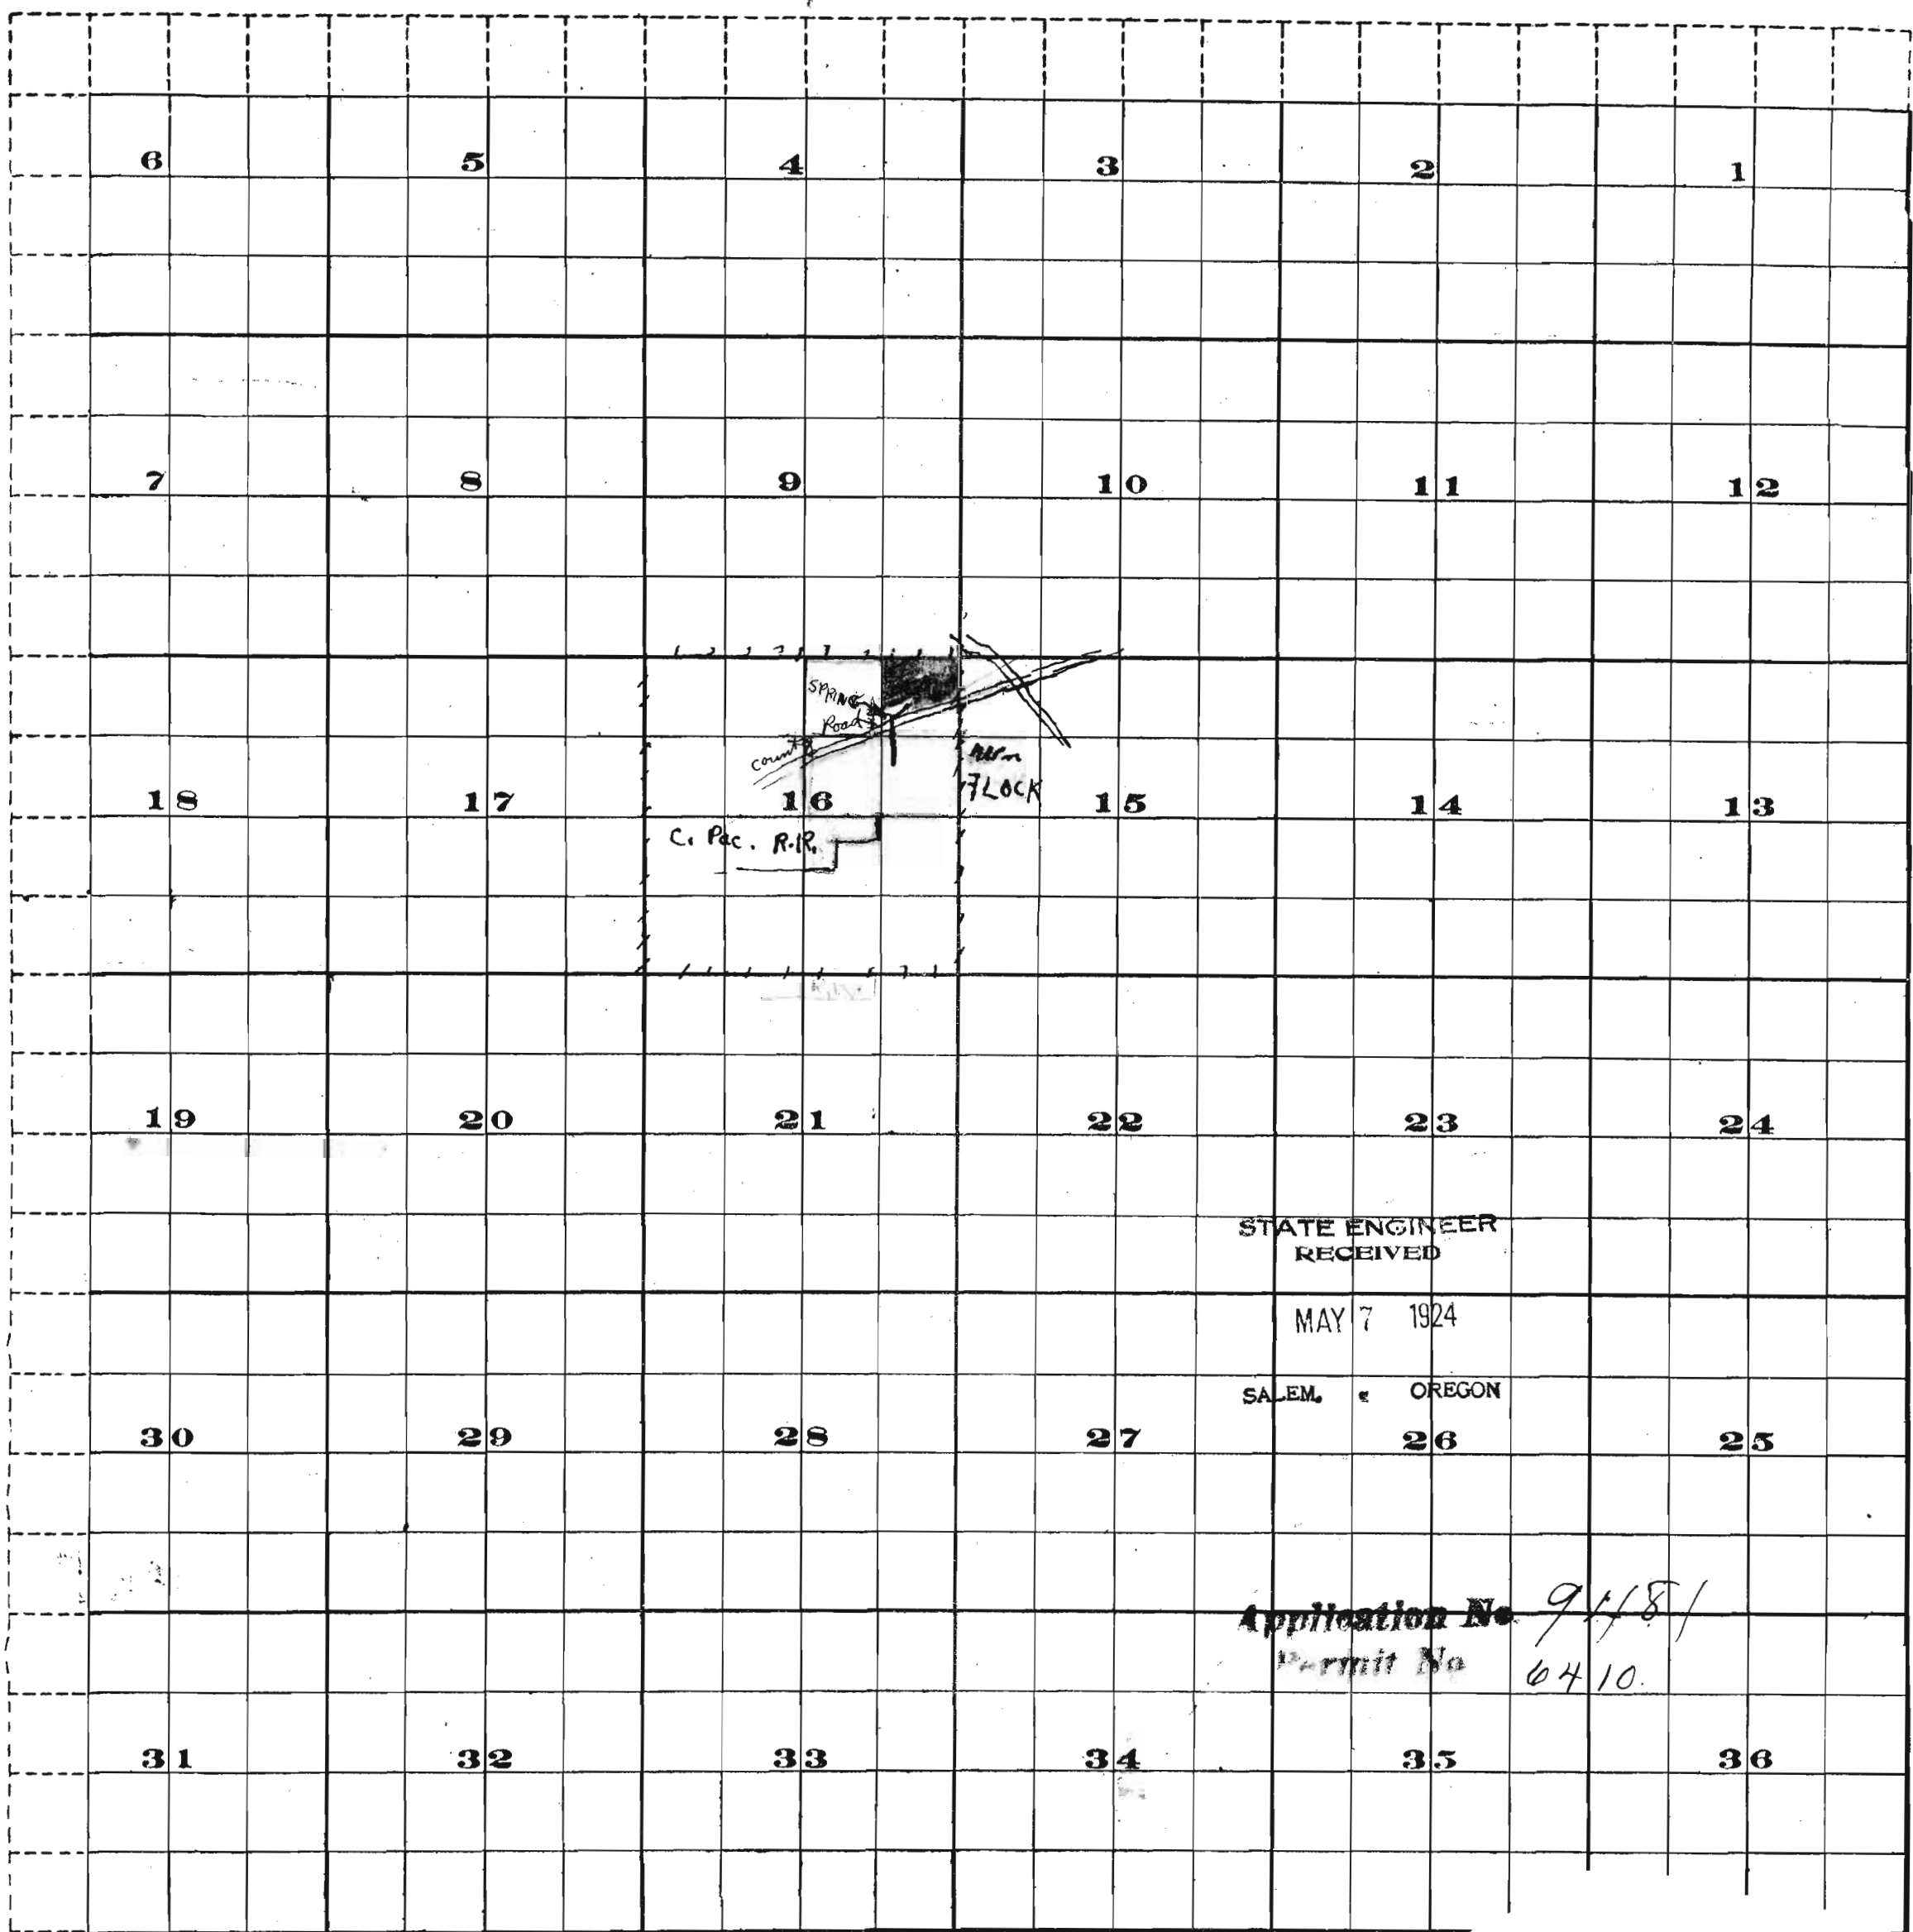

9481



Scale of Feet.

FRONT