


Township _____,

Range _____.

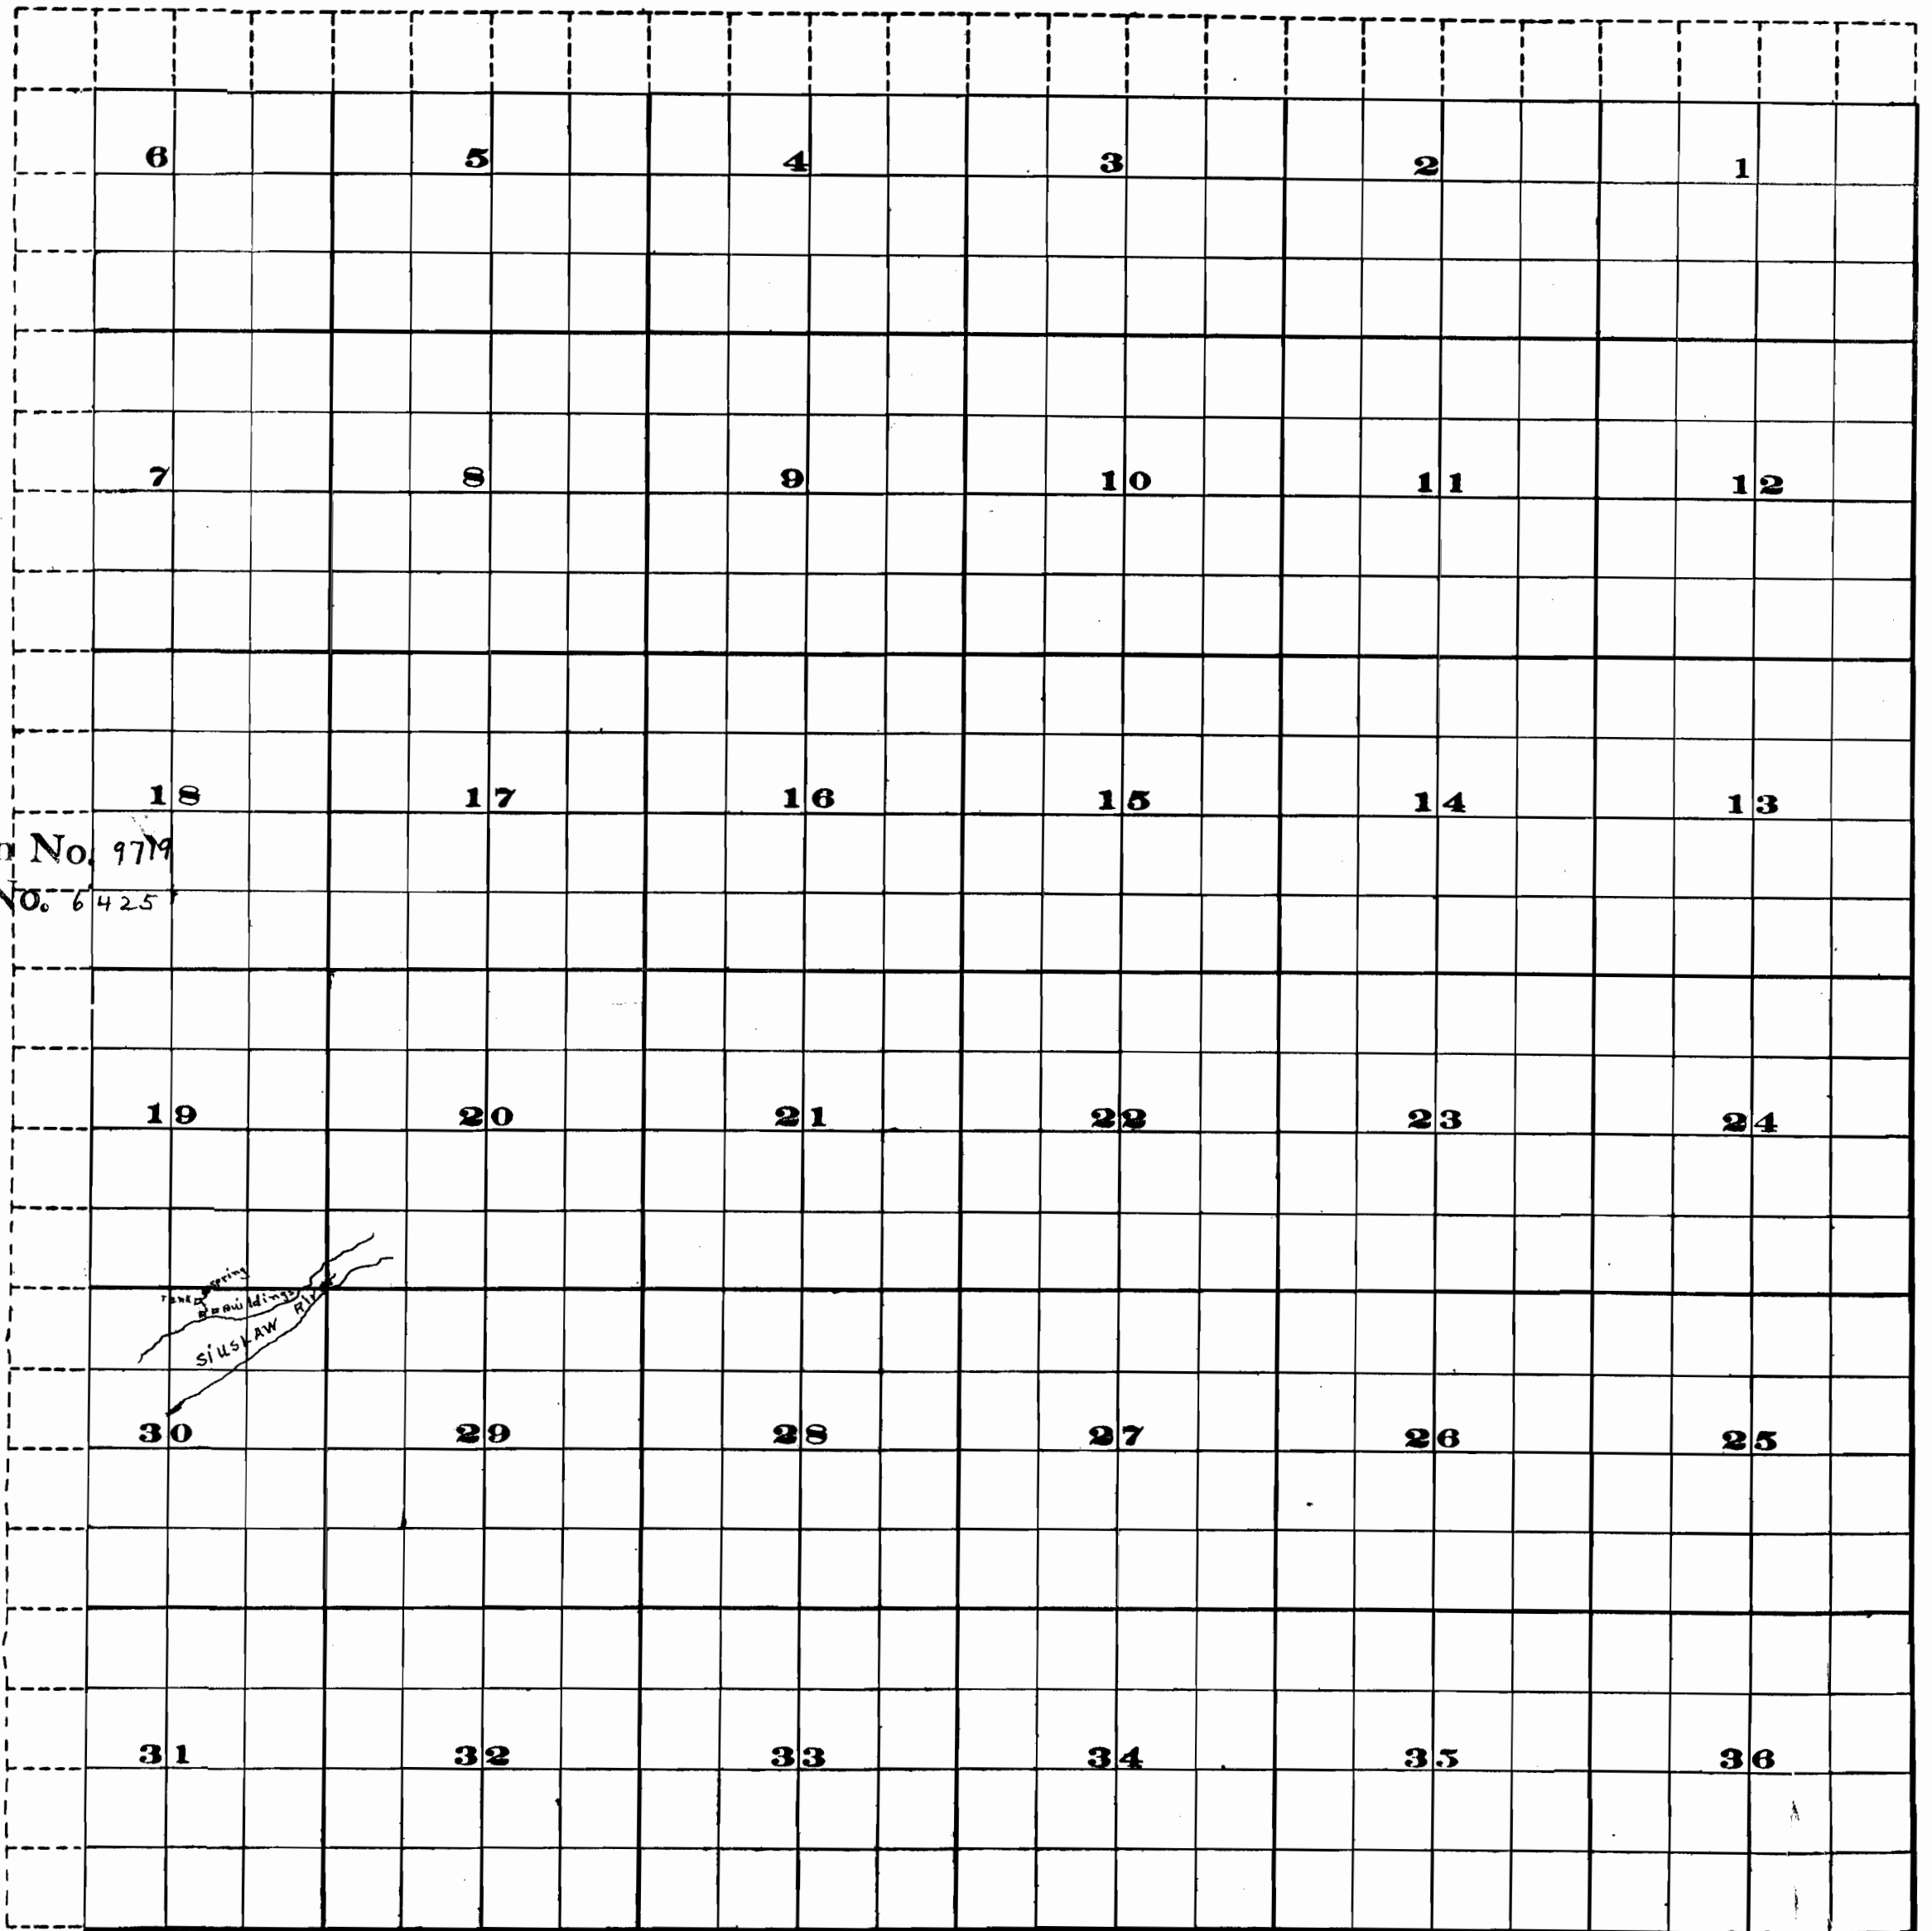

Application No. 97M
Permit No. 6425

