


P. B. HERMAN SUPPLEMENTAL RIGHT

T36S R6W

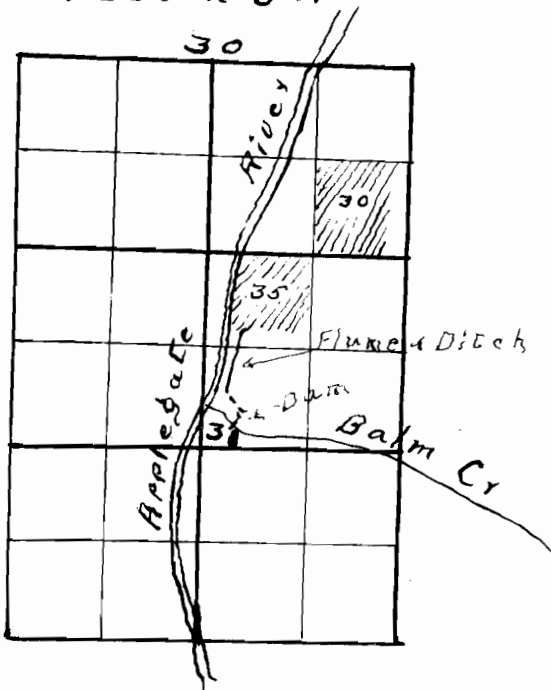

Registration No. 1772
Receipt No. 6479